


PLAT OF SURVEY

THREE PARCELS OF LAND LOCATED IN BLOCK "D" OF NORTH LAKE BEACH TRACT NO. 1, LOCATED IN SECTIONS 5 AND 8, TOWN 3 NORTH, RANGE 16 EAST, TOWN OF SUGAR CREEK, WALWORTH COUNTY, WISCONSIN.


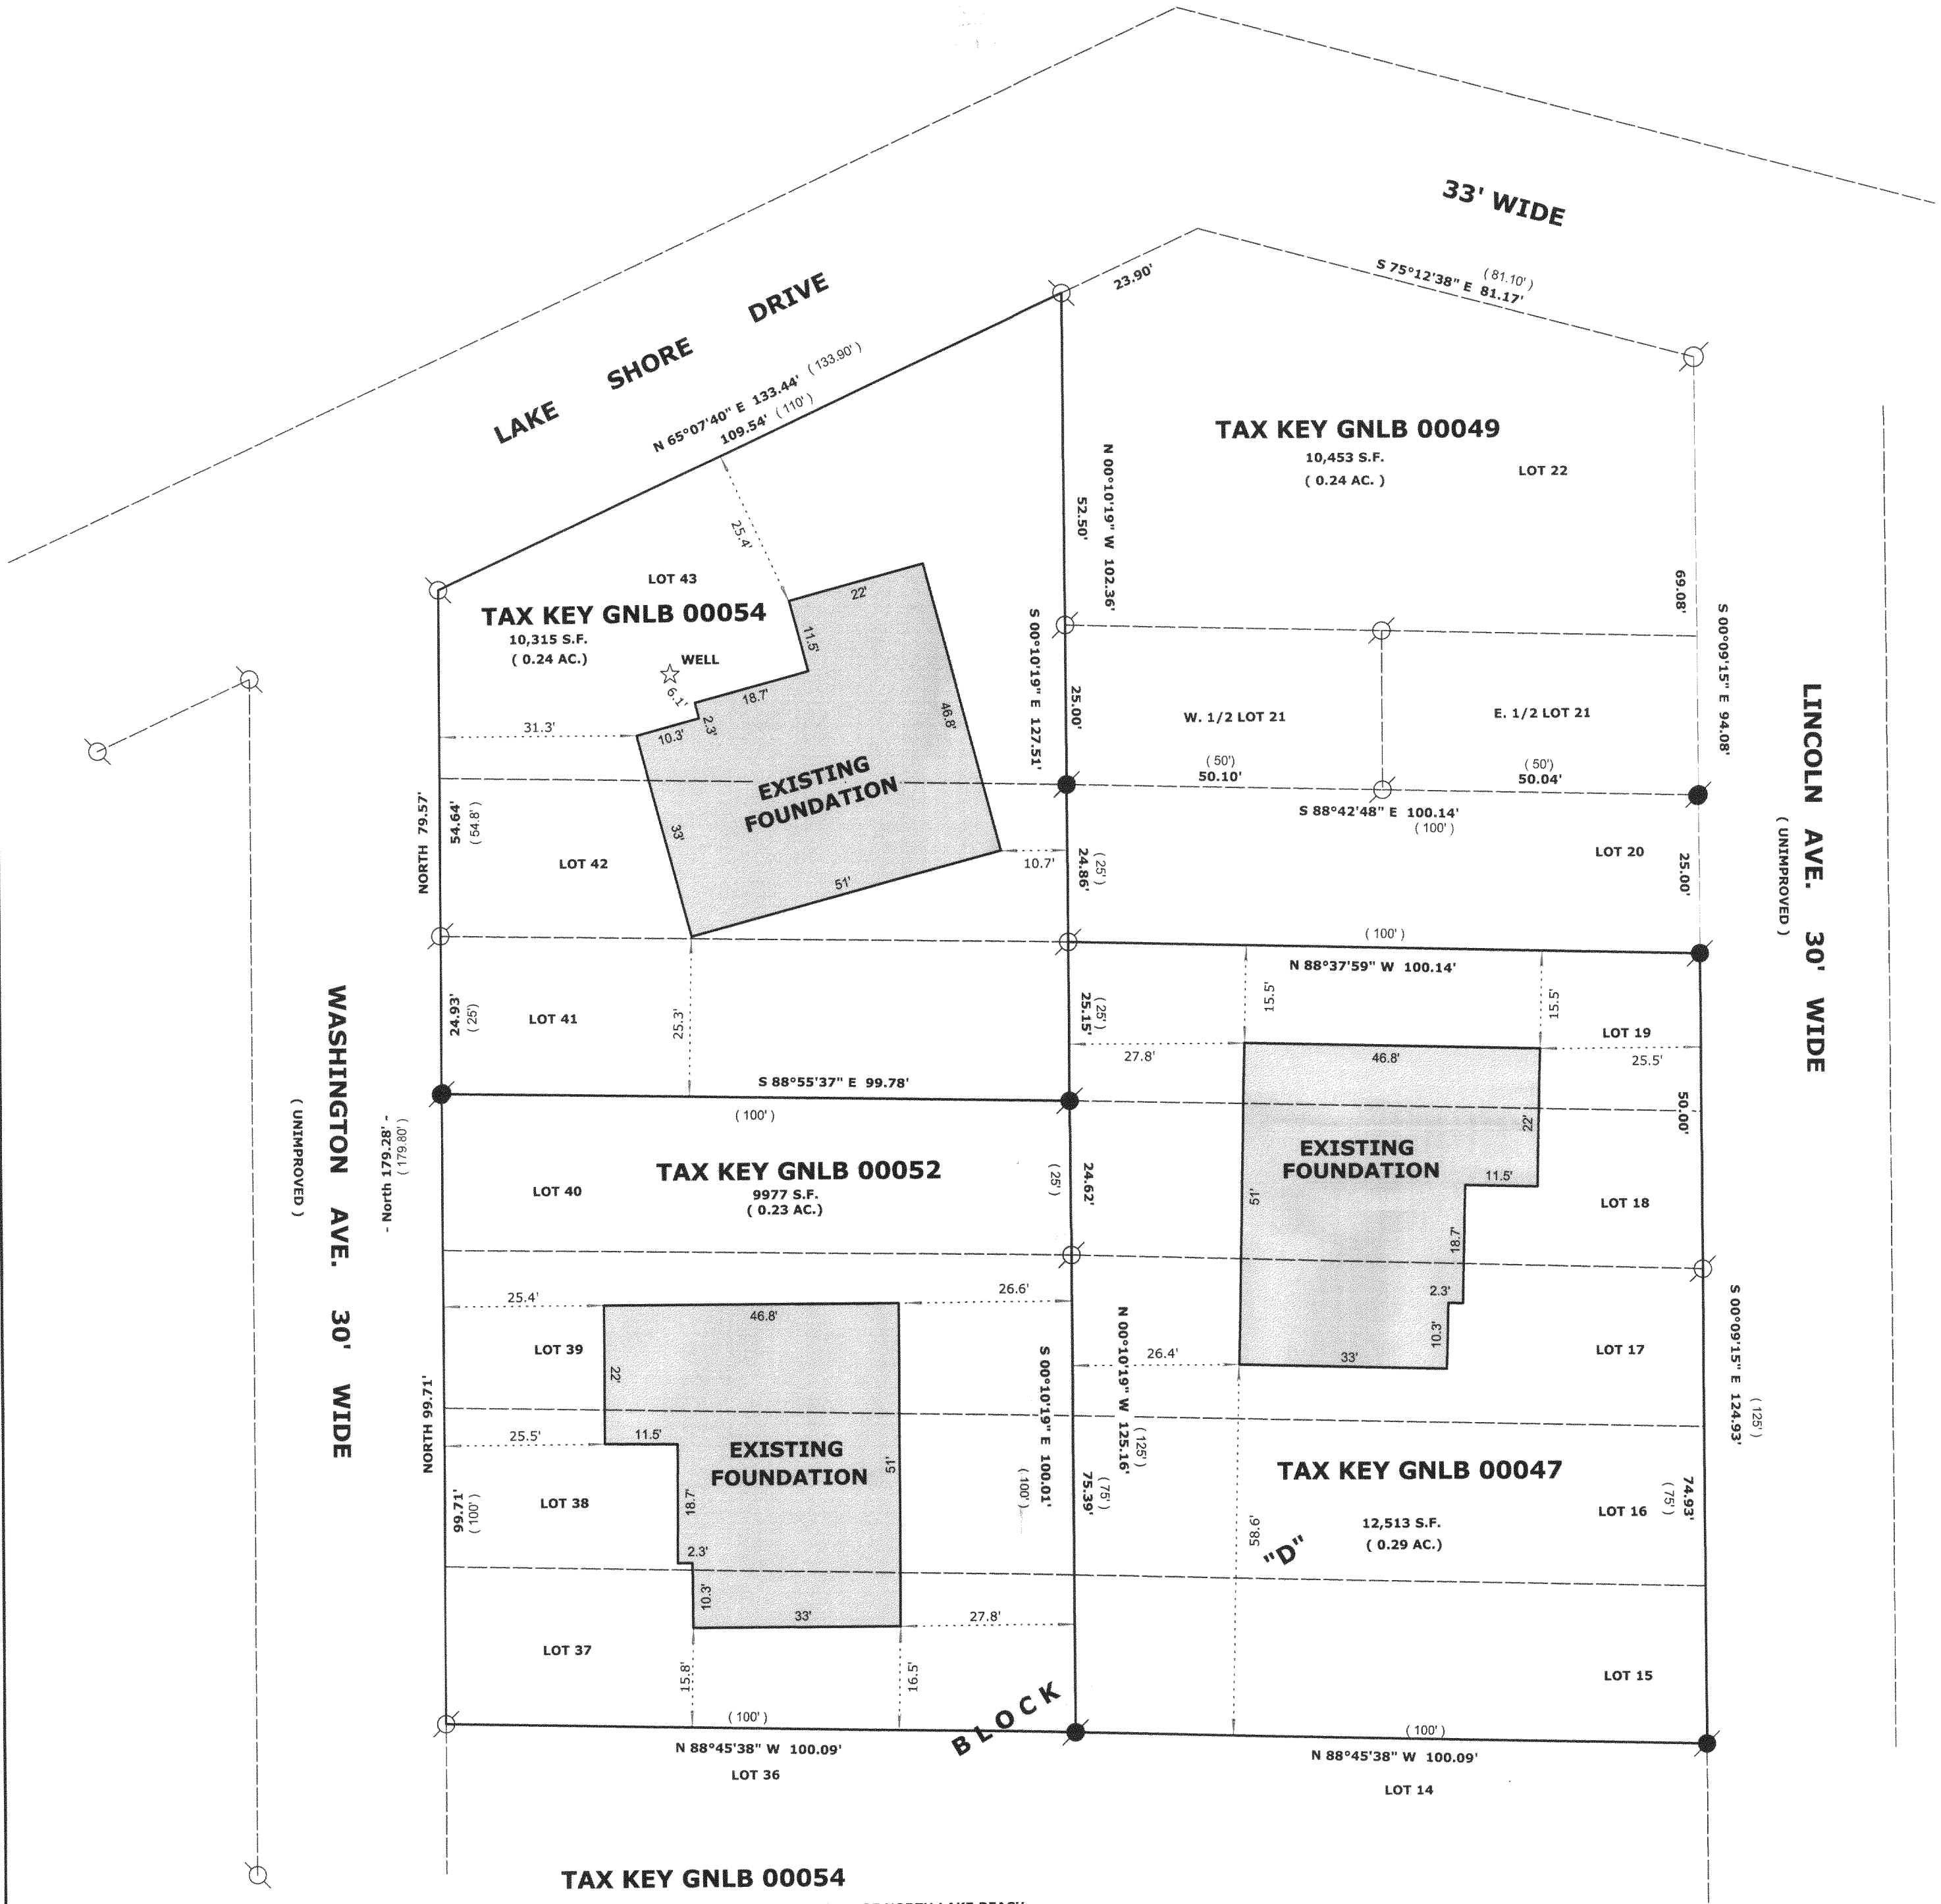


**TAX KEY GNLB 00054**  
LOTS 41 THRU 43 INCLUSIVE OF BLOCK D OF NORTH LAKE BEACH TRACT NO. 1, LOCATED IN SECTIONS 5 AND 8, TOWN 3 NORTH, RANGE 16 EAST, TOWN OF SUGAR CREEK, WALWORTH COUNTY, WISCONSIN.  
OWNER: MATTHEW WEIDENSEE  
508. E WISCONSIN ST.  
DELAVAN, WI. 53115

**TAX KEY GNLB 00052**  
LOTS 37 THRU 40 INCLUSIVE OF BLOCK D OF NORTH LAKE BEACH TRACT NO. 1, LOCATED IN SECTIONS 5 AND 8, TOWN 3 NORTH, RANGE 16 EAST, TOWN OF SUGAR CREEK, WALWORTH COUNTY, WISCONSIN.  
OWNER: NICHOLAS SIGMUND  
W6298 KETTLE MORRAINE DR.  
WHITEWATER, WI. 53190

**TAX KEY GNLB 00047**  
LOTS 15 THRU 19 INCLUSIVE OF BLOCK D OF NORTH LAKE BEACH TRACT NO. 1, LOCATED IN SECTIONS 5 AND 8, TOWN 3 NORTH, RANGE 16 EAST, TOWN OF SUGAR CREEK, WALWORTH COUNTY, WISCONSIN.  
OWNER: HICKORY WOODS, LLC  
2009 N. NEWHALL ST.  
MILWAUKEE, WI 53202

**BASIS FOR BEARINGS**  
THE EAST LINE OF WASHINGTON AVE. WAS ASSUMED TO BEAR NORTH TO MATCH EXISTING SURVEYS OF RECORD

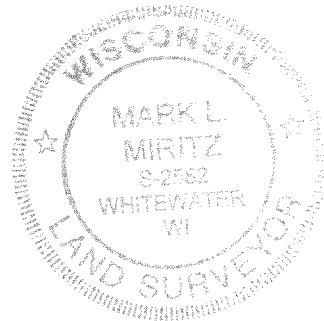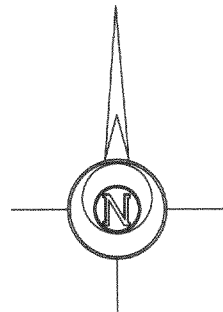

- LEGEND**
- FOUND IRON PIPE
  - FOUND IRON ROD
  - WOOD STAKE AT 10' BUILDING OFFSET
  - FOUND CONCRETE MONUMENT
  - CHISEL CUT IN CONCRETE
  - SET IRON ROD, 24" LONG, WEIGHING 1.5 LBS./LINEAL FT., 3/4" DIA.
  - RECORDED AS DIMENSION
  - EXISTING FENCE

SCALE: 1" = 20 FEET

"I hereby certify that the above described property has been surveyed by me or under my direction and that the above map is a true representation thereof and shows the size and location of the property, its exterior boundaries, the location of all visible structures and dimensions of all principal buildings thereon, boundary fences, apparent easements, roadways and visible encroachments, if any."  
\*This survey is made for the use of the present owners of the property, and also those who purchase, mortgage, or guarantee the title thereto within one year from date hereof."

MARK L. MIRITZ  
WISCONSIN REGISTERED  
LAND SURVEYOR S-2582

DATE: JUNE 27, 2005 JOB NO. 05.612

REVISED NOV. 17, 2005 TO SHOW FOUNDATIONS "AS BUILT"

GNLB-54 GNLB-47  
GNLB-52

316-1802