


AS-BUILT SURVEY

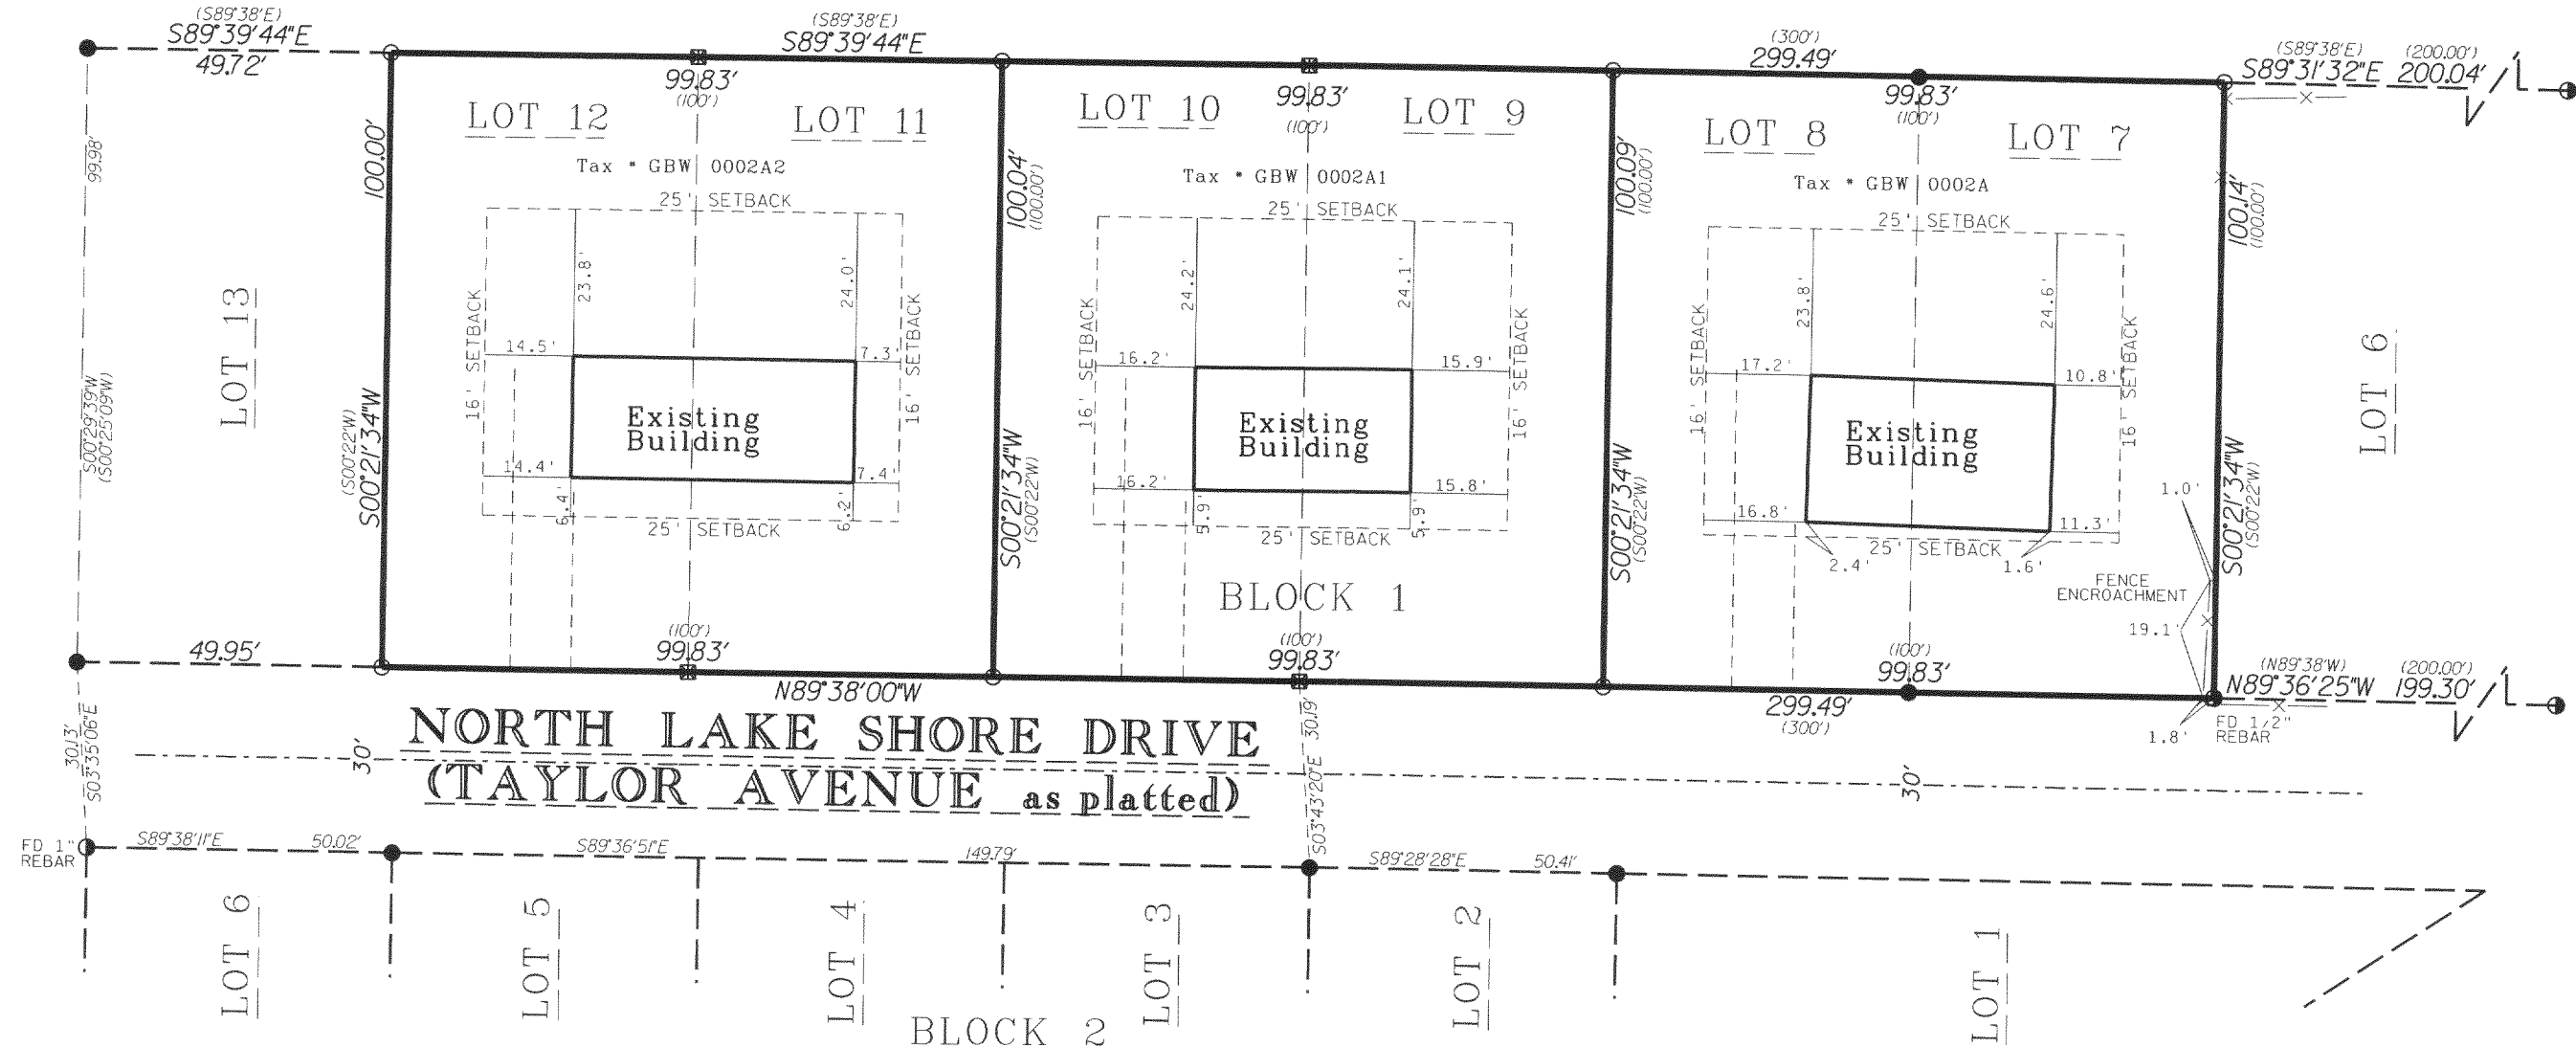

SURVEYORS CERTIFICATE

I, Mathew D. Reigel, Professional Land Surveyor, do hereby certify:
That I have surveyed and mapped this plat of survey.
That the information shown hereon is correct and
accurate to the best of my knowledge and belief.
That I have prepared this map for Mr. Frank Donohue
of RES Plus, Inc.

Dated this 24th day of March, 2006.


Mathew D. Reigel
Professional Land Surveyor, No. S-2321




LEGEND

- - FD 1" IRON PIPE
- - FD 3/4" REBAR
- - FD 2" IRON PIPE
- - SET 3/4" REBAR

0' 15' 30' 60'
SCALE 1" = 30'

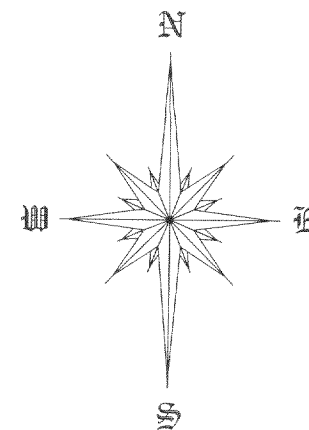

Bearings are referenced
to the South line of Block 1
recorded to bear N89°38'W
as per Blue Wing Estates plat.

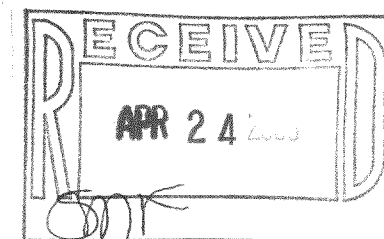

REIGEL
LAND
SURVEYING

7120 Park Shores Court
Middleton, Wisconsin 53562
Voice: 608-712-6757

reigellandsurveying@charter.net
C:\Projects\1056\1056asbuilt.dgn

GBW-2A2 GBW2A1 GBW2A

316-1831