



PREPARED FOR: SHOREWEST REALTORS
C/O NANCY KRAKOWSKY
830 E GENEVA ST.
DELAVER WI. 53115

PLAT OF SURVEY

- OF -

LOTS 36-40 BLOCK 116, LAKE WANDAWEGA SUBDIVISION,
LOCATED IN TOWN 3 NORTH, RANGE 16 EAST, WALWORTH
COUNTY, WISCONSIN.

PATHFINDER SURVEYING INC.
N3705 WILLOW BEND LANE
LAKE GENEVA WI. 53147
(262) 248-3697

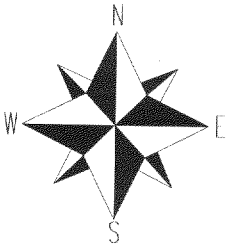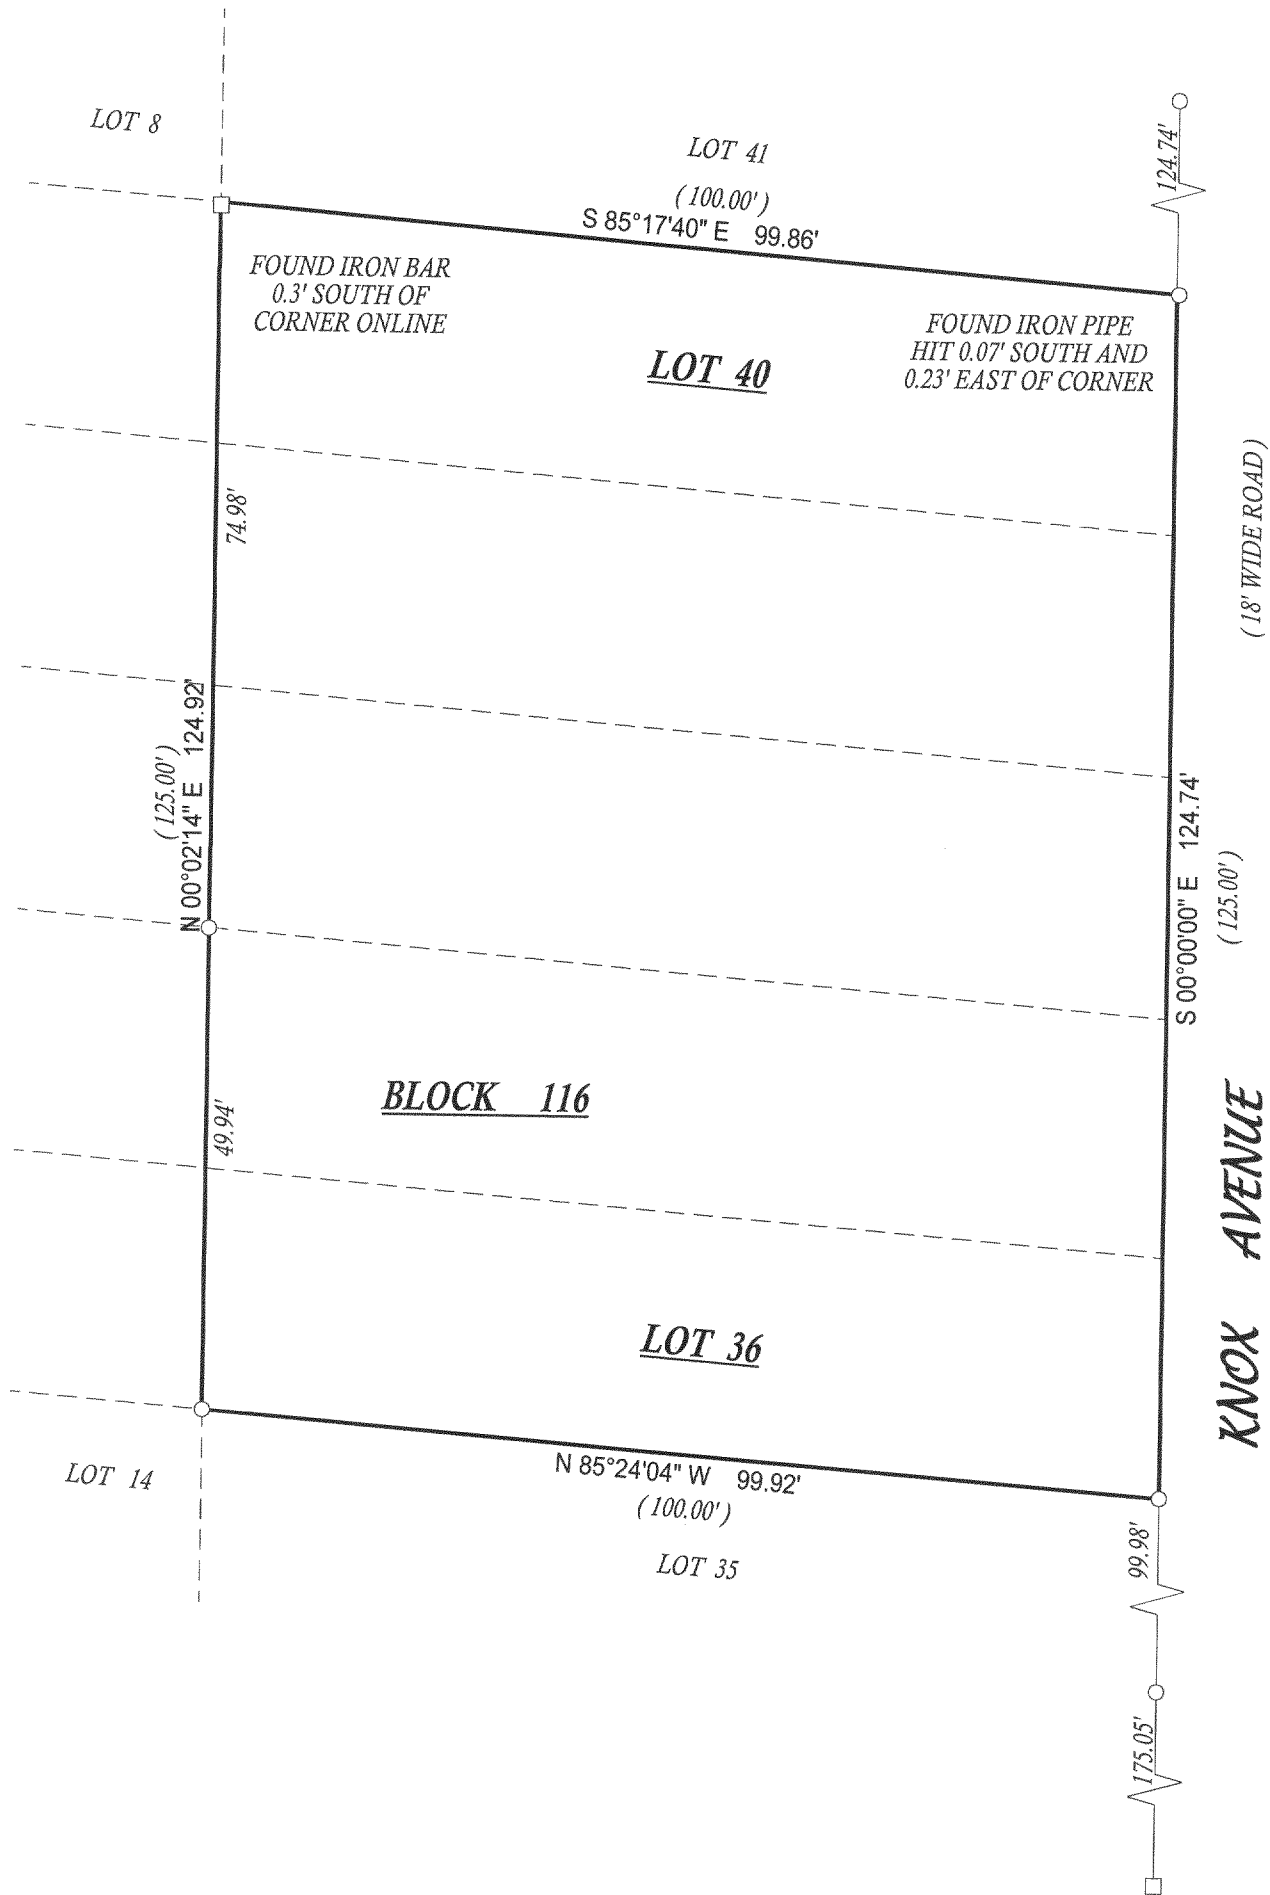


() = recorded as

□ = found iron bar

○ = found iron pipe

● = set iron pipe

■ = set iron bar

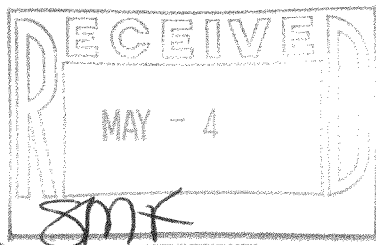


NOTE : BEARINGS ARE ASSUMED

COMPARE LEGAL DESCRIPTION ABOVE AND DRAWING WITH DEED. FOR BUILDING RESTRICTIONS AND
EASEMENTS NOT SHOWN, REFER TO DEED, ABSTRACT SOURCES AND LOCAL MUNICIPAL CODES. NOTIFY
THE SURVEYOR IMMEDIATELY OF ANY DISCREPANCY.

"I hereby certify that I have surveyed the above described property and that
the above map, to the best of my knowledge and belief, is a true representation
thereof and shows the size and location of all visible structures, apparent
easements and encroachments if any."

This survey is made for the present owners of the property, and those who
purchase, mortgage, or guarantee the title thereto, within one year from
the date hereof.

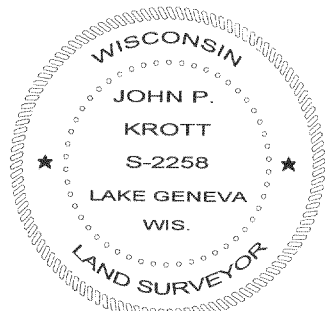

John P. Krott

JOHN KROTT S - 2258
Wisconsin Registered Land Surveyor
(original if signed in red)

DATED THIS THE 17th DAY OF FEBRUARY 2006.

GLW-345

316-1837