

# Plat of Survey

of



## Lots 26 through 31 of Block 1 of North Lake Shore Woods,

a subdivision located in the Southeast 1/4 of Section 5,  
Town 3 North, Range 16 East, Town of Sugar Creek,  
Walworth County, Wisconsin.


Surveyed for: **Welcome Homes**  
6300 South Highway 51  
Janesville, Wisconsin. 53546

MAY 11 2005  
DGO

Survey Date: October 5, 2005  
Revisions:

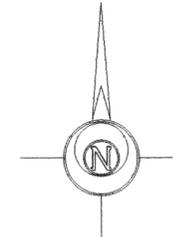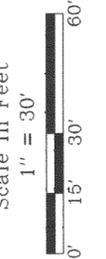


Bearings reference to the plat  
of North Lake Shore Woods.

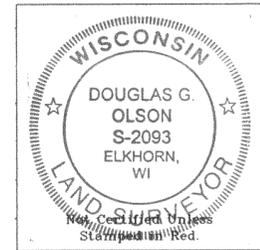

**Notes:**

- 1) This survey is subject to Wisconsin lien laws. This Plat of Survey is the notice of intent to file lien. Lien waiver required.
- 2) This survey plat is not certified unless signed and sealed in red ink.

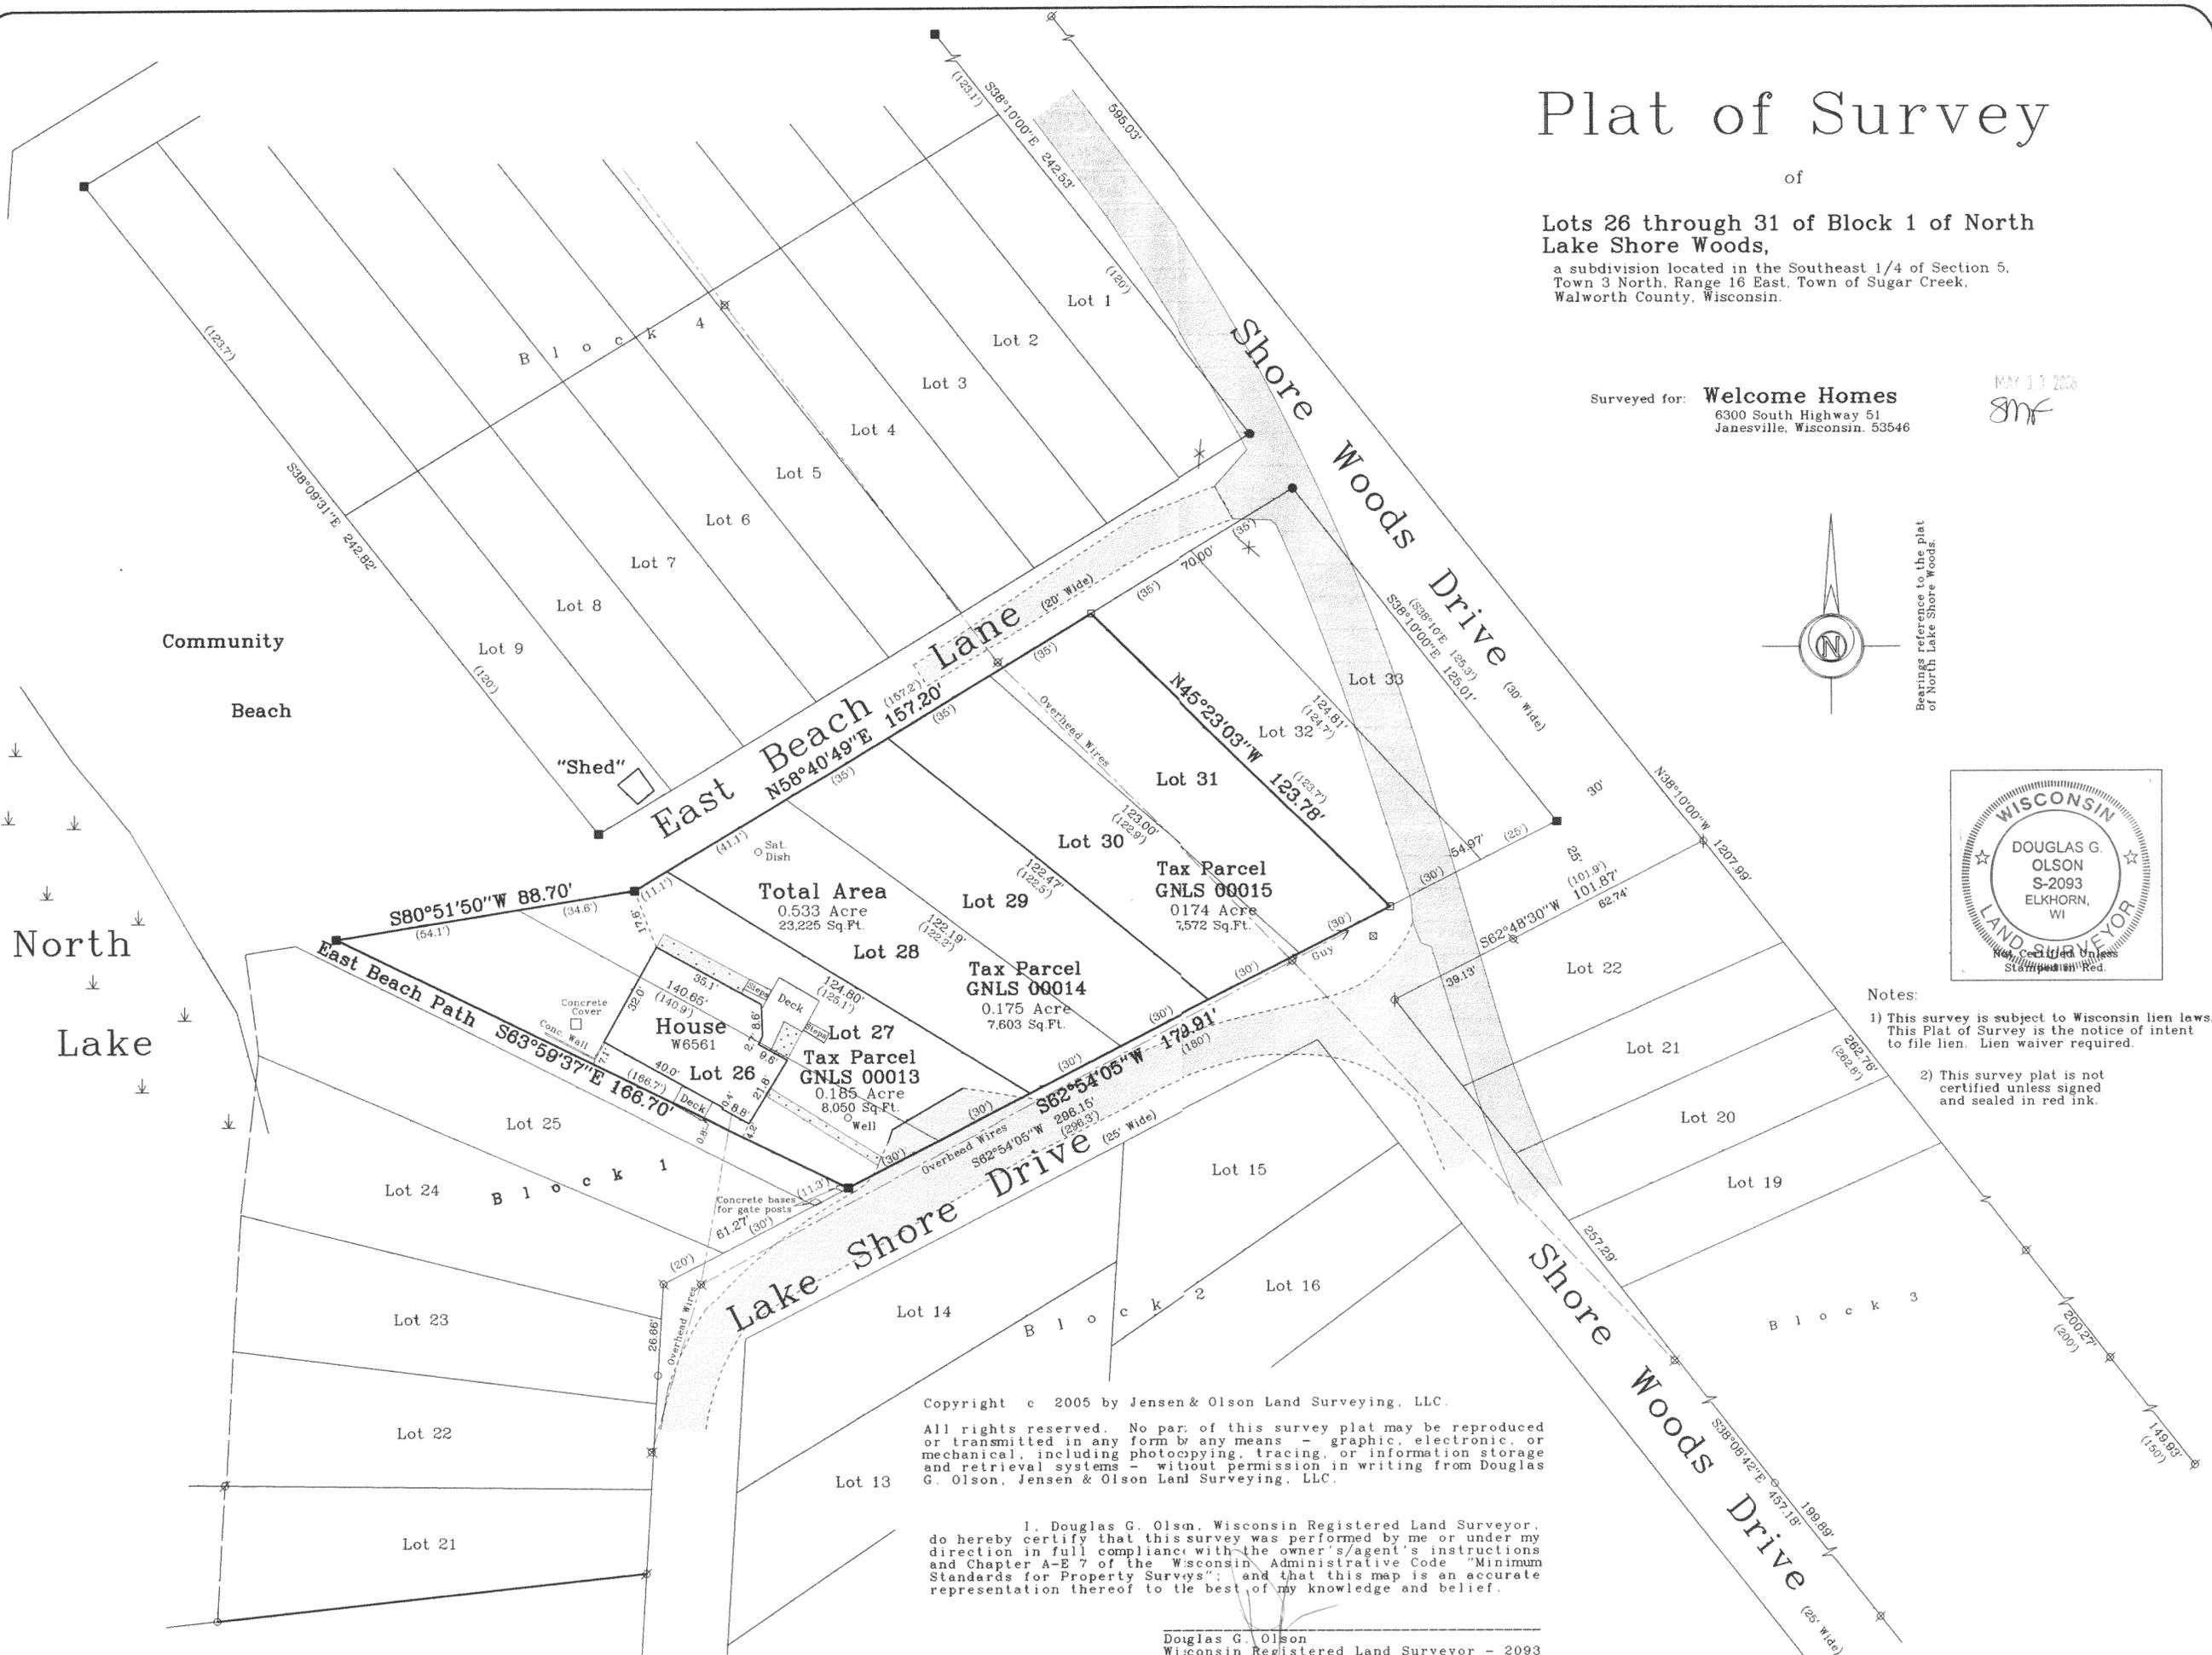

Copyright © 2005 by Jensen & Olson Land Surveying, LLC.

All rights reserved. No part of this survey plat may be reproduced or transmitted in any form by any means - graphic, electronic, or mechanical, including photocopying, tracing, or information storage and retrieval systems - without permission in writing from Douglas G. Olson, Jensen & Olson Land Surveying, LLC.

I, Douglas G. Olson, Wisconsin Registered Land Surveyor, do hereby certify that this survey was performed by me or under my direction in full compliance with the owner's/agent's instructions and Chapter A-E 7 of the Wisconsin Administrative Code "Minimum Standards for Property Surveys"; and that this map is an accurate representation thereof to the best of my knowledge and belief.

Douglas G. Olson  
Wisconsin Registered Land Surveyor - 2093

**Jensen & Olson Land Surveying, LLC**  
45 South Wisconsin Street  
Elkhorn, Wisconsin. 53121  
Telephone (262) 723-3434  
Facsimile (262) 723-8044

- Legend**
- Found Iron Pipe 3/4" dia.
  - Found Iron Rod 1/2" dia.
  - Set Iron Rod 1/2" dia.
  - Recorded Information 3/4" dia.
  - Utility Pole
  - Asphalt Surface
  - Concrete

Sheet 1 of 1 Sheets  
Job Reference Number  
**2005.131**

2005.131

GNL5-13

316-1842