



Plat of Survey

SURVEYORS CERTIFICATE
STATE of WISCONSIN)
COUNTY of DANE) ss.

Royal Oak Engineering, Inc.

5610 Medical Circle, Suite 6
Madison, Wisconsin 53719
Phone (608) 274-0500
Fax (608) 274-4530


I hereby certify that this survey is in compliance with A-E 7 of Wisconsin Administrative Code.

I further certify that I have surveyed and mapped the lands described hereon, and that this map is a correct representation in accordance with the information furnished.



Richard L. Palmer

Richard L. Palmer, Professional Land Surveyor, S-2160

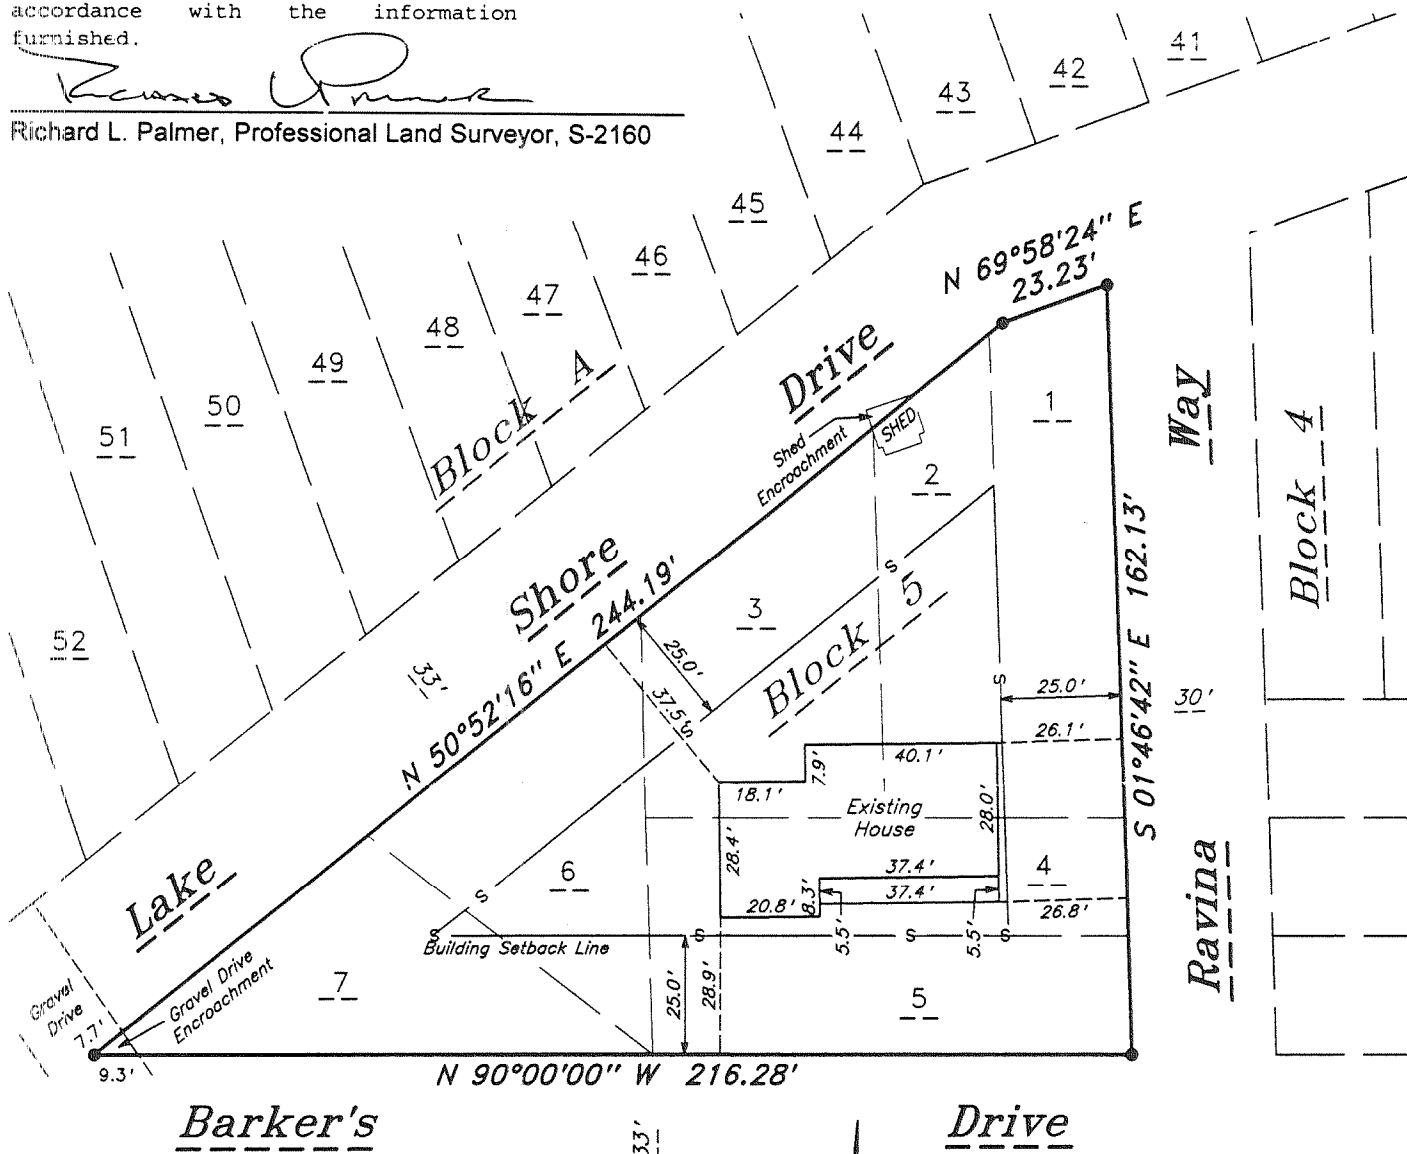

LEGEND

Scale 1 inch = 40 feet

- 1" O.D. Iron Pipe Found
- 1" X 24" Iron Pipe Driven
- Min. Wt. 1.13 #/ln. ft.


() Recorded As

Surveyed By JP-TT
Drawn By JP
Checked By RLP
Approved By RLP
Date of Survey June, 22, 2006
Field Book Trimble TSCE
Dir/data2/walworth/sugarcreek
Dir cont. /section05
Data Level(s) PLAT
File Name 15557

Office Map No. 15557
Sheet 1 of 1 Sheet(s)

North as referenced to the
Northerly right-of-way
of Barker's Drive, bearing
assumed N 90°00'00" W.

0 20 40 80
Scale 1" = 40'

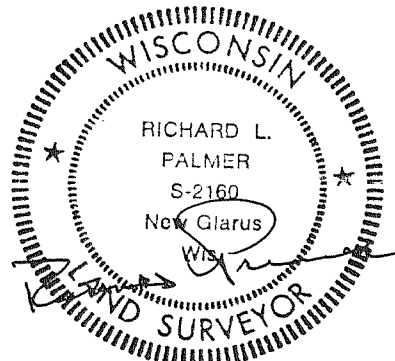

June 26, 2006

FOR: Steve Harrison
ADDRESS: 594 Powers Street
Palmyra, WI 53156

DESCRIPTION-LOCATION: Lots 1 thru 7, Block 5, North Lake Beach Tract
No. 3, lying in the SE 1/4 of the SE 1/4 of Section 05, T03N, R16E, Town of
Sugar Creek, Walworth County, Wisconsin

GNLB3-367

316-1852