

LAND-MARK SURVEYING
Mark L. Miritz

Wisconsin Registered Land Surveyor S-2582


N9330 Knuteson Drive
 Whitewater, WI 53190
 Phone: (262) 495-3284
 FAX: (262) 495-8421
 LAND-MARKSURVEYING.COM

PLAT OF SURVEY

LOTS 18 - 22 OF BLOCK 3 OF NORTH LAKE
 SHOREWOODS SUBDIVISION, LOCATED IN
 TOWN 3 NORTH, RANGE 16 EAST, WALWORTH
 COUNTY, WISCONSIN.

ORDERED BY: TINCHER REALTY, INC.
 514 W. MAIN ST.
 WHITEWATER, WI. 53190

OWNER: DALE E. REICH
 W6542 N. LAKE SHORE DR.
 ELKHORN, WI. 53121

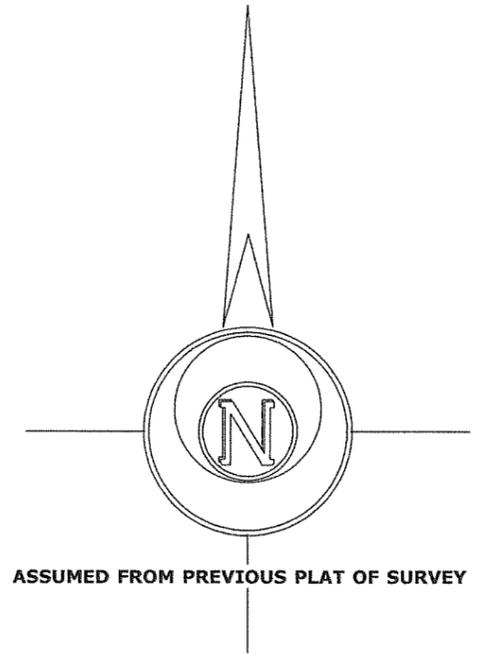

LEGEND


- FOUND IRON PIPE
- FOUND IRON ROD
- FOUND COUNTY MONUMENT
- FOUND CONCRETE MONUMENT
- CHISEL CUT IN CONCRETE
- SET IRON ROD, 24" LONG, WEIGHING 1.5 LBS./LINEAL FT., 3/4" DIA.
- RECORDED AS DIMENSION
- EXISTING FENCE

SCALE: 1" = 30 FEET

"I hereby certify that the above described property has been surveyed by me or under my direction and that the above map is a true representation thereof and shows the size and location of the property, its exterior boundaries, the location of all visible structures and dimensions of all principal buildings thereon, boundary fences, apparent easements, roadways and visible encroachments, if any."
 "This survey is made for the use of the present owners of the property, and also those who purchase, mortgage, or guarantee the title thereto within one year from date hereof."

Mark L. Miritz
MARK L. MIRITZ
 WISCONSIN REGISTERED
 LAND SURVEYOR S-2582

DATE: MARCH 12, 2006 JOB NO. 06.302

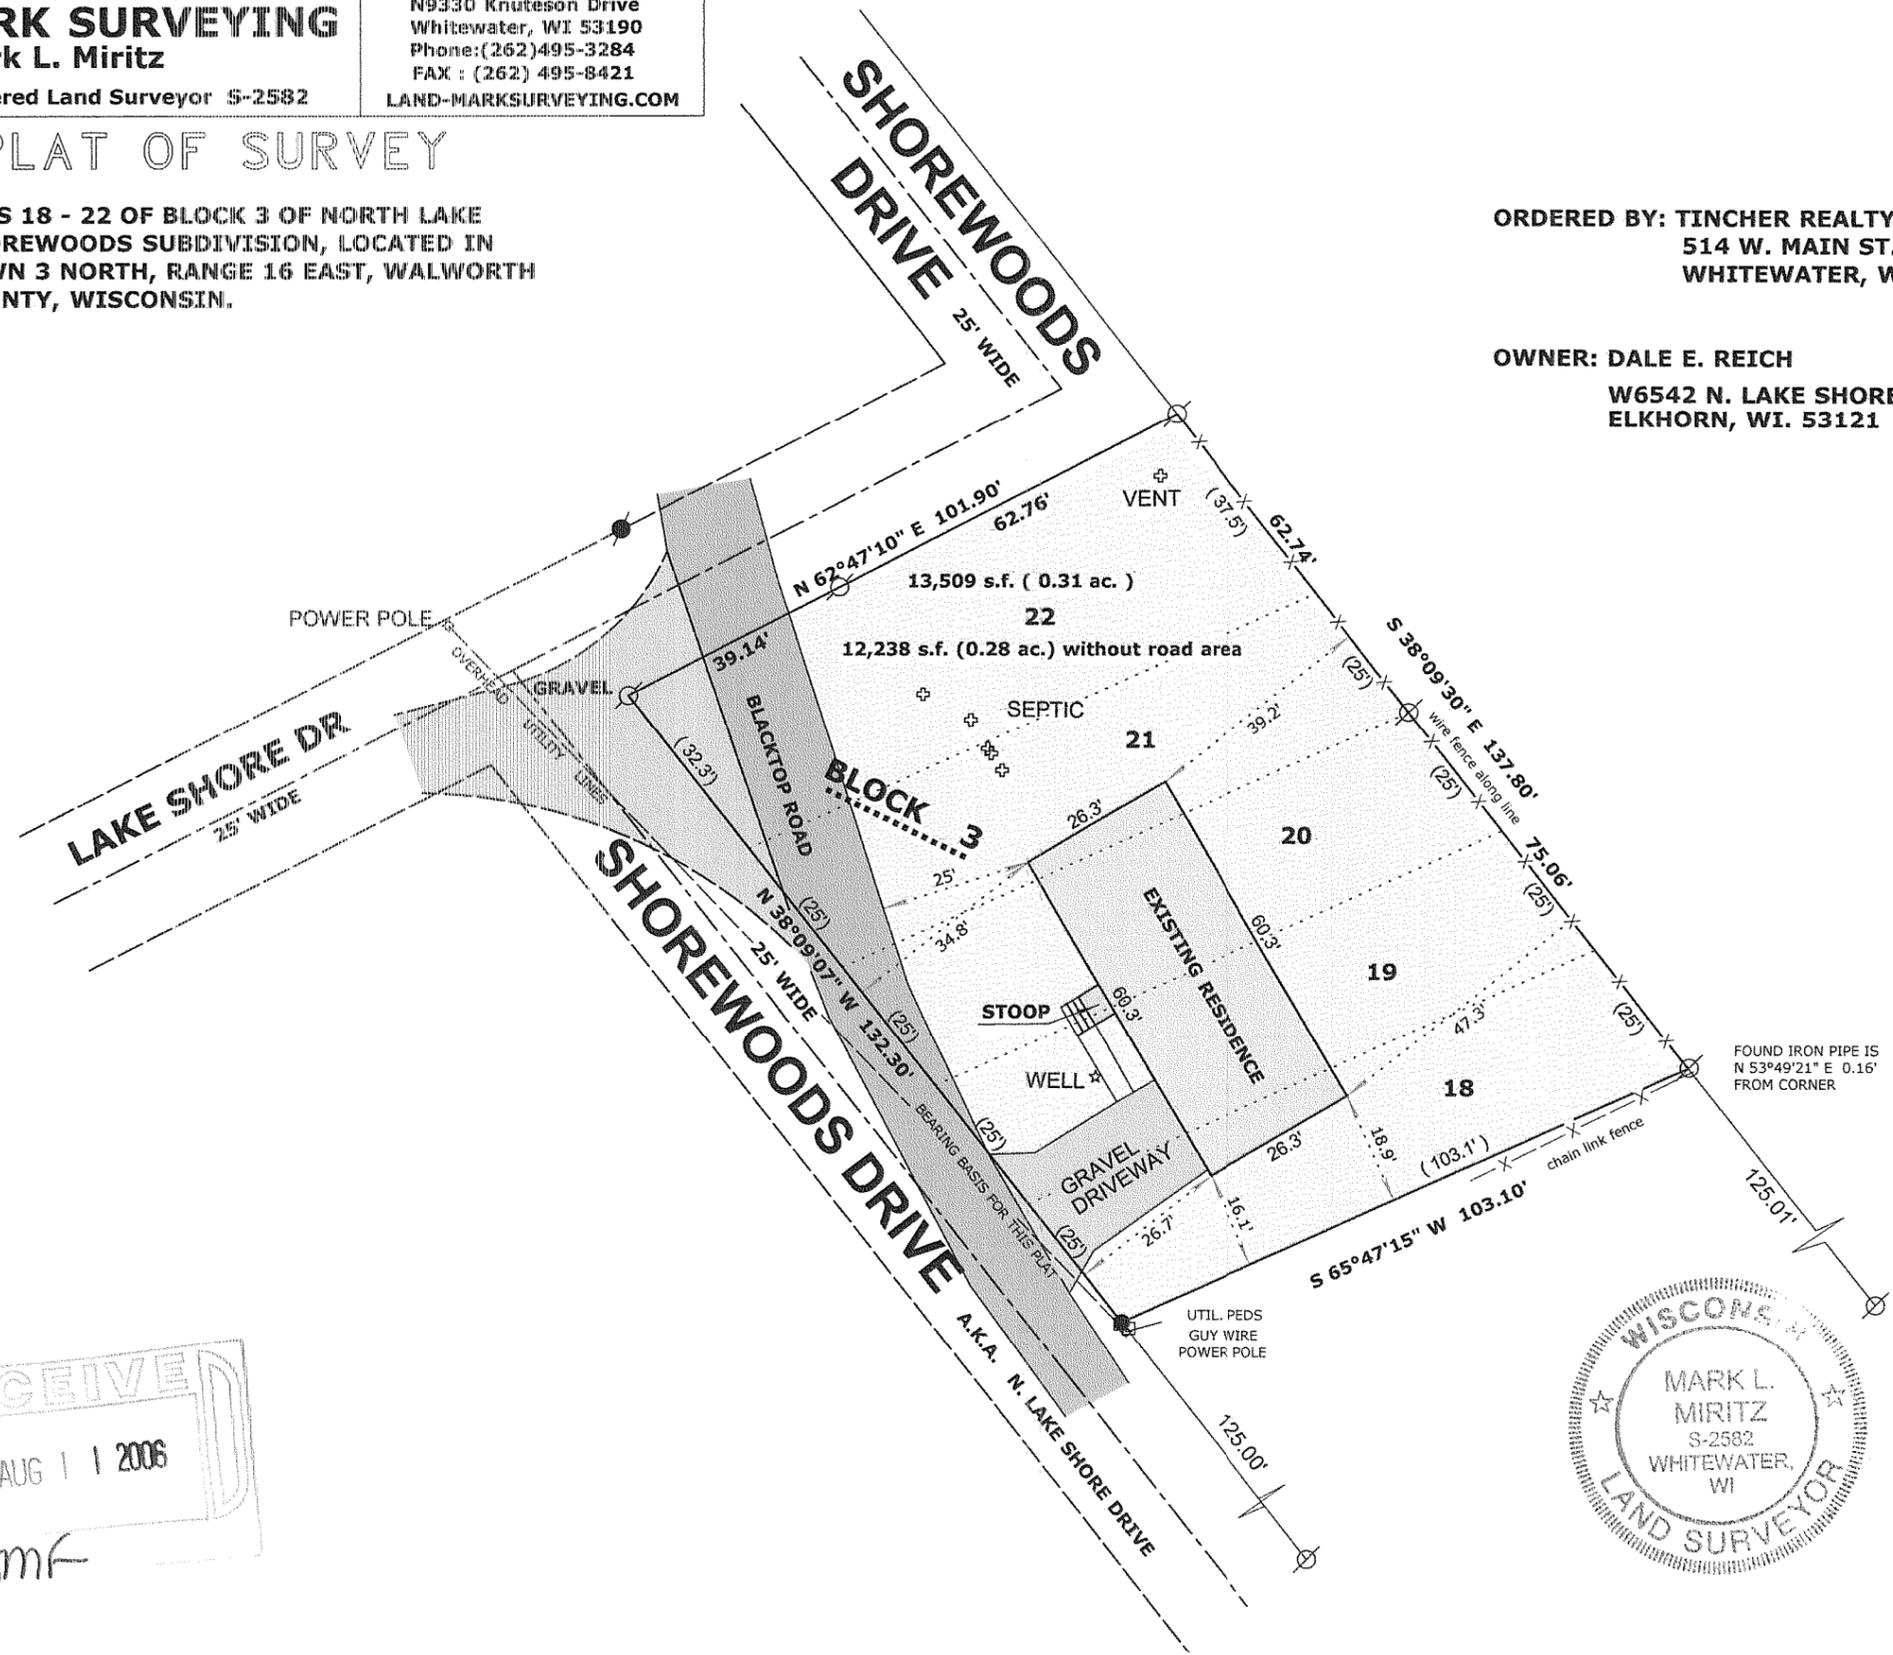

RECEIVED
 AUG 1 | 2006
 smf



GNLS - 28

316-1859