

A parcel of land located in the Northeast  $\frac{1}{4}$  of Section 11, Town 3 North, Range 16 East, Walworth County, Wisconsin, described as follows: Beginning at an iron pipe marking the Southwest corner of Block 5, Lake Wandawega Highlands; said pipe lies 3,182.069 feet North and 91.251 feet West of the Southwest corner of Section 12; thence North  $29^{\circ}20'00''$  West along the West line of said Block 5, 600.00 feet to an iron pipe; thence South  $57^{\circ}36'59''$  West along the South line of Lot 19 of said Block 4, 258.00 feet to an iron pipe; thence North  $29^{\circ}21'13''$  West, along the West line of said Lot 19, 355.80 feet to an iron pipe; thence North  $83^{\circ}57'06''$  West along the South line of Akwenasa Trail, 517.15 feet to an iron pipe; thence South  $29^{\circ}20'33''$  East along the East line of Interlaken Subdivision, 1,219.57 feet to the centerline of County Trunk Highway "A"; thence North  $56^{\circ}53'41''$  East along the centerline of said road, 100.81 feet;

thence North  $57^{\circ}38'03''$  East, 633.01 feet; thence North  $29^{\circ}20'00''$  West, 33.05 feet to the point of

beginning, parcel contains 15.778 acres.

Also a parcel of land in said Section 11, described as follows: Lots 6, 7, 8, and 9 of Block 2, Lake Wandawega Highlands 1st Addition being 4.357 acres of land.

The above described property has been


surveyed under my direction and the above map

is a true representation thereof and shows the

size and location of the property to the best

of my knowledge and ability.

Thomas P.A. Jensen  
Registered Land Surveyor No. S-1084

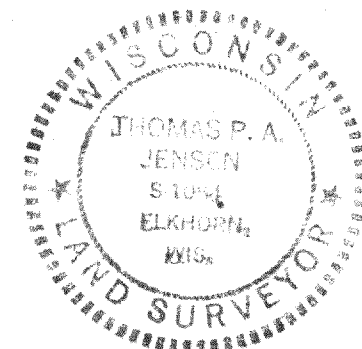

SURVEY FOR: PETE KOUZES

## PLAT OF SURVEY OF

LAND LOCATED IN THE NORTHEAST  $\frac{1}{4}$  OF SECTION 11, TOWN 3 NORTH, RANGE 16 EAST, WALWORTH COUNTY, WISC. BEING PART OF THE GILBERT ESTATE

SURVEYOR

SCALE 1" = 100'

DATE MAY 30, 1976

