

# LAND-MARK SURVEYING

Mark L. Miritz

Wisconsin Registered Land Surveyor S-2582

N9330 Knuteson Drive  
Whitewater, WI 53190  
Phone: (262) 495-3284  
FAX: (262) 495-8421  
LAND-MARKSURVEYING.COM


## PLAT OF SURVEY

LOT 28 OF STRAWBERRY BANKE PLANTATION ADDITION NO. 1,  
LOCATED IN TOWN 3 NORTH, RANGE 16 EAST, WALWORTH COUNTY,  
WISCONSIN.

ORDERED BY: BECKY MERWIN  
RAULAND AGENCY  
118 KENOSHA ST.  
WALWORTH WI. 53184


OWNERS: DOUGLAS J. and JENNIFER L. OOMENS  
W5117 STRAWBERRY HILL ROAD  
ELKHORN, WI. 53121

## STRAWBERRY HILL ROAD

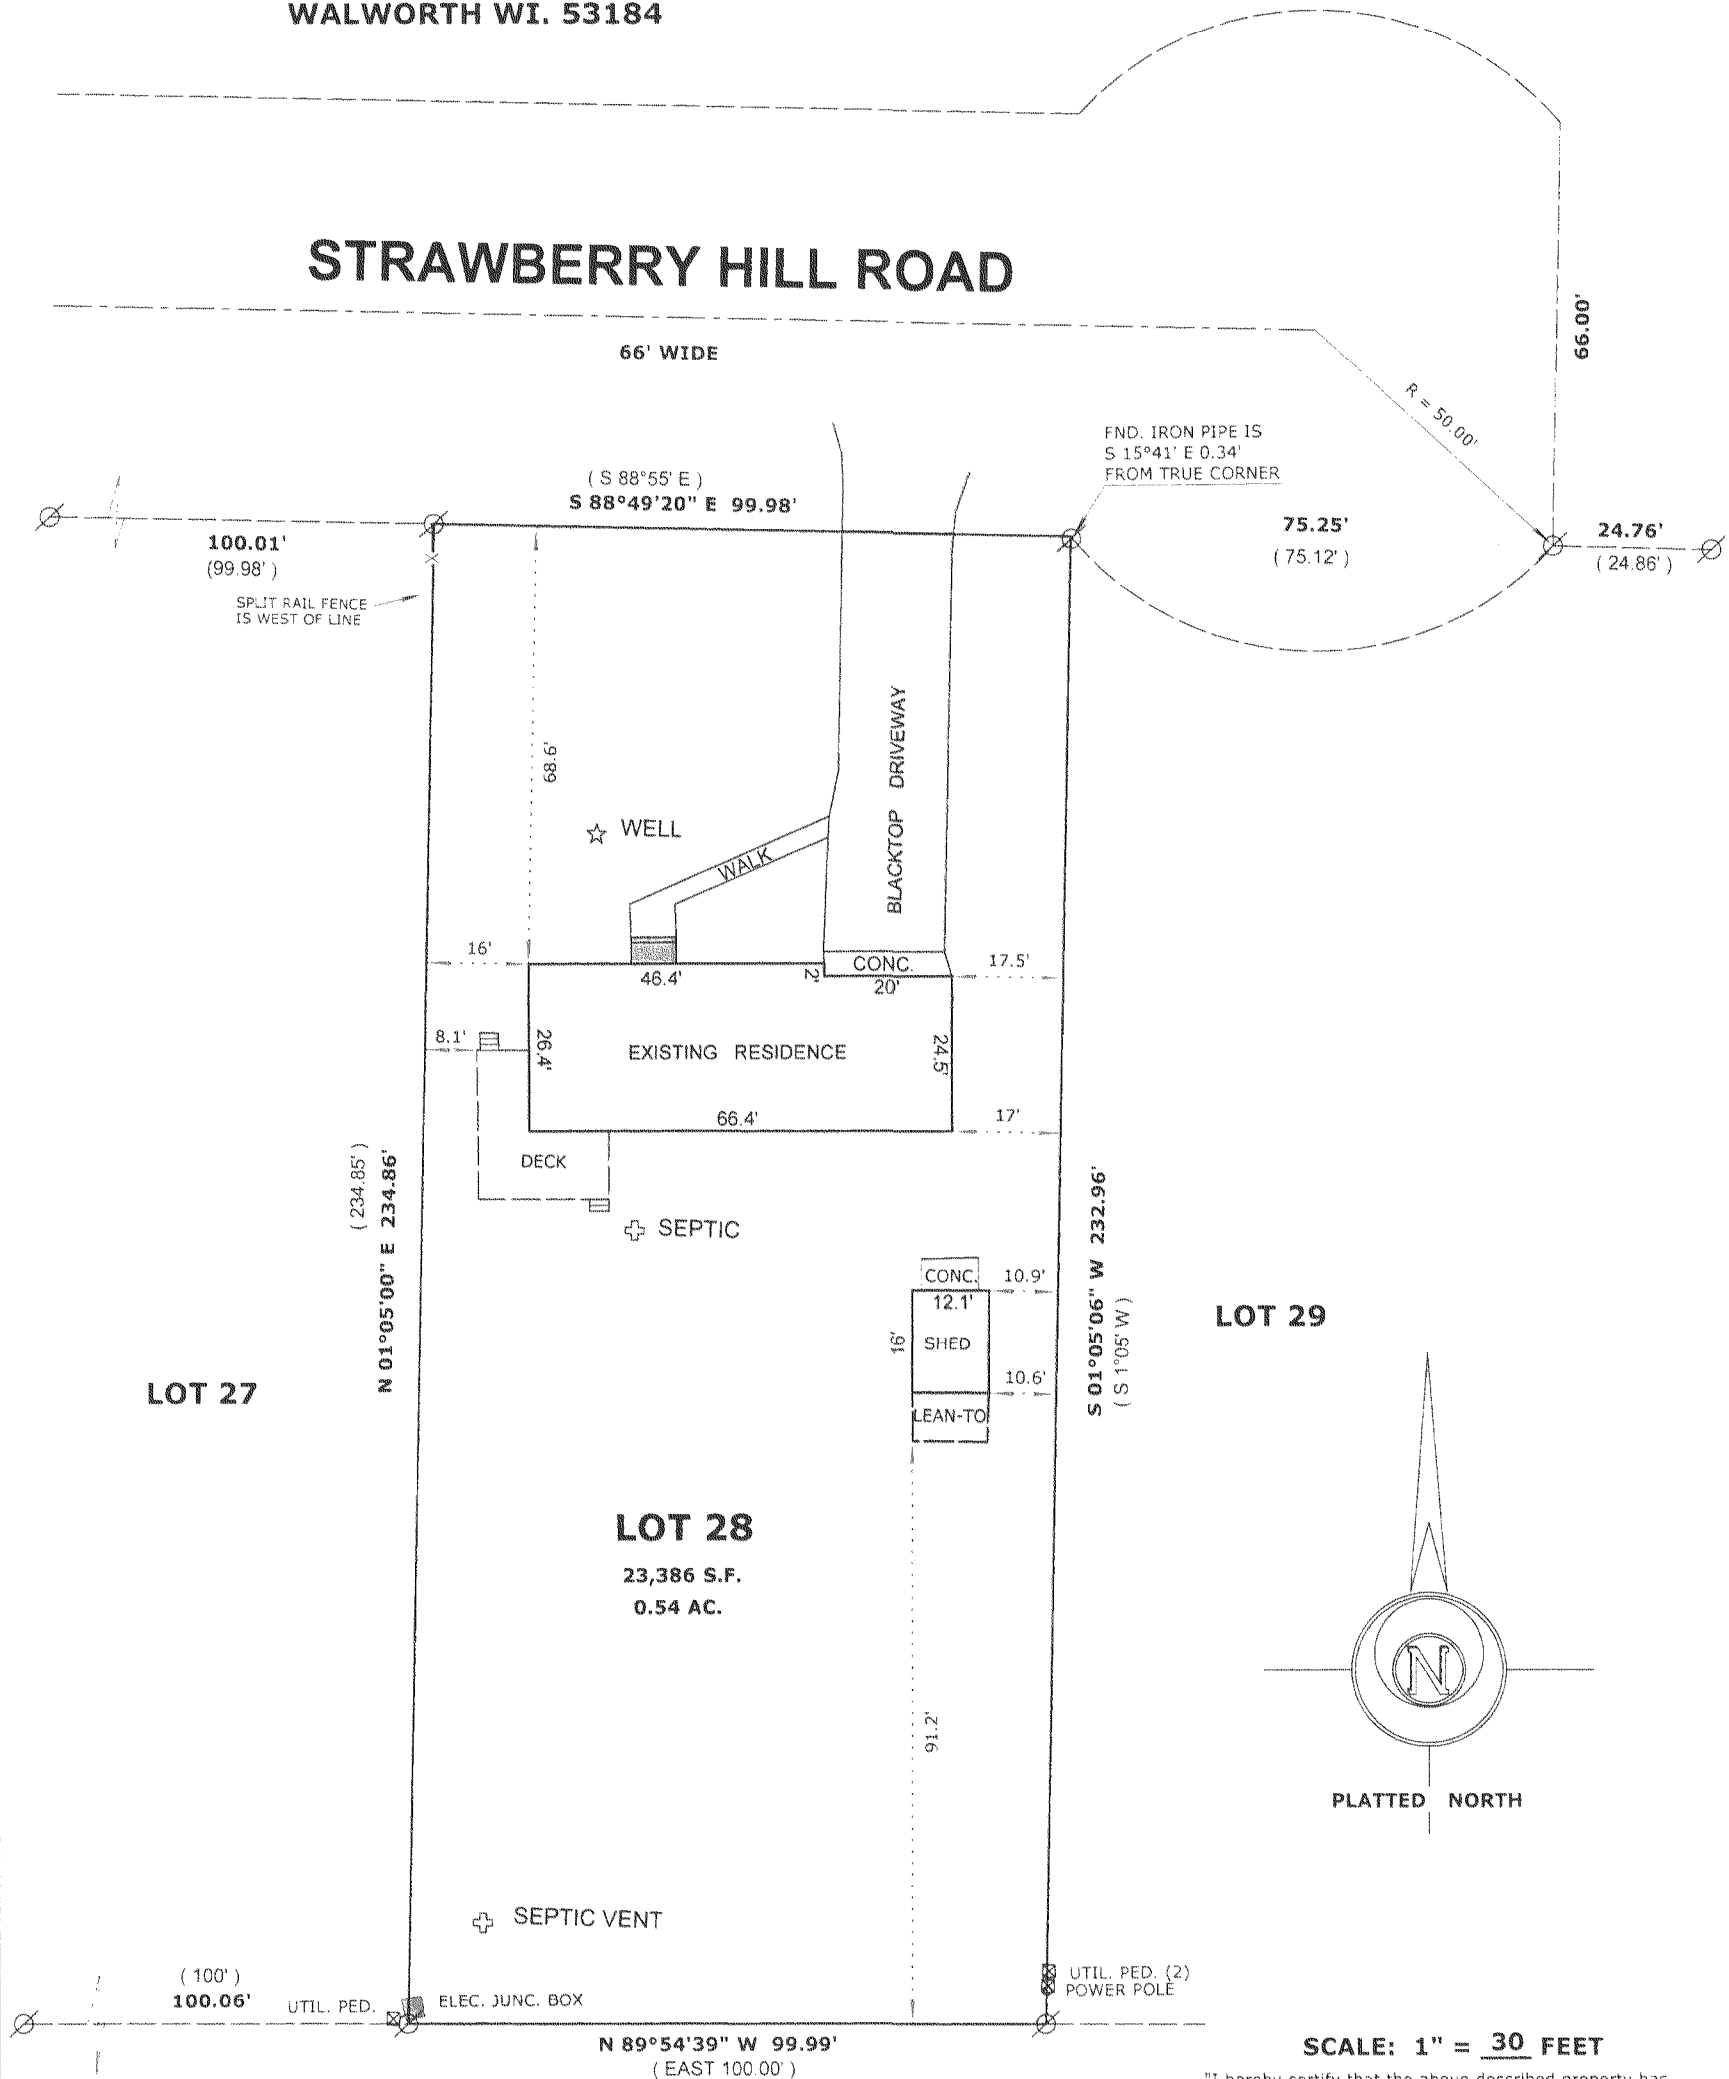

### LEGEND

- FOUND IRON PIPE
- FOUND IRON ROD
- UNDERGROUND UTILITY PEDESTAL
- FOUND CONCRETE MONUMENT
- CHISEL CUT IN CONCRETE
- SET IRON ROD, 24" LONG, WEIGHING 1.5 LBS./LINEAL FT., 3/4" DIA.
- RECORDED AS DIMENSION
- EXISTING FENCE

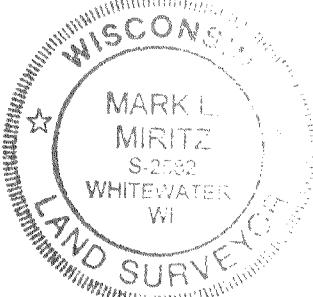

SCALE: 1" = 30 FEET

"I hereby certify that the above described property has been surveyed by me or under my direction and that the above map is a true representation thereof and shows the size and location of the property, its exterior boundaries, the location of all visible structures and dimensions of all principal buildings thereon, boundary fences, apparent easements, roadways and visible encroachments, if any."

"This survey is made for the use of the present owners of the property, and also those who purchase, mortgage, or guarantee the title thereto within one year from date hereof."

MARK L. MIRITZ  
WISCONSIN REGISTERED  
LAND SURVEYOR S-2582

DATE: AUG. 29, 2006 JOB NO. 06.816

GSPA - 28

316 - 1876