

Plat of Survey


of

Lot 75 of Baywood Estates 3rd Addition,

a subdivision located in the Northwest 1/4 of Section 1, Town 3 North, Range 16 East, Town of Sugar Creek, Walworth County, Wisconsin.

Surveyed for: **Mike Schmieden**
W5172 Hawkhunter Road
Elkhorn, Wisconsin. 53121

Haresfoot Road
(66' Wide)

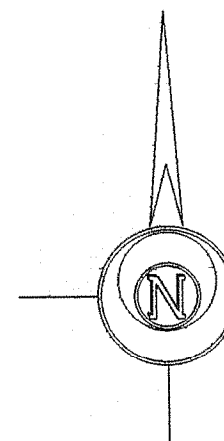

Scale in Feet
1" = 20'
0' 10' 20' 40'

Arc=57.63'
Radius=418.00', Chord=N86°08'42"W 57.58'
(N86°07'33"W 57.50')

(N82°09'40"W)
N82°12'07"W 75.68'

Lot 75
0.491 Acre
21,394 Sq.Ft.

Poured Concrete Foundation
House Under Construction

N1°33'53"E 155.03'
(N1°35'18"E 154.94')

Lot 74

House
W5125

S87°46'05"E 133.11'
(133.00')

Lot 78


Lot 79

Copyright © 2006 by Jensen & Olson Land Surveying, LLC.

All rights reserved. No part of this survey plat may be reproduced or transmitted in any form by any means - graphic, electronic, or mechanical, including photocopying, tracing, or information storage and retrieval systems - without permission in writing from Douglas G. Olson, Jensen & Olson Land Surveying, LLC.


Notes: 1) This survey plat is not certified unless signed and sealed in red ink.

2) This survey is subject to Wisconsin lien laws. This Plat of Survey is the notice of intent to file lien. Lien waiver required.

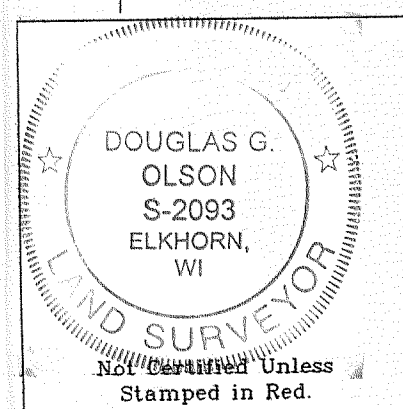

I, Douglas G. Olson, Wisconsin Registered Land Surveyor, do hereby certify that this survey was performed by me or under my direction in full compliance with the owner's/agent's instructions and Chapter A-E 7 of the Wisconsin Administrative Code "Minimum Standards for Property Surveys", and that this map is an accurate representation thereof to the best of my knowledge and belief.

Douglas G. Olson
Wisconsin Registered Land Surveyor - 2093

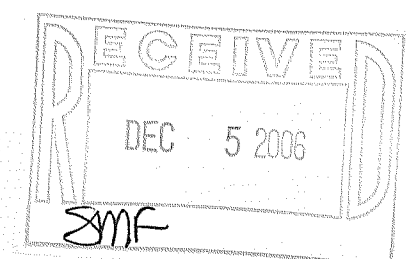

Legend
Found Iron Pipe
Found Iron Rod
Set Iron Rod 3/4" dia.
Set Wood Stake
Recorded Information
Utility Box or Pedestal
Soil Boring
Asphalt Surface

Sheet 1 of 1 Sheets
Job Reference Number
2006.075

2006.075

Jensen & Olson Land Surveying, LLC

45 South Wisconsin Street
Elkhorn, Wisconsin. 53121
Telephone (262) 723-3434
Facsimile (262) 723-8044

Survey Date: June 15, 2006.
Revisions: No. 1 - Foundation

GBEC-6

316-1890