


FARRIS, HANSEN & ASSOC. INC.

7 RIDGWAY COURT- P.O. BOX 437
ELKHORN, WISCONSIN 53121
PHONE (262) 723-2098
FAX (262) 723-5886

PLAT OF SURVEY
LOTS 16 THRU 19 OF BLOCK M, NORTH LAKE BEACH TRAC. 2
LOCATED IN TOWN 3 NORTH, RANGE 16 EAST
WALWORTH COUNTY, WISCONSIN

ORDERED BY: HARVEY PLUCINSKI
W5174 JASON ROAD
ELKHORN, WI. 53121

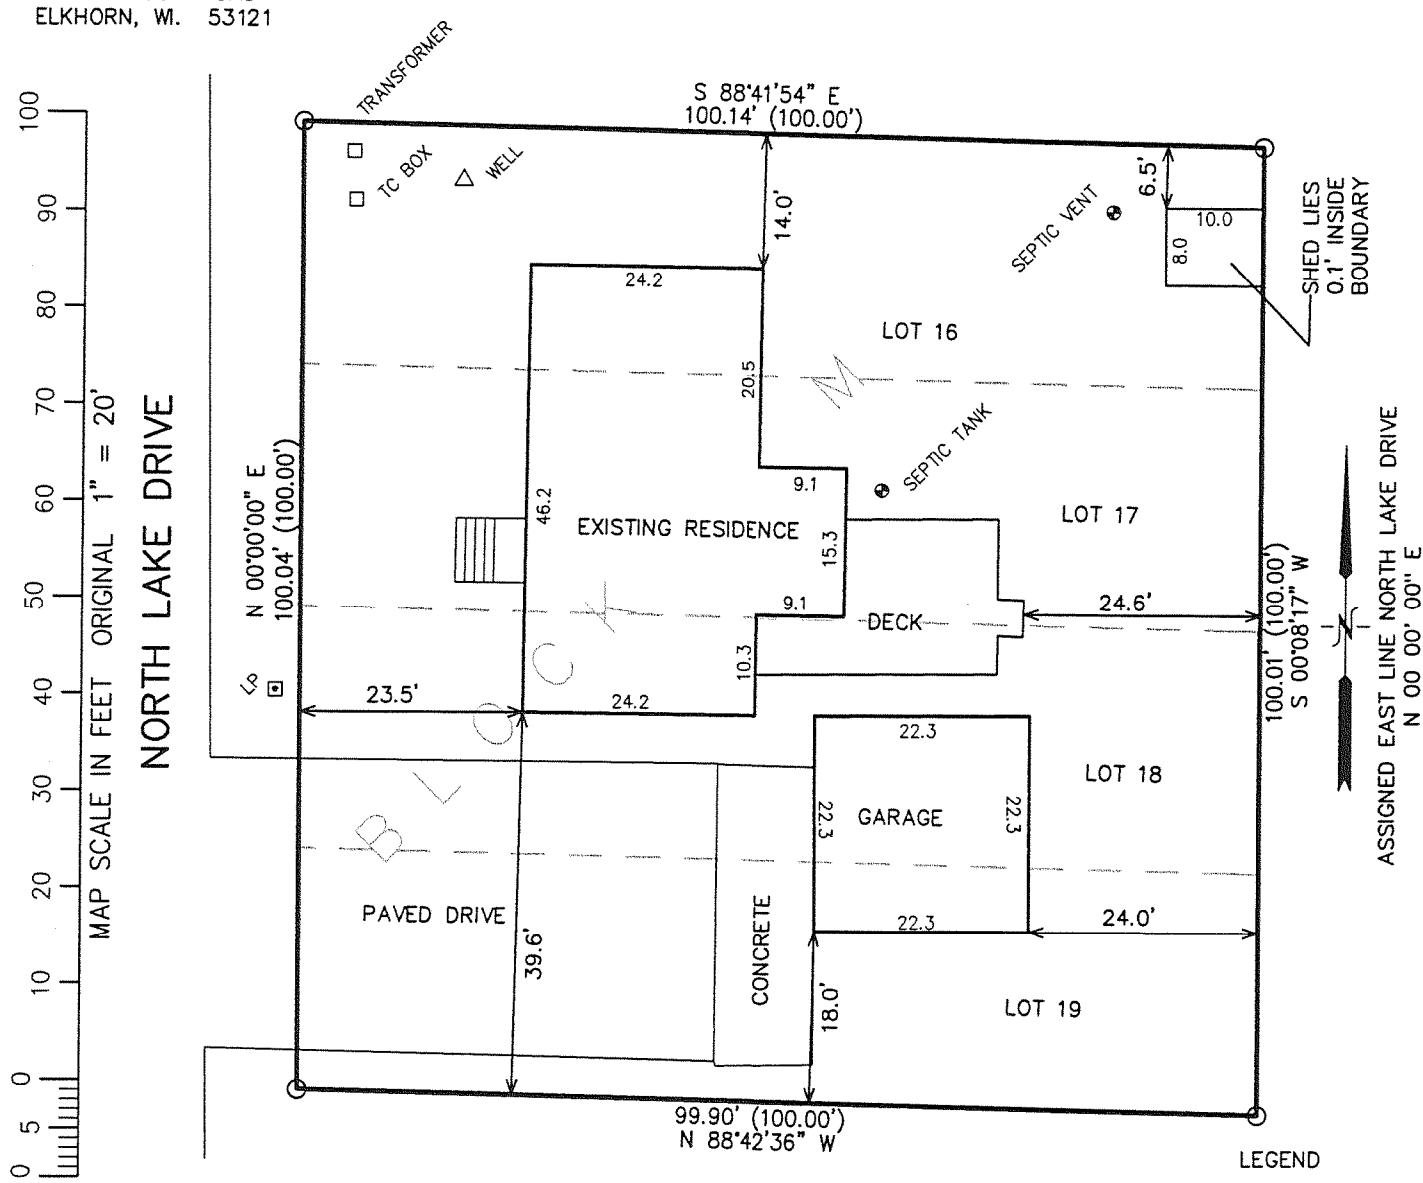

DEC 15 2006 GN LBA - 176

316-1899