
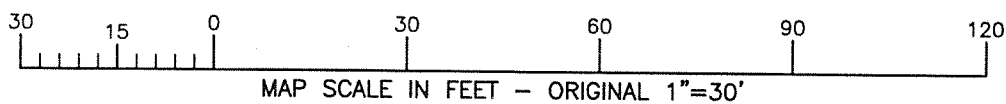


ASSIGNED THE SOUTHWESTERLY LINE OF BLOCK 3
S38°50'30"E

LOTS 5-8, BLOCK 3 OF NORTH LAKE SHOREWOODS,
A SUBDIVISION LOCATED IN SECTION 5, T 1 N, R 16 E,
TOWN OF SUGAR CREEK, WALWORTH COUNTY, WISCONSIN.

LEGEND
—FOUND IRON REBAR STAKE
 (XXX)—RECORDED AS

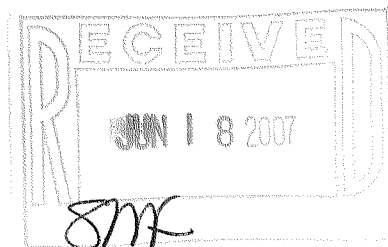


I HEREBY CERTIFY THAT THE ABOVE DESCRIBED PROPERTY HAS BEEN SURVEYED UNDER MY DIRECTION AND THAT THE ABOVE MAP IS A TRUE REPRESENTATION THEREOF AND SHOWS THE SIZE AND LOCATION OF THE PROPERTY AND ITS EXTERIOR BOUNDARIES. THIS SURVEY IS MADE FOR THE USE OF THE PRESENT OWNERS OF THE PROPERTY, AND ALSO THOSE WHO PURCHASE, MORTGAGE, OR GUARANTEE THE TITLE THERETO WITHIN ONE YEAR FROM THE DATE HEREOF.

DATED: 5/22/2007

PETER S. GORDON

PROJECT: 7319
DATE: 05/22/2007
SHEET 1 OF 1

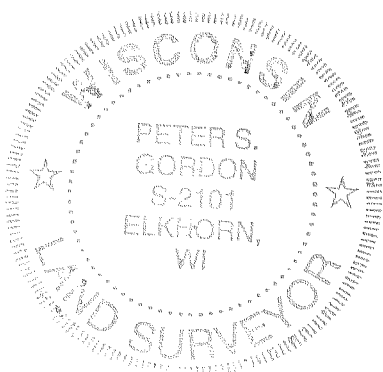

GNLS-23A

MAY 22 1964

316-1919