
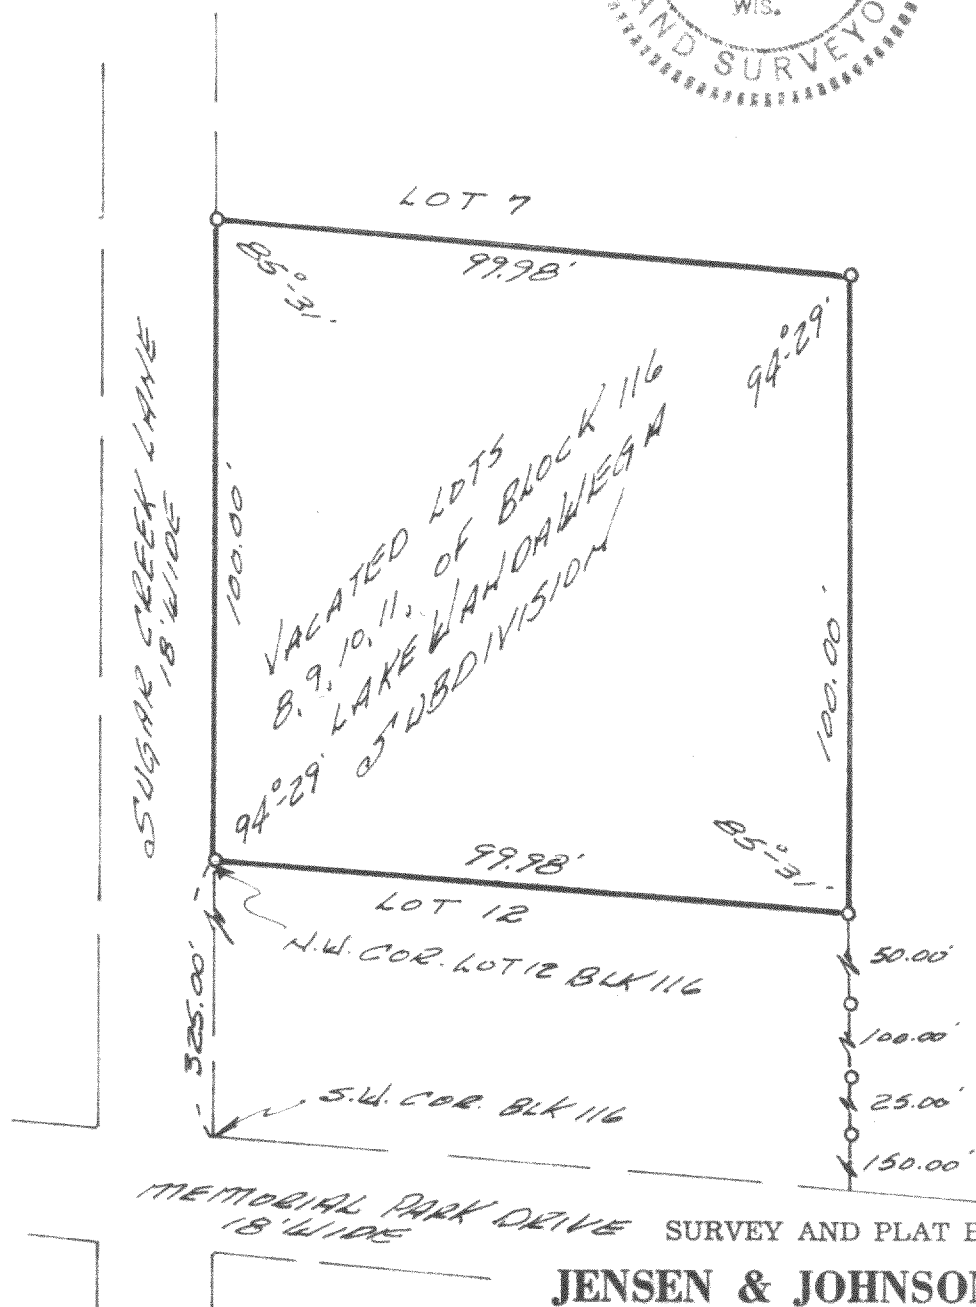


PLAT OF SURVEY

OF

VACATED LOTS 8, 9, 10, 11, BLOCK 116, LAKE WANDAWEGA SUBDIVISION, LOCATED IN THE SOUTHWEST $\frac{1}{4}$ OF SECTION 1, T34N R16E OF WALWORTH COUNTY, WISCONSIN.

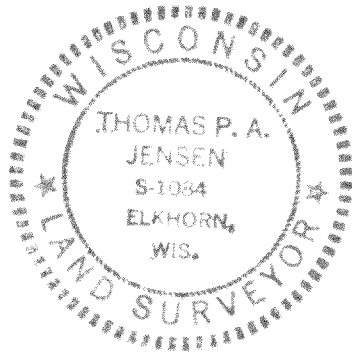

SURVEY AND PLAT BY
JENSEN & JOHNSON, INC.
CIVIL ENGINEERS AND SURVEYORS

Elkhorn, Wisconsin

LEGEND

- — Iron Pipe FOUND
 - — Concrete Monument
- Scale 1" = 30'

WE CERTIFY: That we have surveyed the above described property and that the plat shown hereon is an accurate survey and a true representation thereof and correctly shows the exterior boundary lines and all divisions of said property.

Date 3/4/1975

Thomas P. A. Jensen

Wisconsin Registered Land Surveyor, No. S-1084

GSC 1-11D