
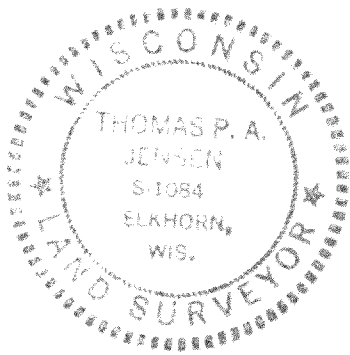


PLAT OF SURVEY

OF

LOT 9 BLOCK 104 OF LAKE
WANDA WEGA SUBDIVISION,
LOCATED IN THE S.E. 1/4 OF
SECTION 2, T3N R16E,
WALWORTH COUNTY, WISCONSIN

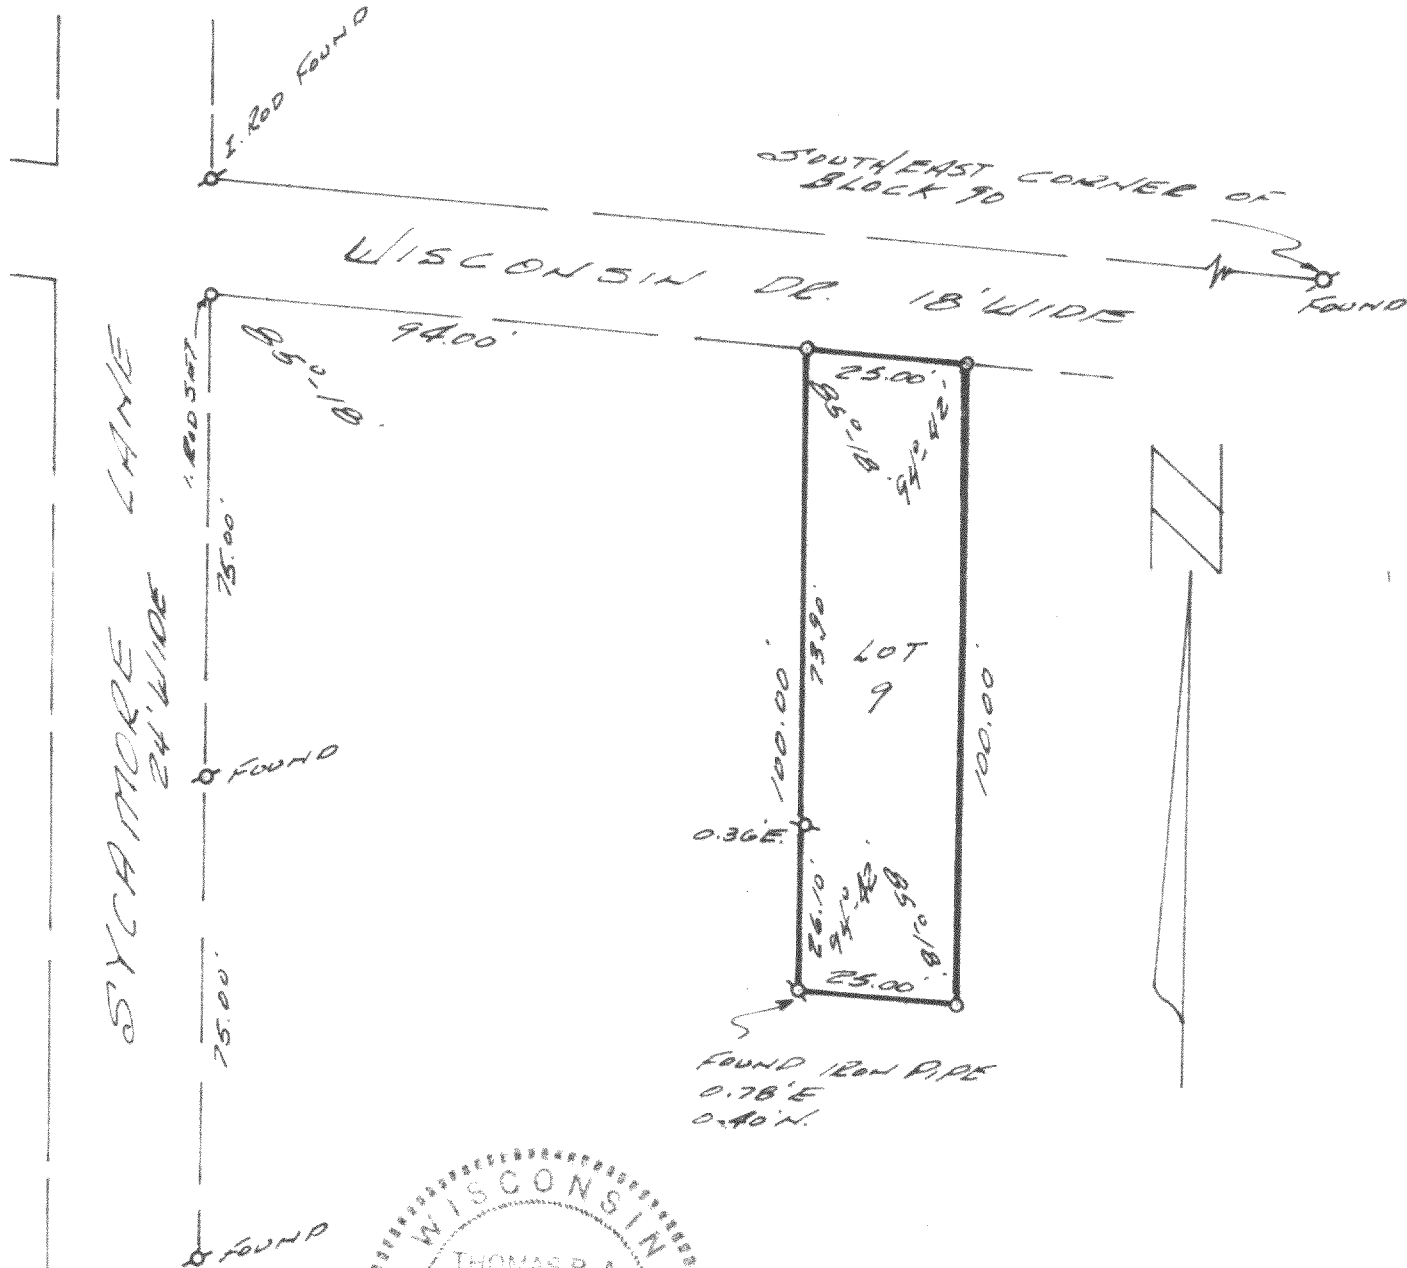

SURVEY AND PLAT BY

JENSEN & JOHNSON, INC.
CIVIL ENGINEERS AND SURVEYORS

Elkhorn, Wisconsin

LEGEND

- — Iron Pipe SET
 - — Concrete Monument
- Scale 1" = 30'

WE CERTIFY: That we have surveyed the above described property and that the plat shown hereon is an accurate survey and a true representation thereof and correctly shows the exterior boundary lines and all divisions of said property.

Date July 24, 1975 Thomas P. A. Jensen
T. P. A. JENSEN,
Wisconsin Registered Land Surveyor, No. S-1084

GLW-264