

Plat of Survey

SURVEY FOR: ROBERT H. & MARY C. HARTZELL


LOCATION: UNIT 15, WILLOW RUN R.V. COMDOMINIUM RESORT, WALWORTH COUNTY

DESCRIPTION: UNIT 15, WILLOW RUN R.V. CONDOMINIUM RESORT RECORDED IN VOLUME 297 OF RECORDS ON PAGE 32, LOCATED IN SECTION 13, T3N, R16E, WALWORTH COUNTY, WISCONSIN.


SUBJECT TO ALL RIGHTS, RESERVATIONS, RESTRICTIVE COVENANTS, AND EASEMENTS RECORDED OR UNRECORDED.

CURVE	RADIUS	ARC LENGTH	CHORD LENGTH	CHORD BEARING	DELTA ANGLE
C1	3396.26'	74.98'	74.98'	S11°23'04"W	01°15'54"
C1(R)	3485.00'	74.96'			

NOTES:
1) COMMON ELEMENT ROADWAY ESTABLISHED USING A BEST FIT CURVE

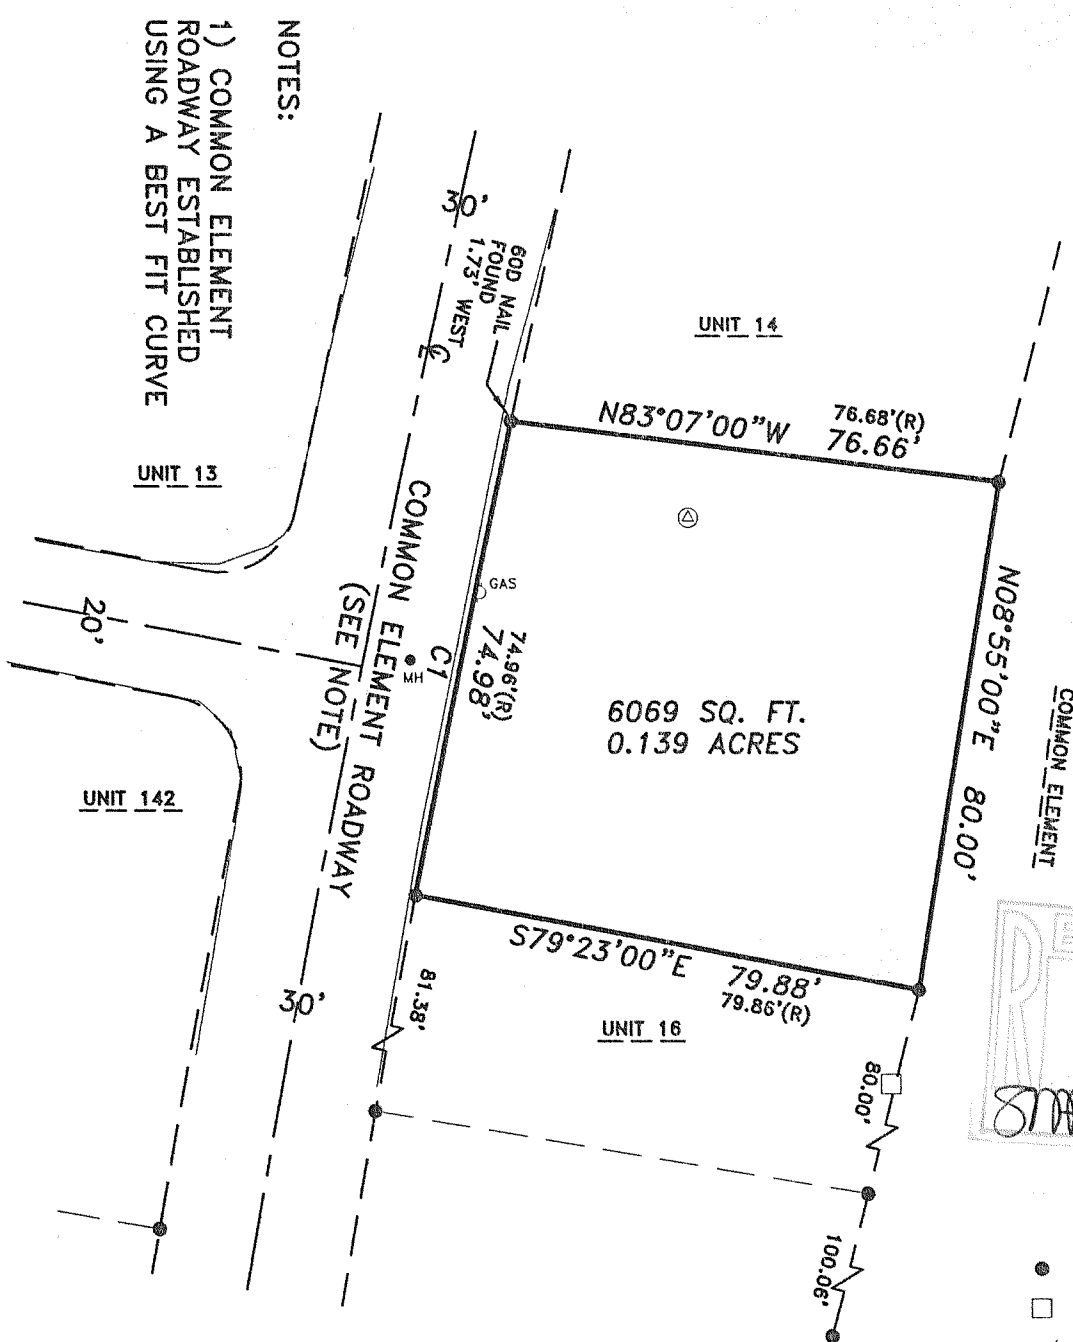

SCALE: 1" = 30'

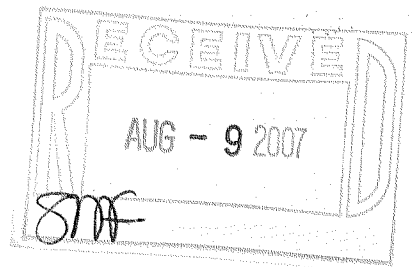

LEGEND

- 5/8" IRON REBAR FOUND
- UTILITY PEDESTALS
- GAS ○ GAS VALVE
- MH ● MANHOLE
- ⊙ SEWER CLEANOUT
- (R) RECORDED AS



SOUTHWEST
SURVEYING & ASSOCIATES, Inc.

W 1065 HIGHWAY CI, P.O. BOX K
PALMYRA, WI. 53156
262-495-4910

State of Wisconsin) ss I certify that I have surveyed the above described (property) and the above map is a true
Jefferson County) representation thereof and shows the size and location of the Property, its exterior boundaries, the location of
fences, apparent easements and roadways and visible encroachments, if any.

This survey is made for the exclusive use of the present owners of the Property, and also those who purchase, mortgage, or guarantee title thereto within one (1) year hereof.

THIS IS A JOHN C. KANNARD AUTHORIZED
PRINT ONLY IF SIGNATURE APPEARS IN
RED INK ON BLACK LINE PRINT.

JOHN C. KANNARD, Registered Land Surveyor

SHEET 1 OF 1
DATE: NOVEMBER 22, 2006
JOB NO: H-206144

GWR-15

316-1937