

53147

**DESCRIPTION:**

THE NW 1/3 OF LOT 8, THE SE 1/3 LOT 9 AND ALL OF LOTS 10, 11, 12, 13, 14, 15, 16, 17 IN BLOCK 51 OF INTERLAKE SUBDIVISION, TOWN OF SUGAR CREEK, WALWORTH COUNTY, WISCONSIN.

- ( ) = recorded as
- = found iron bar
- = found iron pipe
- = set iron pipe
- = set iron bar

SCALE 1" = 30'

JOB # 01-294 ADD

TAX ID # 3-16-GI-00465


**NOTE:** BEARINGS REFERENCED TO THE RECORDED  
\_\_\_\_\_ PLAT OF INTERLAKEN SUBDIVISION

COMPARE LEGAL DESCRIPTION ABOVE AND DRAWING WITH DEED, FOR BUILDING RESTRICTIONS AND EASEMENTS NOT SHOWN, REFER TO DEED, ABSTRACT SOURCES AND LOCAL MUNICIPAL CODES. NOTIFY THE SURVEYOR IMMEDIATELY OF ANY DISCREPANCY.

"I hereby certify that I have surveyed the above described property and that the above map is a true representation thereof and shows the size and location of all visible structures, apparent easements and encroachments if any."

This survey is made for the present owners of the property, and those who purchase, mortgage, or guarantee the title thereto, within one year from the date hereof.

# PLAT OF SURVEY

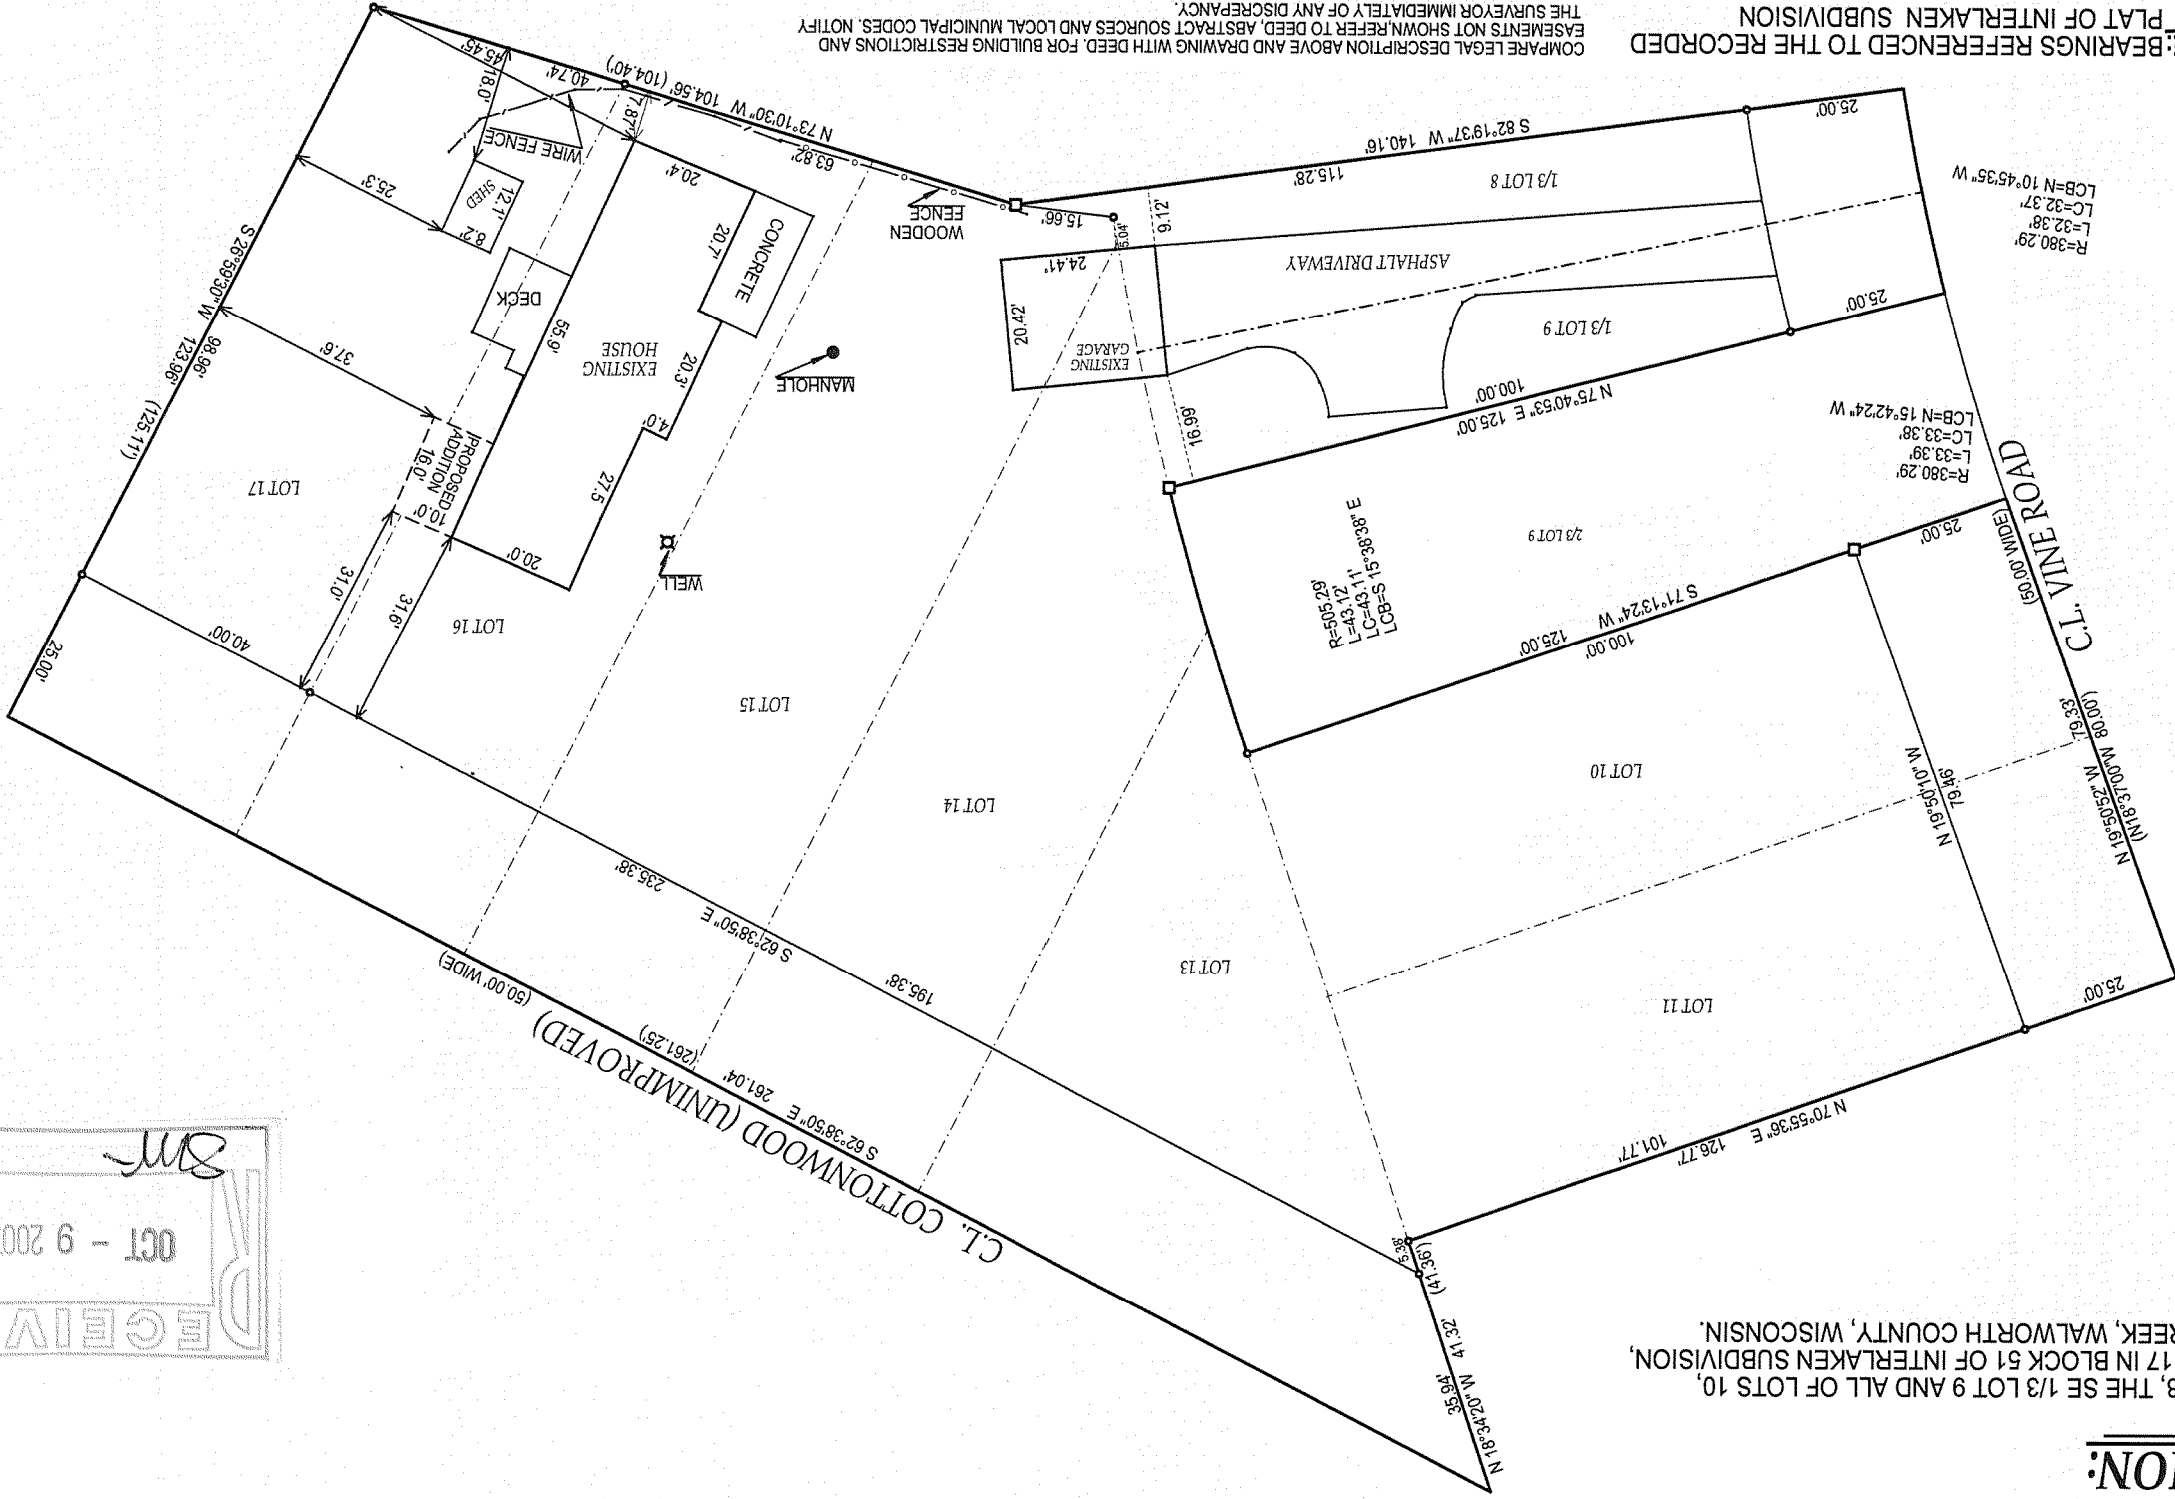

RECEIVED  
OCT - 9 2007



JOHN KROTT S - 2258  
Wisconsin Registered Land Surveyor  
(original if signed in red)

DATED THIS 8TH DAY OF AUGUST 2001  
REVISED ON THE 25TH DAY OF JULY 2007

216 - 012