



GBEC-1

316 - 1949

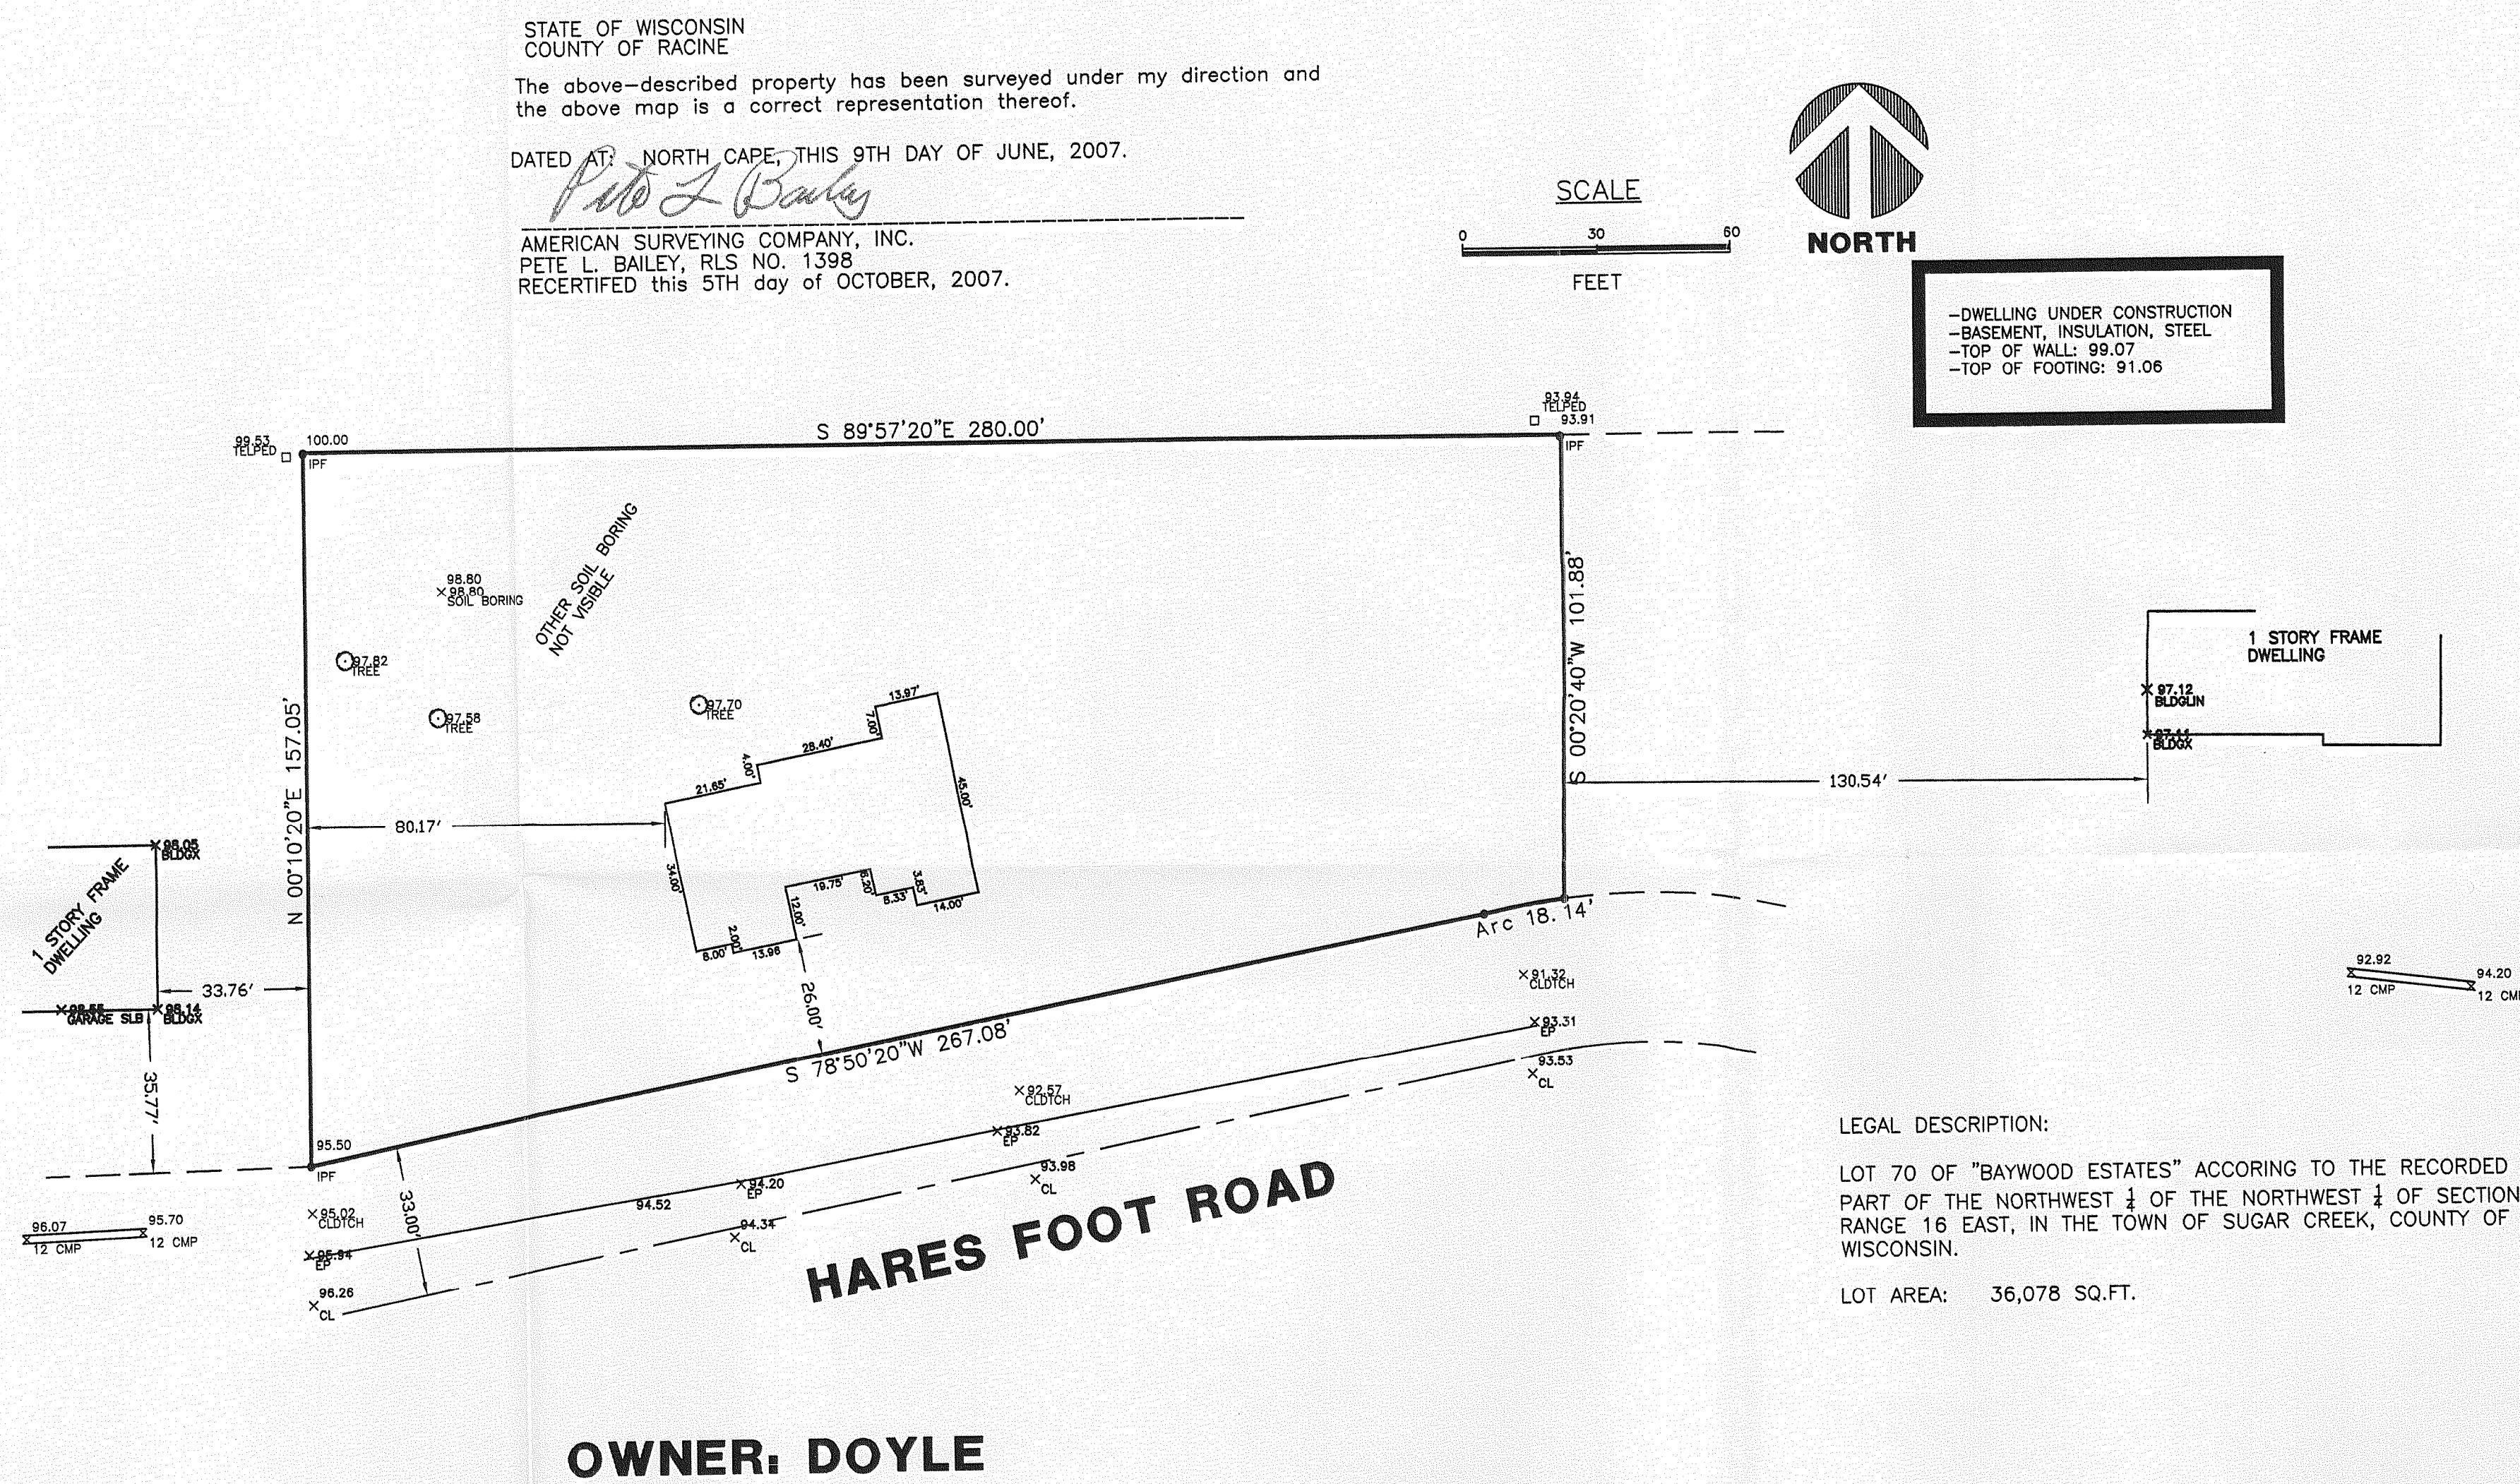

RECEIVED
DEC 10 2007
3MP

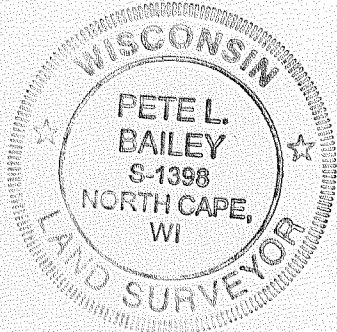

DRAWN BY: PLB		REVISIONS: DATE	
CHECKED BY: PLB		07/10/07: CORRECTED OWNERS NAME	
PLOT SCALE: 1" = 30'			
DATE: 06/09/2007			
JOB NO.: 2007115			
DWG. FILE: JN207175R		CLIENT NO. 00078	

TOWN OF SUGAR CREEK

PROJECT:

PLAT OF SURVEY/STAKE OUT SURVEY

PREPARED FOR: NORM KEEKER AND SONS

Sheet
1
of
1

AMERICAN SURVEYING COMPANY, INC.

12207 C.T.H. "K" FRANKSVILLE, WISCONSIN 53126
TEL. (262) 835-4774 FAX: (262) 835-2379
beau@fordbailey@hotmail.com