

Property Exhibit


of

Property Corners Restaked on

Lot 1 of Certified Survey Map No. 2917,

recorded in Vol. 15 of Certified Survey Maps of Walworth County on
Page 164 and located in the Southwest 1/4 of Section 8, Town 3 North,
Range 16 East, Town of Sugar Creek, Walworth County, Wisconsin.

Prepared for: **Sadie Smith**
W5269 Wisconsin Drive
Elkhorn, Wisconsin. 53121

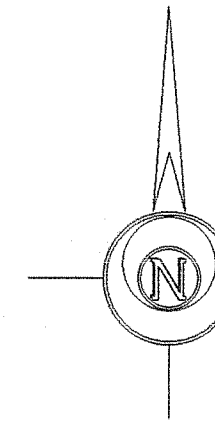

Bearings reference to Certified
Survey Map No. 2917.

County Trunk Highway A

(East 722.00')
East 722.14'

(66' Wide)

R.O.W.

(N88°59'24"E 2663.84') State Plane
(East 2663.83') CSM 2917
East 2663.83'

North line of the Southwest 1/4 of Section 8-3-16.

Center 1/4 Corner
Section 8-3-16.
(N. 270.665.41)
(E. 2,367.724.14)

East 721.29'
(East 721.17')

R.O.W.

Lot 1

5.548 Acres
241,658 Sq.Ft.


5.001 Acres
217,841 Sq.Ft.
Exclusive of R.O.W.

Existing improvements located on the property not shown.

Tax Parcel
GSC 800016

N89°59'34"W 713.48'
(West 713.51')

Tax Parcel
GSC 800016

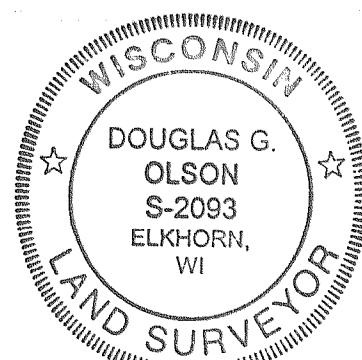

Copyright © 2007 by Jensen & Olson Land Surveying, LLC.

All rights reserved. No part of this survey plat may be reproduced
or transmitted in any form by any means - graphic, electronic, or
mechanical, including photocopying, tracing, or information storage
and retrieval systems - without permission in writing from Douglas
G. Olson, Jensen & Olson Land Surveying, LLC.

Survey Date: January 4, 2008.
Revisions:

Scale in Feet
1" = 40'
0' 20' 40' 80'

Jensen & Olson Land Surveying, LLC
45 South Wisconsin Street
P.O. Box 322
Elkhorn, Wisconsin. 53121
Telephone (262) 723-3434
Facsimile (262) 723-8044

Legend
■ Found County Section Corner
● Found Iron Rod, 3/4" dia.
○ Recorded Information

Sheet 1 of 1 Sheets
Job Reference Number
2008.001
2008.001

GA2917-1

316-1968