

Tax Parcel
GNLB2 00292A

North Lake Drive

Width Varies

Location of buried telephone line as indicated
by diggers hotline flagging.

12" Culvert

Location of buried electric line as indicated
by diggers hotline flagging.

Geneva Road

(33' Wide)

Grassy Path

Chesapeake Drive

Unimproved
(30' Wide)



Plat of Survey

of

Lots 17, 18 and 19 and Lots 40, 41 and 42 of
Block R of North Lake Beach, Tract No. 2,

located in the Northwest 1/4 of Section 8, Town 3 North, Range
16 East, Town of Sugar Creek, Walworth County, Wisconsin.

Surveyed for: **Harrison Homes, LLC**
W6568 Barkers Road
Elkhorn, Wisconsin. 53121

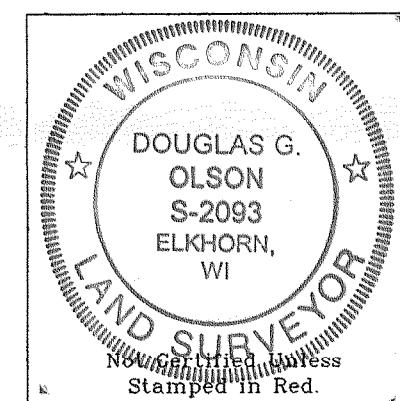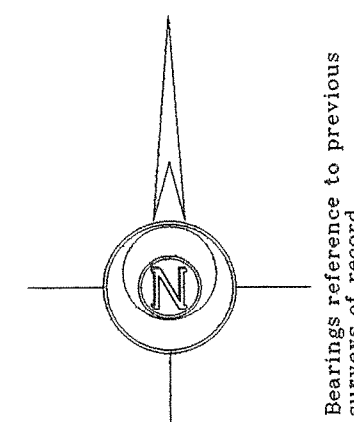

Notes: 1) This survey plat is not
certified unless signed
and sealed in red ink.


2) This survey is subject to Wisconsin lien laws.
This Plat of Survey is the notice of intent
to file lien. Lien waiver required.

Copyright © 2007 by Jensen & Olson Land Surveying, LLC.

All rights reserved. No part of this survey plat may be reproduced
or transmitted in any form by any means - graphic, electronic, or
mechanical, including photocopying, tracing, or information storage
and retrieval systems - without permission in writing from Douglas
G. Olson, Jensen & Olson Land Surveying, LLC.

I, Douglas G. Olson, Wisconsin Registered Land Surveyor,
do hereby certify that this survey was performed by me or under my
direction in full compliance with the owner's/agent's instructions
and Chapter A-E 7 of the Wisconsin Administrative Code "Minimum
Standards for Property Surveys"; and that this map is an accurate
representation thereof to the best of my knowledge and belief.

Douglas G. Olson
Wisconsin Registered Land Surveyor - 2093

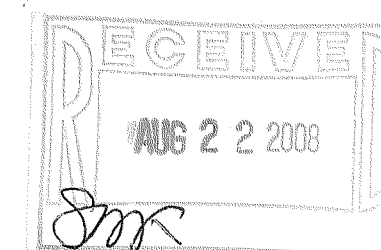

Survey Date: November 13, 2007
Revisions: No. 1 - Proposed House
No. 2 - Foundation
No. 3 - Proposed Shed

Scale in Feet
1" = 20'
0' 10' 20' 40'

Jensen & Olson Land Surveying, LLC

45 South Wisconsin Street
P.O. Box 322
Elkhorn, Wisconsin. 53121
Telephone (262) 723-3434
Facsimile (262) 723-8044

Legend
● Found Iron Rod, 3/4" dia.
○ Found Spindle
○ Recorded Information
□ Utility Box or Pedestal
▲ Diggers Hotline Flag
■ Asphalt Surface

Sheet 1 of 1 Sheets
Job Reference Number
2007.158
13ar16e-2007158new-2007158rev3.S90

2007.158

GNLB2-246

910-1080

316-1989