

Tax Parcel
GNLB2 00292A

North Lake Drive

Width Varies

Location of buried telephone line as indicated
by diggers hotline flagging

12" Culvert

Location of buried electric line as indicated
by diggers hotline flagging

Lot 13

Lot 14

(100')
S88°37'11"E 100.05'

Lot 15

Lot 16

N88°37'11"W 200.10'

Lot 17

Lot 18
Poured Concrete
Foundation
N6836

Lot 19

Lot 20

Lot 21

Lot 22

Lot 23

(100')
100.06'

Lot 36

Lot 37

Lot 38

Lot 39

Lot 40

Lot 41

Lot 42

Lot 43

Lot 44

Lot 45

Lot 46

(100')
100.06'

Geneva Road

(33' Wide)

Grassy Path

Chesapeake Drive

(30' Wide)

Unimproved




Plat of Survey

of

Lots 17, 18 and 19 and Lots 40, 41 and 42 of
Block R of North Lake Beach, Tract No. 2,

located in the Northwest 1/4 of Section 8, Town 3 North, Range
16 East, Town of Sugar Creek, Walworth County, Wisconsin.

Surveyed for: **Harrison Homes, LLC**
W6568 Barkers Road
Elkhorn, Wisconsin. 53121

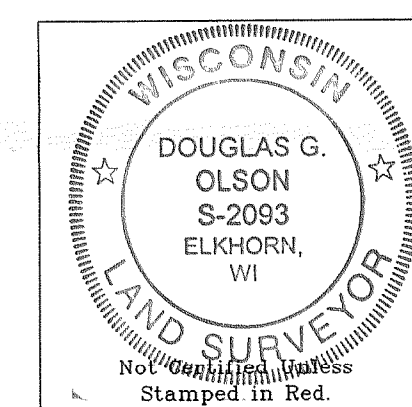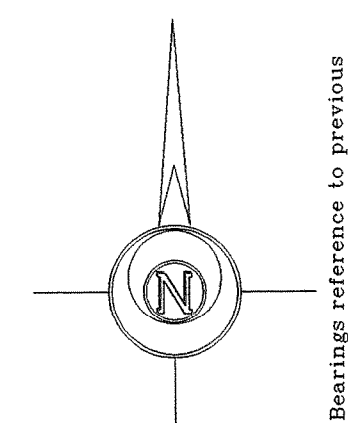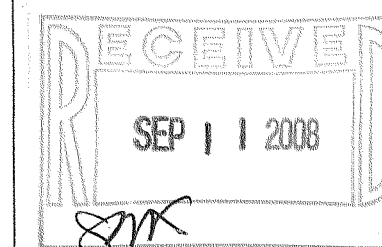

- Notes: 1) This survey plat is not certified unless signed and sealed in red ink.
- 2) This survey is subject to Wisconsin lien laws. This Plat of Survey is the notice of intent to file lien. Lien waiver required.

Copyright © 2007 by Jensen & Olson Land Surveying, LLC.

All rights reserved. No part of this survey plat may be reproduced or transmitted in any form by any means - graphic, electronic, or mechanical, including photocopying, tracing, or information storage and retrieval systems - without permission in writing from Douglas G. Olson, Jensen & Olson Land Surveying, LLC.

I, Douglas G. Olson, Wisconsin Registered Land Surveyor, do hereby certify that this survey was performed by me or under my direction in full compliance with the owner's/agent's instructions and Chapter A-E 7 of the Wisconsin Administrative Code "Minimum Standards for Property Surveys", and that this map is an accurate representation thereof to the best of my knowledge and belief.

Douglas G. Olson
Wisconsin Registered Land Surveyor - 2093

Survey Date: November 13, 2007
Revisions: No. 1 - Proposed House
No. 2 - Foundation
No. 3 - Proposed Shed
No. 4 - Shed location

Scale in Feet
1" = 20'
0' 10' 20' 40'

Jensen & Olson Land Surveying, LLC
45 South Wisconsin Street
Elkhorn, Wisconsin. 53121
Telephone (262) 723-3434
Facsimile (262) 723-8044

Legend
● Found Iron Rod, 3/4" dia.
○ Found Spindle
○ Recorded Information
○ Concrete Cover
○ Septic Vent
○ Utility Box or Pedestal
○ Diggers Hotline Flag
○ Asphalt Surface
○ Concrete

Sheet 1 of 1 Sheets
Job Reference Number
2007.158
130r158-2007158new-2007158rev4.380

2007.158

GNLB2 -246

316-1993