

Tax Parcel  
GNLB2 00292A

North Lake Drive

Width Varies

Location of buried telephone line as indicated  
by diggers hotline flagging

12" Culvert

Location of buried electric line as indicated  
by diggers hotline flagging

Geneva Road

(33' Wide)

Grassy Path

Chesapeake Drive

(30' Wide)

Unimproved




# Plat of Survey

of

Lots 17, 18 and 19 and Lots 40, 41 and 42 of  
Block R of North Lake Beach, Tract No. 2,

located in the Northwest 1/4 of Section 8, Town 3 North, Range  
16 East, Town of Sugar Creek, Walworth County, Wisconsin.

Surveyed for: **Harrison Homes, LLC**  
W6568 Barkers Road  
Elkhorn, Wisconsin. 53121

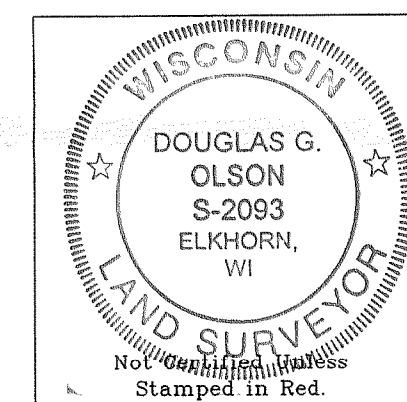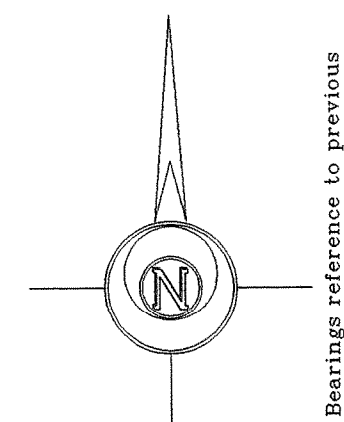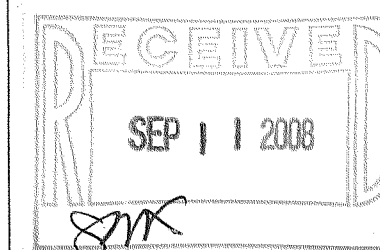

- Notes: 1) This survey plat is not certified unless signed and sealed in red ink.
- 2) This survey is subject to Wisconsin lien laws. This Plat of Survey is the notice of intent to file lien. Lien waiver required.

Copyright © 2007 by Jensen & Olson Land Surveying, LLC.

All rights reserved. No part of this survey plat may be reproduced or transmitted in any form by any means - graphic, electronic, or mechanical, including photocopying, tracing, or information storage and retrieval systems - without permission in writing from Douglas G. Olson, Jensen & Olson Land Surveying, LLC.

I, Douglas G. Olson, Wisconsin Registered Land Surveyor, do hereby certify that this survey was performed by me or under my direction in full compliance with the owner's/agent's instructions and Chapter A-E 7 of the Wisconsin Administrative Code "Minimum Standards for Property Surveys", and that this map is an accurate representation thereof to the best of my knowledge and belief.

Douglas G. Olson  
Wisconsin Registered Land Surveyor - 2093

Survey Date: November 13, 2007  
Revisions: No. 1 - Proposed House  
No. 2 - Foundation  
No. 3 - Proposed Shed  
No. 4 - Shed location

Scale in Feet  
1" = 20'  
0' 10' 20' 40'

Jensen & Olson Land Surveying, LLC  
45 South Wisconsin Street  
Elkhorn, Wisconsin. 53121  
Telephone (262) 723-3434  
Facsimile (262) 723-8044

Legend  
● Found Iron Rod, 3/4" dia.  
○ Found Spindle  
○ Recorded Information  
○ Concrete Cover  
○ Septic Vent  
○ Utility Box or Pedestal  
○ Diggers Hotline Flag  
○ Asphalt Surface  
○ Concrete

Sheet 1 of 1 Sheets  
Job Reference Number  
2007.158  
130r158-2007158new-2007158rev4.380

2007.158

GNLB2 -246

316-1993