

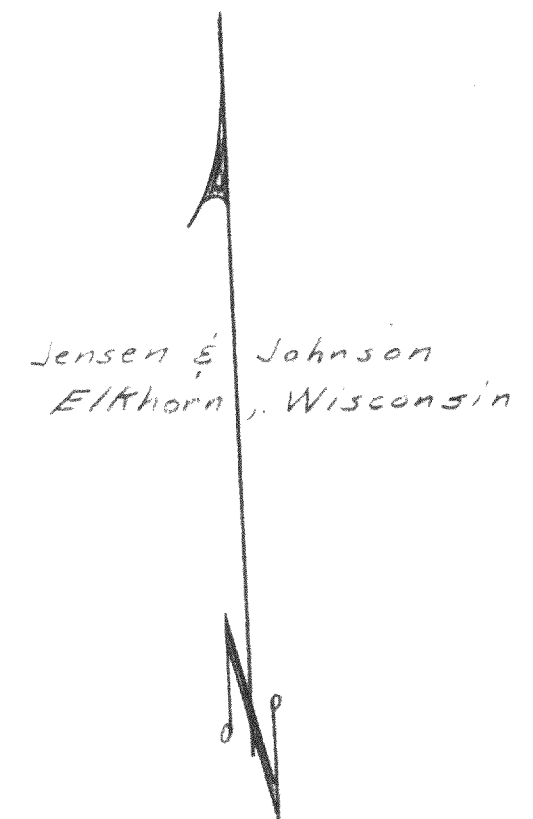


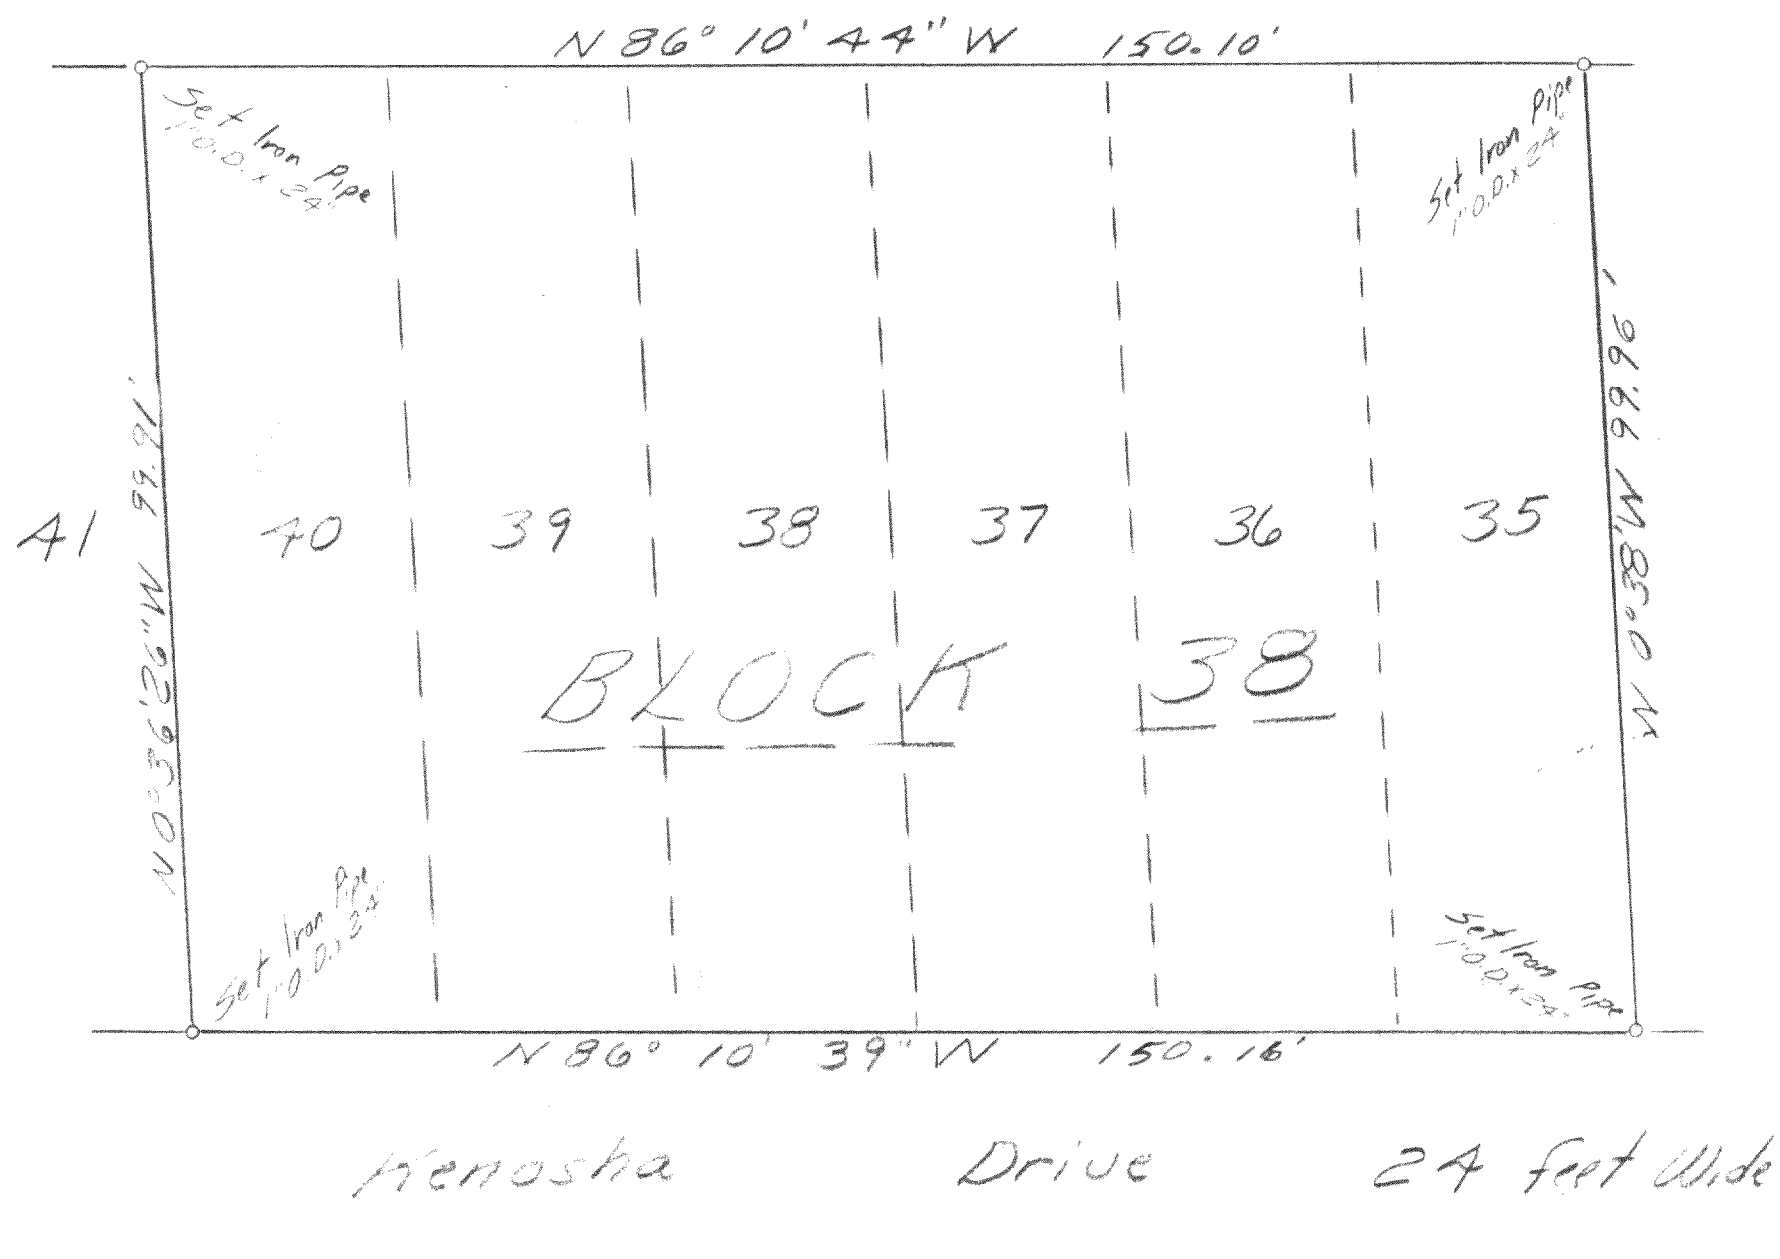

I, Thomas P.A. Jensen, surveyor, do hereby certify that under my direction the lands shown hereon have been surveyed and mapped, and that this plat of Survey is a true and accurate representation of the lot lines to the best of my knowledge and belief.

Dated this 21 day of Oct, 1976
 Thomas P.A. Jensen S-1084

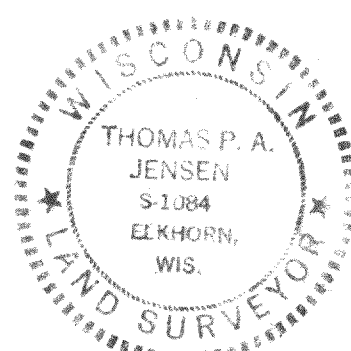

JOB #1658.080 #3
 WORK ORDERED BY THOMAS GRZECZOWIAK

PLAT OF SURVEY **OF**

LOTS 35, 36, 37, 38, 39, & 40 OF BLOCK 38
 OF LAKE WANDAWEGA SUBDIVISION LOCATED
 IN THE NW 1/4 OF SE 1/4 OF SECTION 2, TOWN
 3 NORTH, RANGE 16 EAST, WALWORTH COUNTY,
 WISCONSIN

SCALE 1" = 20 feet

DATE 21 Oct 1976

GLW-16