

LAND-MARK SURVEYING

Mark L. Miritz




Wisconsin Registered Land Surveyor S-2582

N9330 Knuteson Drive
Whitewater, WI 53190
Phone: (262) 495-3284
FAX: (262) 495-8421
LAND-MARKSURVEYING.COM

PLAT OF SURVEY

LOT 1 AND LOT 2 OF BLOCK 17 OF THE ORIGINAL PLAT
OF INTERLAKEN SUBDIVISION, FIRST MAP, LOCATED
IN THE SOUTHEAST 1/4 OF SECTION 11, TOWN 3
NORTH, RANGE 16 EAST, SUGAR CREEK TOWNSHIP,
WALWORTH COUNTY, WISCONSIN.

OWNERS: CHAD S. ZEPEZAUER
VALERIE J. ZEPEZAUER
N6601 ASPEN ROAD
ELKHORN, WI 53121

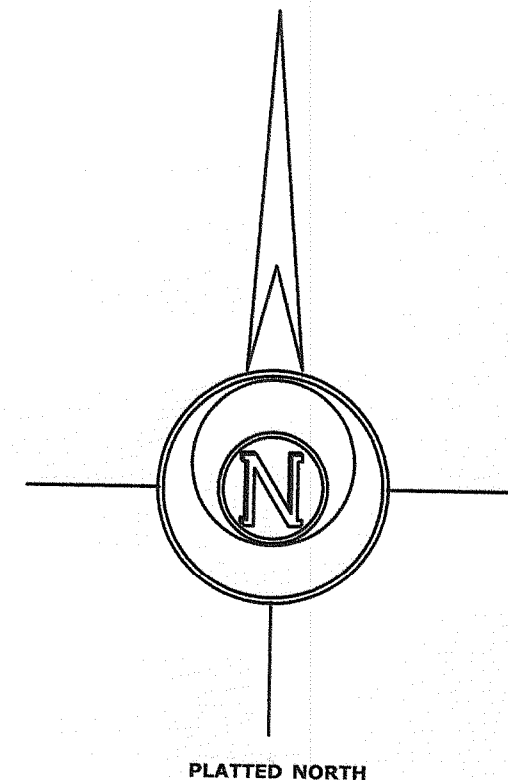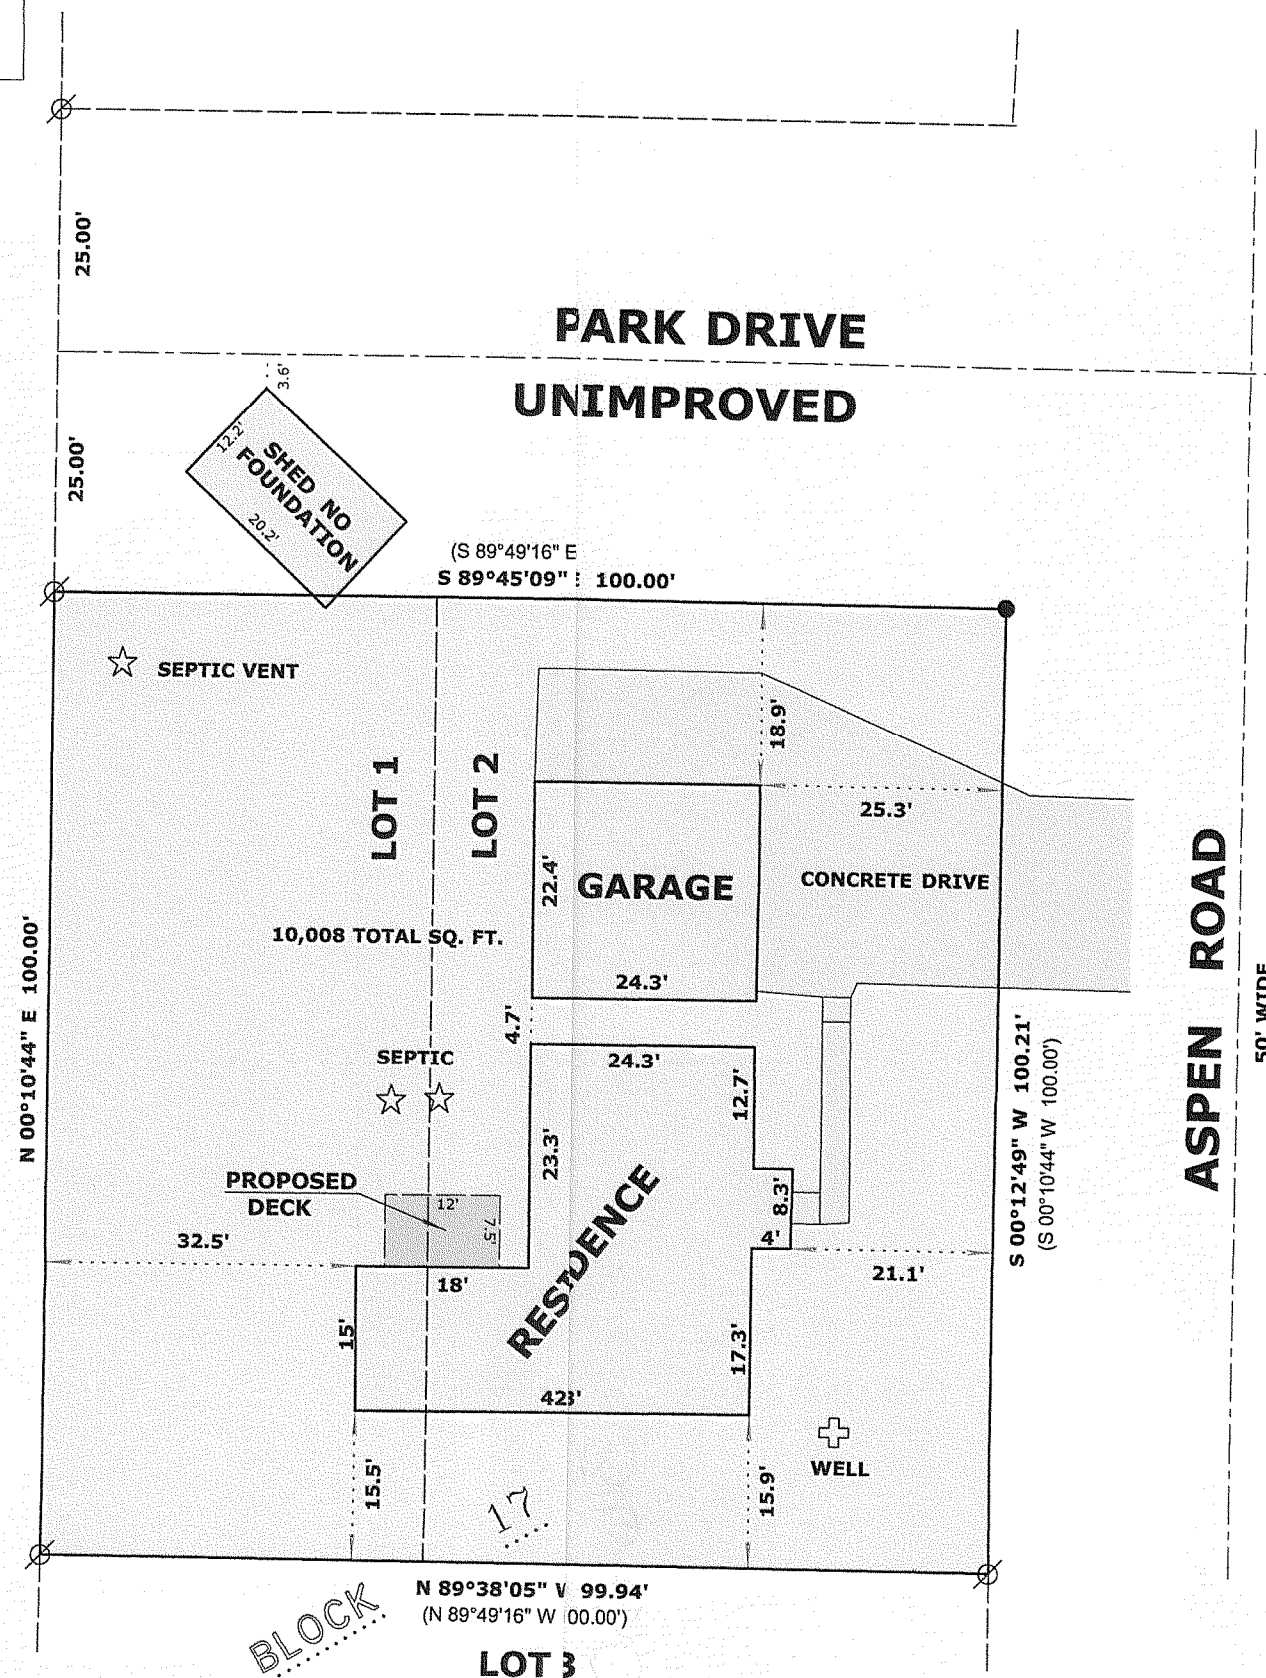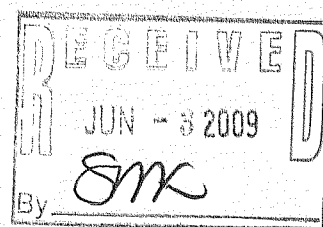

LEGEND

- ⊗ FOUND IRON PIPE
- SET IRON ROD, 24" LONG, WEIGHING 1.5 LBS./LINEAL FT., 3/4" DIA.
- (x x) RECORDED AS DIMENSION

SCALE: 1" = 20 FEET

"I hereby certify that the above described property has been surveyed by me or under my direction and that the above map is a true representation thereof and shows the size and location of the property, its exterior boundaries, the location of all visible structures and dimensions of all principal buildings thereon, boundary fences, apparent easements, roadways and visible encroachments, if any."
"This survey is made for the use of the present owners of the property, and also those who purchase, mortgage, or guarantee the title thereto within one year from date hereof."

Mark L. Miritz
MARK L. MIRITZ
WISCONSIN REGISTERED
LAND SURVEYOR S-2582

REVISED SEPT. 25, 2008 TO SHOW ADDITION "AS BUILT"

DATE: JUNE 12, 2008 JOB NO. 08.605

GI-225

316-2015