

FOR SILVER LAKE INN

WORK ORDERED BY -
STEVE JENNISON
P.O. BOX 291
ELKHORN, WI 53121

FARRIS, HANSEN & ASSOCIATES, INC.
ENGINEERING - ARCHITECTURE - SURVEYING
7 RIDGWAY COURT P.O. BOX 437
ELKHORN, WISCONSIN 53121
OFFICE: (262) 723-2098 FAX: (262) 723-5886

REVISIONS
1/22/2008-KB
MISC. REVISIONS
8/25/2008-KB
REVISE LAYOUT
10/01/2008-KB
REVISE REZONE DESC
10/01/2008-KB
ADD EASEMENT



PROJECT NO.
7083
DATE
07/31/2006
SHEET NO.
1 OF 1

LOT 2 CSM 4213 FOR SILVER LAKE INN

LOTS 13-17 AND PARTS OF LOTS 6 & 18 OF BLOCK 37
OF THE THIRD MAP OF INTERLAKEN

LOCATED IN PART OF THE NORTHEAST 1/4 OF THE SOUTHWEST 1/4 OF SECTION 11,
TOWN 3 NORTH, RANGE 16 EAST, TOWN OF SUGAR CREEK, WALWORTH COUNTY, WISCONSIN

LINE	BEARING	DISTANCE	DISTANCE
L1	S 00°28'15" W	19.87	(20.00')
L2	S 01°07'08" W	19.95	(20.00')

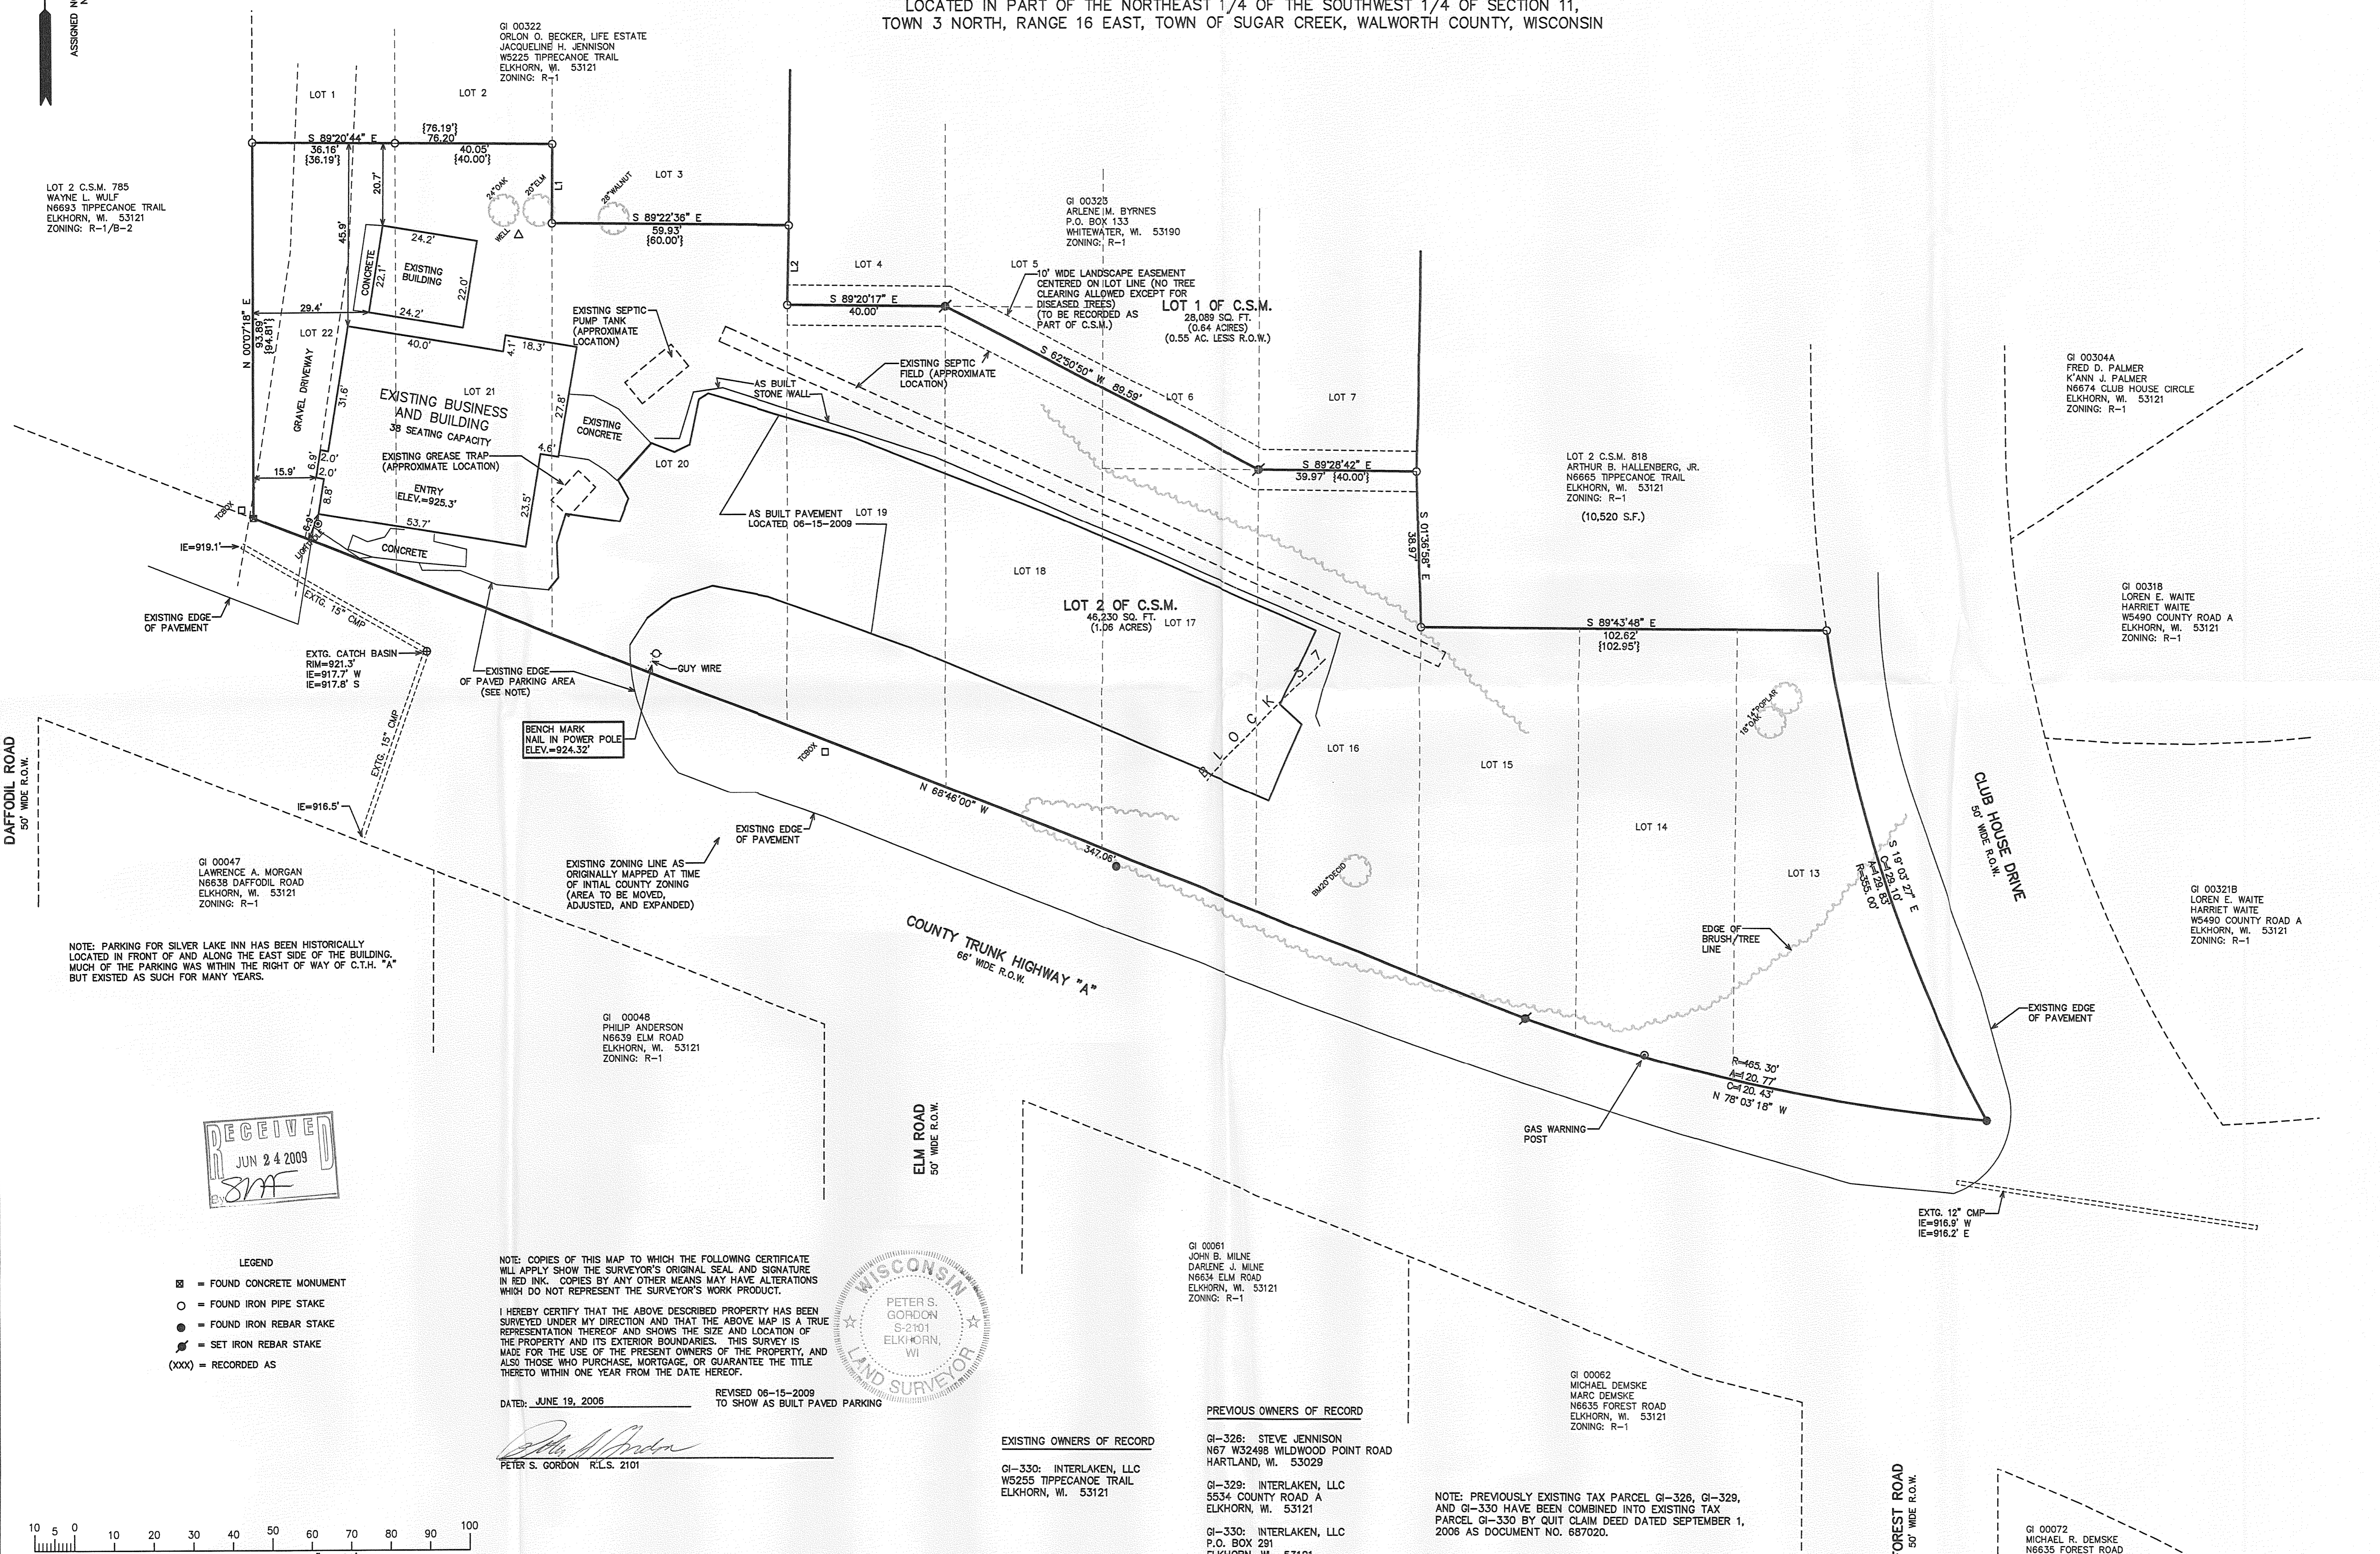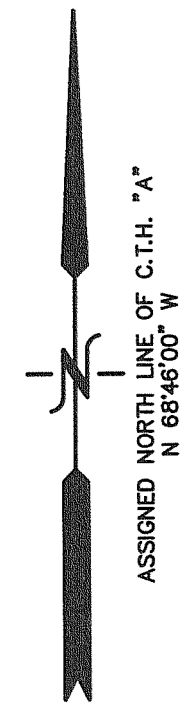

LOT 2 C.S.M. 785
WAYNE L. WULF
N6633 TIPPECANOE TRAIL
ELKHORN, WI. 53121
ZONING: R-1/B-2

GI 00325
ARLENE M. BYRNES
P.O. BOX 133
WHITEWATER, WI. 53190
ZONING: R-1

LOT 1 OF C.S.M.
28,089 SQ. FT.
(0.64 ACRES)
(0.55 AC. LESS R.O.W.)

LOT 2 C.S.M. 818
ARTHUR B. HALLENBERG, JR.
N6665 TIPPECANOE TRAIL
ELKHORN, WI. 53121
ZONING: R-1
(10,520 S.F.)

GI 00304A
FRED D. PALMER
K'ANN J. PALMER
N6674 CLUB HOUSE CIRCLE
ELKHORN, WI. 53121
ZONING: R-1

GI 00318
LOREN E. WAITE
HARRIET WAITE
W5490 COUNTY ROAD A
ELKHORN, WI. 53121
ZONING: R-1

GI 00321B
LOREN E. WAITE
HARRIET WAITE
W5490 COUNTY ROAD A
ELKHORN, WI. 53121
ZONING: R-1

GI 00048
PHILIP ANDERSON
N6639 ELM ROAD
ELKHORN, WI. 53121
ZONING: R-1

GI 00061
JOHN B. MILNE
DARLENE J. MILNE
N6634 ELM ROAD
ELKHORN, WI. 53121
ZONING: R-1

GI 00052
MICHAEL DEMSKE
MARC DEMSKE
N6635 FOREST ROAD
ELKHORN, WI. 53121
ZONING: R-1

GI 00072
MICHAEL R. DEMSKE
N6635 FOREST ROAD
ELKHORN, WI. 53121
ZONING: R-1

NOTE: COPIES OF THIS MAP TO WHICH THE FOLLOWING CERTIFICATE
WILL APPLY SHOW THE SURVEYOR'S ORIGINAL SEAL AND SIGNATURE
IN RED INK. COPIES BY ANY OTHER MEANS MAY HAVE ALTERATIONS
WHICH DO NOT REPRESENT THE SURVEYOR'S WORK PRODUCT.

I HEREBY CERTIFY THAT THE ABOVE DESCRIBED PROPERTY HAS BEEN
SURVEYED UNDER MY DIRECTION AND THAT THE ABOVE MAP IS A TRUE
REPRESENTATION THEREOF AND SHOWS THE SIZE AND LOCATION OF
THE PROPERTY AND ITS EXTERIOR BOUNDARIES. THIS SURVEY IS
MADE FOR THE USE OF THE PRESENT OWNERS OF THE PROPERTY, AND
ALSO THOSE WHO PURCHASE, MORTGAGE, OR GUARANTEE THE TITLE
THEREIN WITHIN ONE YEAR FROM THE DATE HEREOF.

DATE: JUNE 19, 2006 REVISED 06-15-2009
TO SHOW AS BUILT PAVED PARKING

Peter S. Gordon
PETER S. GORDON R.L.S. 2101




EXISTING OWNERS OF RECORD
GI-330: INTERLAKEN, LLC
W5255 TIPPECANOE TRAIL
ELKHORN, WI. 53121

PREVIOUS OWNERS OF RECORD
GI-328: STEVE JENNISON
N67 W32488 WILDWOOD POINT ROAD
HARTLAND, WI. 53029
GI-329: INTERLAKEN, LLC
5534 COUNTY ROAD A
ELKHORN, WI. 53121
GI-330: INTERLAKEN, LLC
P.O. BOX 291
ELKHORN, WI. 53121

NOTE: PREVIOUSLY EXISTING TAX PARCEL GI-326, GI-329,
AND GI-330 HAVE BEEN COMBINED INTO EXISTING TAX
PARCEL GI-330 BY QUIT CLAIM DEED DATED SEPTEMBER 1,
2006 AS DOCUMENT NO. 687020.



- LEGEND
- = FOUND CONCRETE MONUMENT
 - = FOUND IRON PIPE STAKE
 - = FOUND IRON REBAR STAKE
 - ⦿ = SET IRON REBAR STAKE
 - (XXX) = RECORDED AS

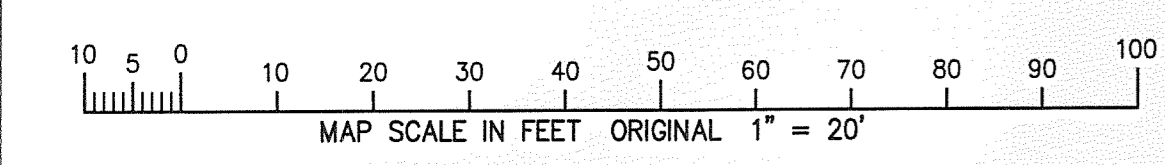

GA4213-2

316-2018