

ABELL
SURVEYING & MAPPING

1140 SEQUOIA STREET • DELAVAN, WISCONSIN 53115
262-728-6737

PLAT OF SURVEY OF



NOTE: BEARINGS ARE REFERENCED TO THE
RECORDED SUBDIVISION PLAT.



SCALE 1"=20'

LEGEND

- - IRON PIPE FOUND
- △ - UTILITY POLE
- - - OVERHEAD UTILITY LINES
- - UTILITY PEDS
- WP - WOOD PORCH
- × - WIRE FENCE
- XX - CHAINLINK FENCE
- () - RECORDED AS

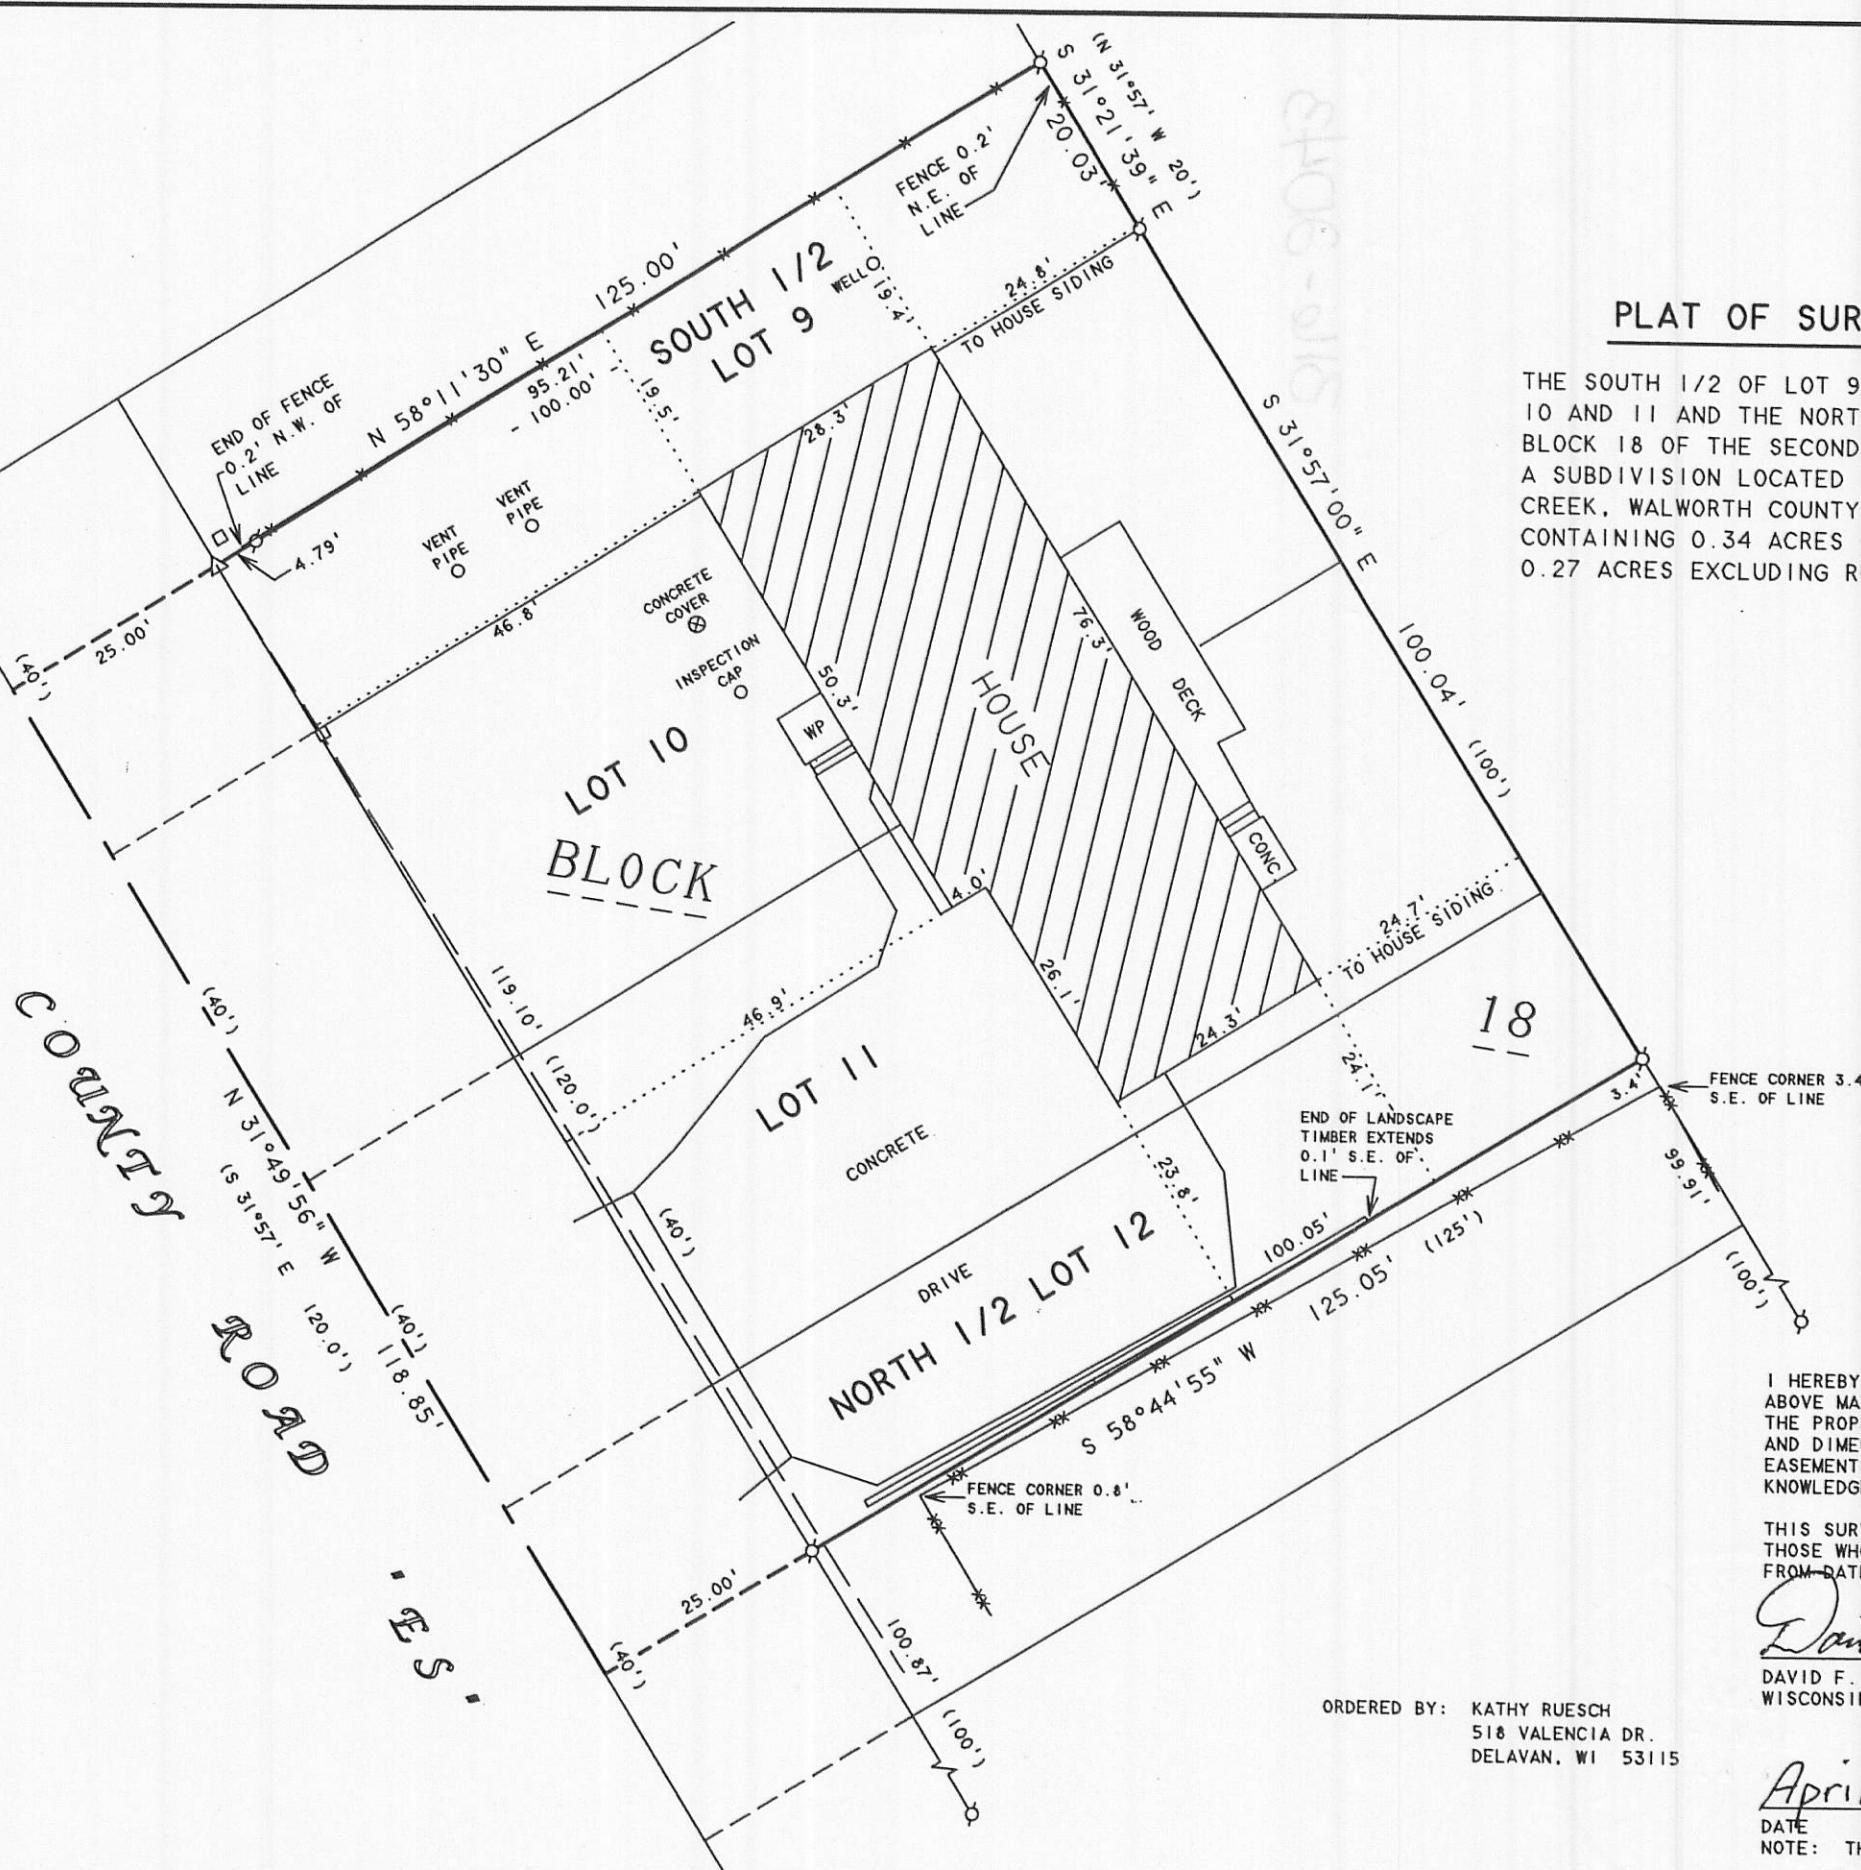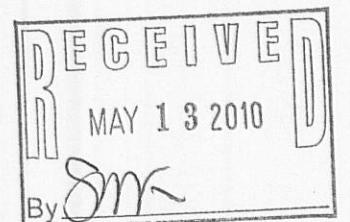

GI-243

311a-2043