

PREPARED FOR:
MARCEY JOHNSON
KEEFE REAL ESTATE, INC.
1040 N. WISCONSIN ST.
ELKHORN, WI 53121




PLAT OF SURVEY

-OF-

KROTT SURVEYING INC.

N3705 WILLOW BEND LANE
LAKE GENEVA WI. 53147
PHONE # (262)248-3697
FAX # (262)249-0639

UNIT 22 OF LAUDERDALE LAKES ESTATES, A CONDOMINIUM LOCATED
IN THE NW 1/4 AND SW 1/4 OF THE SE 1/4 OF SECTION 1 AND THE NW 1/4
OF THE NE 1/4 OF SECTION 12, TOWN 3 NORTH, RANGE 16 EAST, TOWN OF
SUGAR CREEK, WALWORTH COUNTY, WISCONSIN.

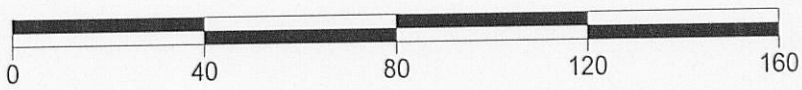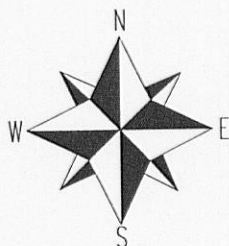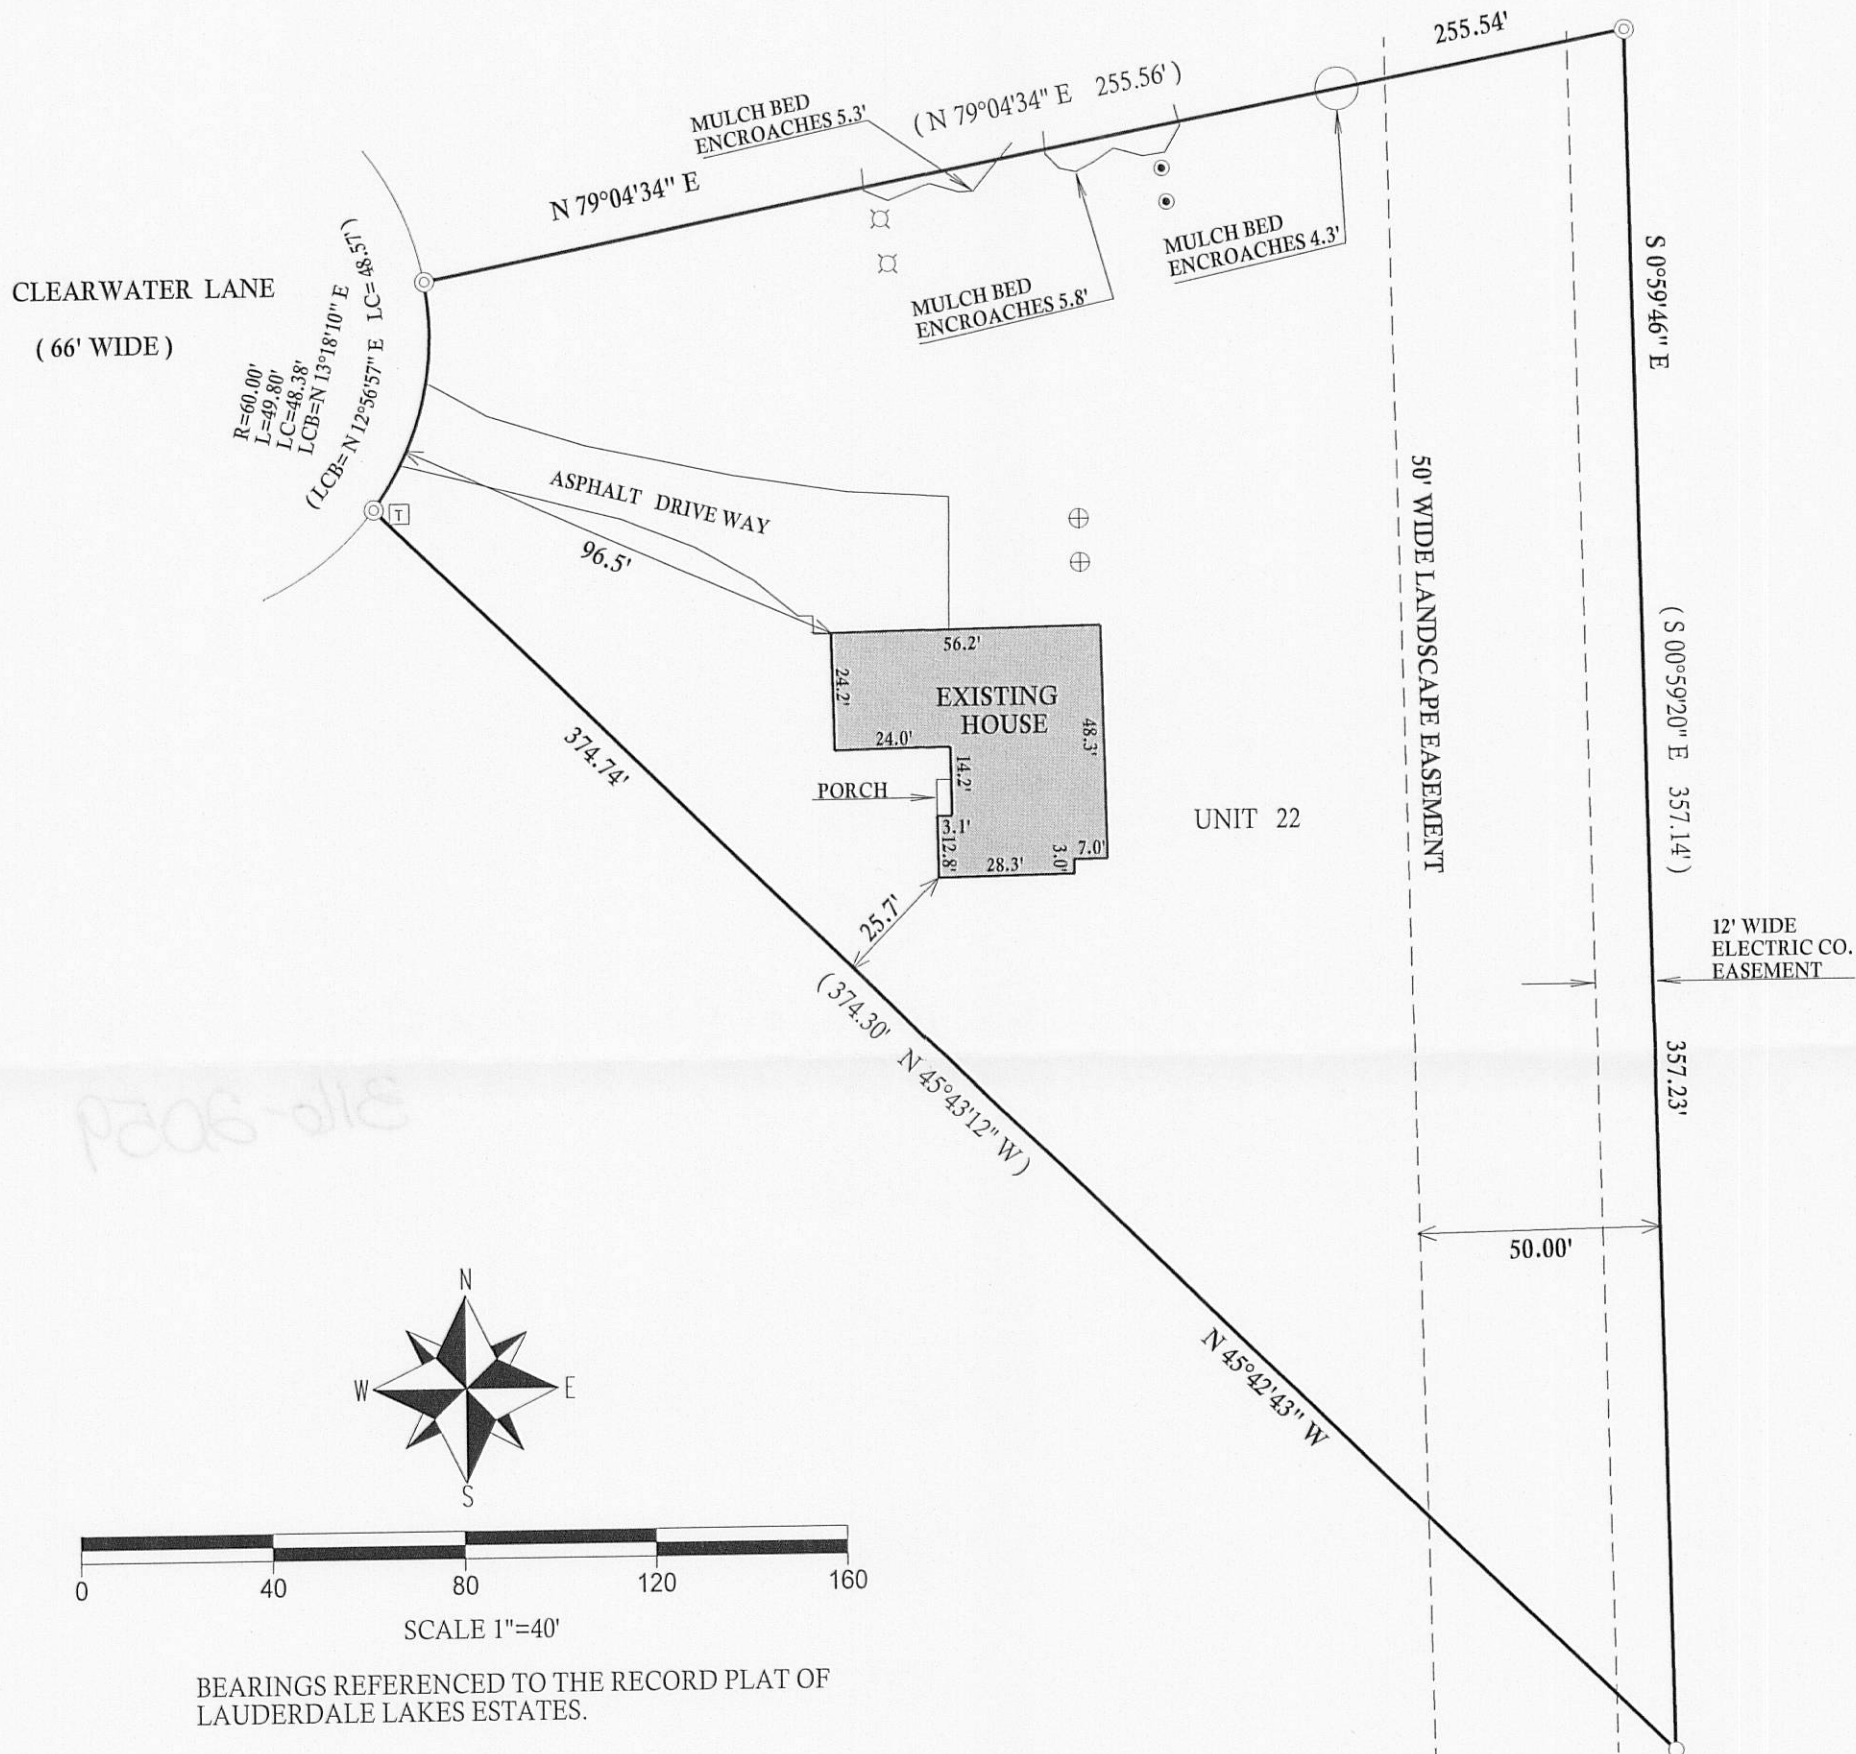


SCALE 1"=40'

BEARINGS REFERENCED TO THE RECORD PLAT OF
LAUDERDALE LAKES ESTATES.

LEGEND


- TRANSFORMER
- FOUND 1" DIA. IRON PIPE
- ⊙ FOUND 2" DIA. IRON PIPE
- ✕ VENT
- ⊙ 4" DIA. PVC PIPE
- ⊕ CONCRETE ACCESS COVER

(XX) RECORDED AS

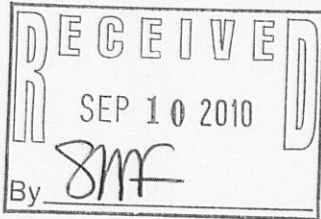

I have surveyed the above-described property and the above map is a true representation thereof and shows the size and location of the property, its exterior boundaries, the location and dimensions of all structures thereon, fences apparent easements and roadways and visible encroachments, if any.

This survey is made for the exclusive use of the present owners of the property, and also those who purchase, mortgage, or insure the title thereto within one (1) year from date hereof; and as to them I warrant the accuracy of said survey map.

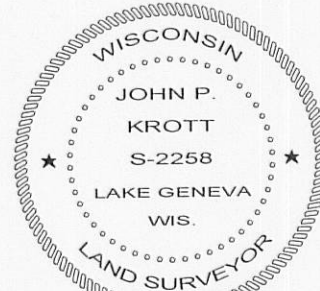

DATED THIS 7th, DAY SEPTEMBER, 2010

John P. Krott

JOHN KROTT S - 2258
Wisconsin Registered Land Surveyor
(original if signed in red)

JOB # 10-149

TAX ID # GLE00001