


ABELL
SURVEYING & MAPPING
1140 SEQUOIA STREET • DELAVAN, WISCONSIN 53115
262-728-6737



NOTE: BEARINGS ARE REFERENCED TO THE
RECORDED SUBDIVISION PLAT.

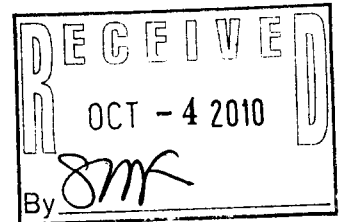


SCALE 1"=30'

LEGEND

- O - IRON PIPE SET
- ⊙ - IRON PIPE FOUND
- BE - BASEMENT ENTRY
- GG - GAS GRILL
- - BIRD HOUSE
- ▲ - ELECTRIC JUNCTION BOX
- X—X— - WOOD RAIL FENCE
- XX—XX— - LOW WIRE FENCE
- XXX—XXX— - SNOW FENCE
- △ - UTILITY POLE
- - UTILITY PED.
- — — - OVERHEAD UTILITY LINES
- () - RECORDED AS

PLAT OF SURVEY OF

LOT 23, BAYWOOD ESTATES, LOCATED IN
T3N, R16E, WALWORTH COUNTY, WISCONSIN.

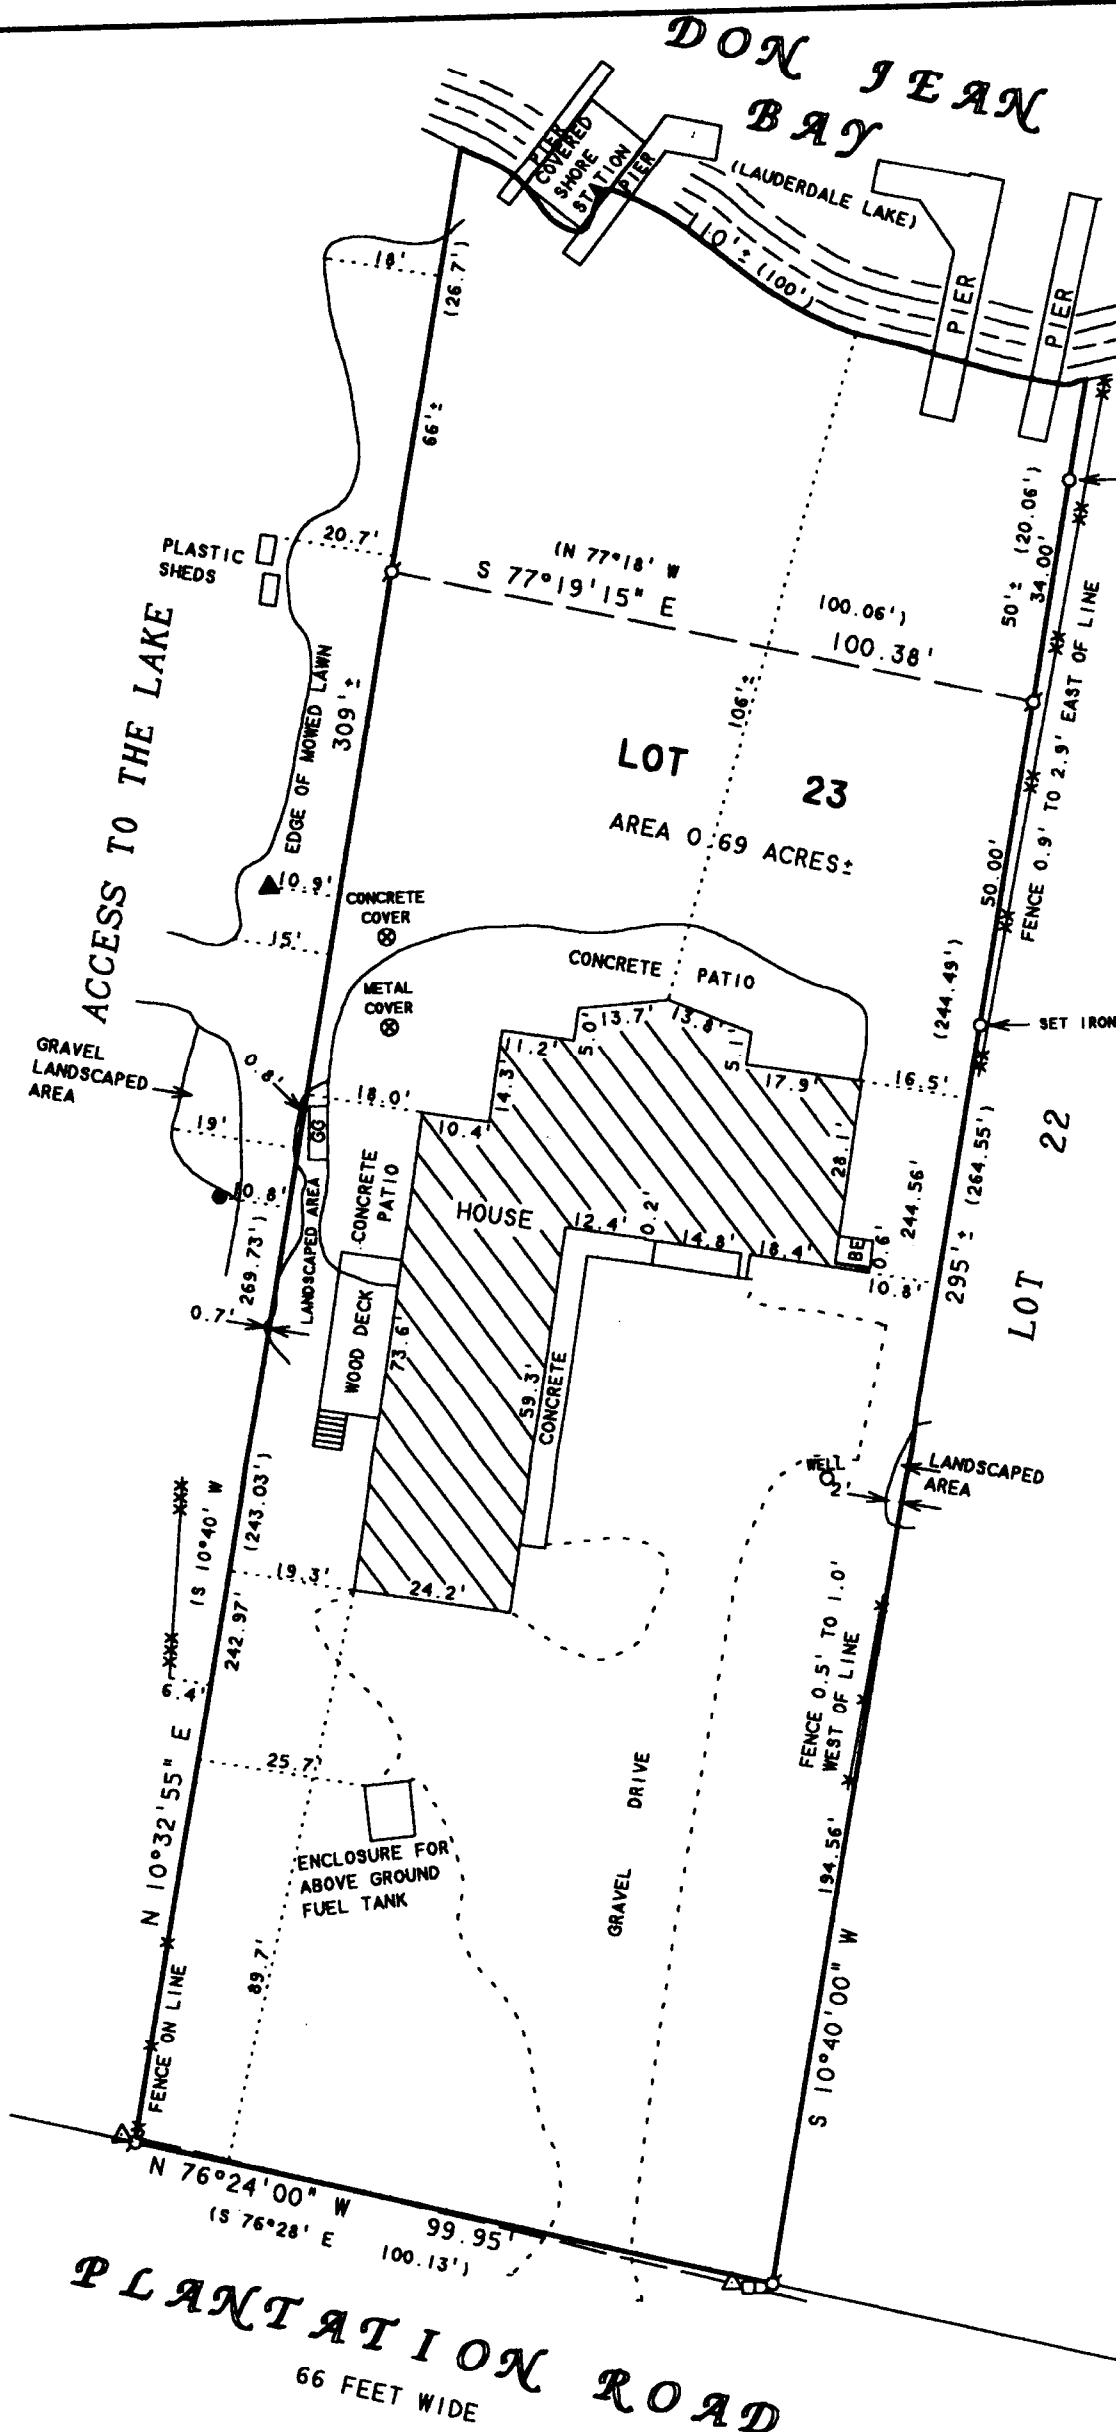

I HEREBY CERTIFY THAT I HAVE SURVEYED THE ABOVE DESCRIBED PROPERTY AND THAT THE
ABOVE MAP IS A TRUE REPRESENTATION THEREOF AND SHOWS THE SIZE AND LOCATION OF
THE PROPERTY, ITS EXTERIOR BOUNDARIES, THE LOCATION OF ALL VISIBLE STRUCTURES
AND DIMENSIONS OF ALL PRINCIPAL BUILDINGS THEREON, BOUNDARY FENCES, APPARENT
EASEMENTS, ROADWAYS AND VISIBLE ENCROACHMENTS, IF ANY, TO THE BEST OF MY
KNOWLEDGE AND BELIEF.

THIS SURVEY IS MADE FOR THE USE OF THE PRESENT OWNERS OF THE PROPERTY, AND ALSO
THOSE WHO PURCHASE, MORTGAGE, OR GUARANTEE THE TITLE THERETO WITHIN ONE (1) YEAR
FROM DATE HEREON.

David F. Abell
DAVID F. ABELL
WISCONSIN REGISTERED LAND SURVEYOR, S-1596

August 11, 2005
DATE

JOB NUMBER - 91087B

NOTE: THIS IS NOT A CERTIFIED COPY UNLESS SEALED.

ORDERED BY: KEEFE REAL ESTATE
P.O. BOX 460
LAKE GENEVA, WI 53147

REVISED: JULY 21, 2010 TO SHOW ADDITIONAL
IRON PIPES SET ALONG EAST LINE.
ORDERED BY: BETH MITCHELL
2936 W. WILSON AVE.
CHICAGO, IL 60625

316-2061