

PREPARED FOR:
KEEFE REAL ESTATE
TOM MARTIN
1040 N. WISCONSIN ST
ELKHORN, WI 53212



PLAT OF SURVEY

- OF -

PATHFINDER SURVEYING INC.
(formerly)
J.K. SURVEYING INC.
P.O. BOX 322
LAKE GENEVA, WI. 53147
WWW.PATHFINDERSURVEYING.NET
262-248-8303

LOT 19, BLOCK 4 OF LAKE WANDAWEGA HIGHLANDS FIRST ADDITION,
LOCATED IN SECTIONS 11 AND 12, TOWN 3 NORTH, RANGE 16 EAST,
WALWORTH COUNTY WISCONSIN.

ALSO THE WEST 1/2 OF TECUMSHE TRAIL, LYING EASTERLY AND
ADJACENT TO THE ABOVE DESCRIBED PARCEL.

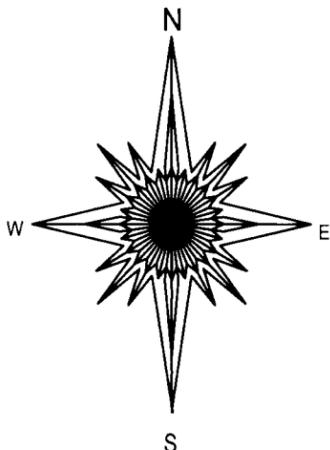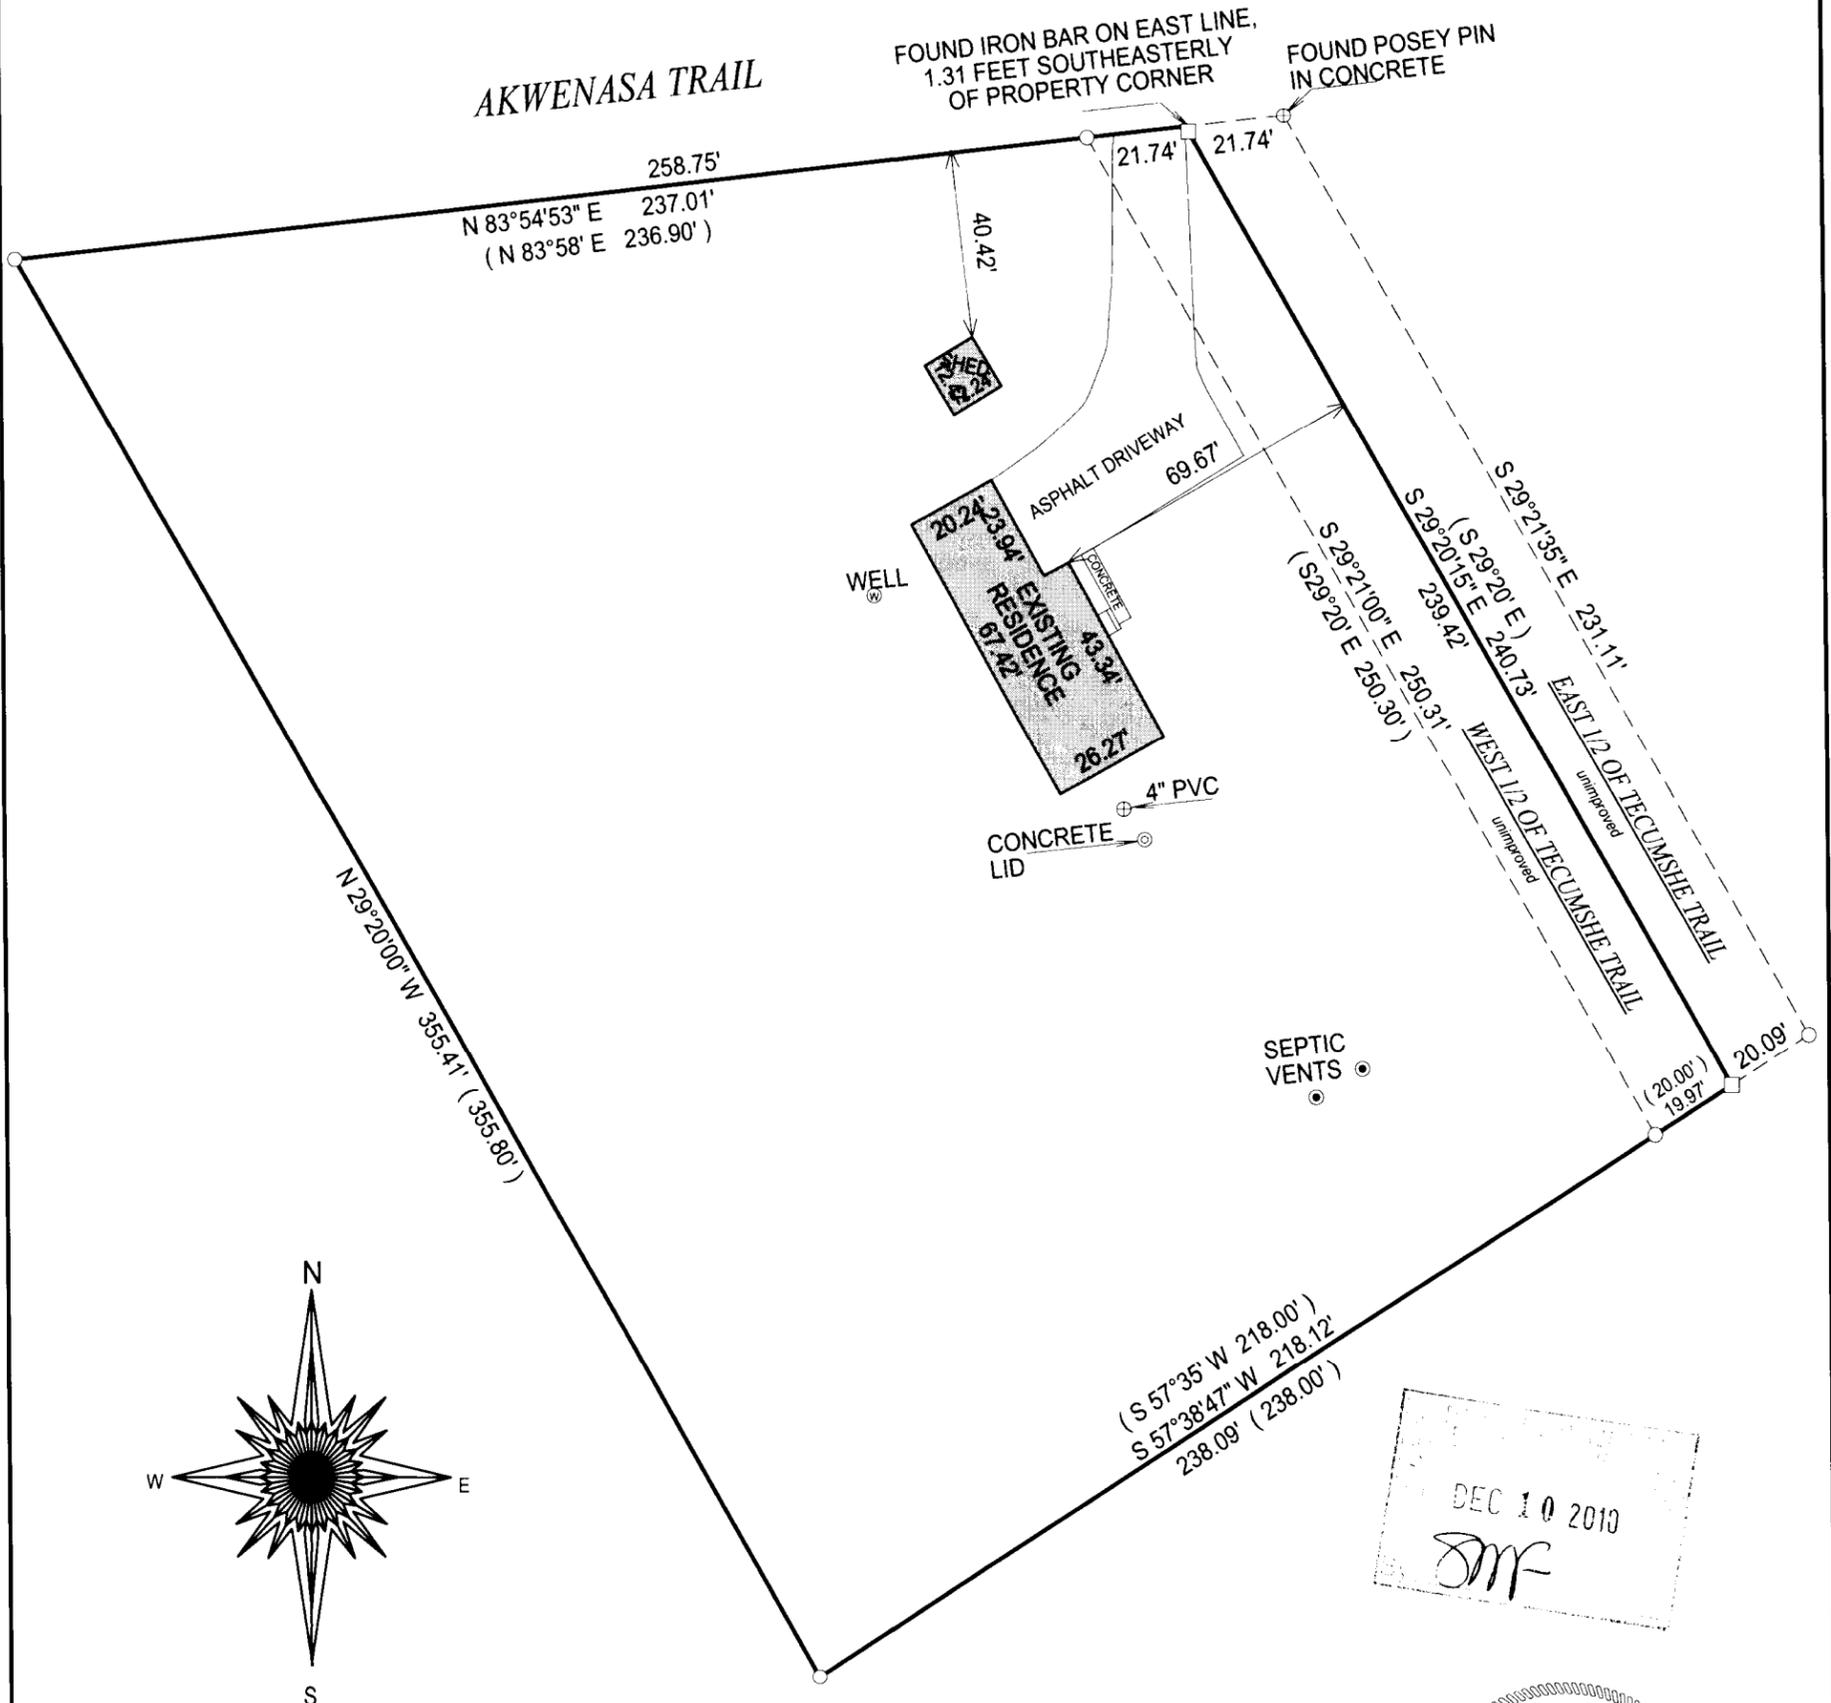

DEC 10 2010
JMK

- () = recorded as
- = found iron bar
- = found iron pipe
- = set iron pipe
- = set iron bar

NOTE: THE BASIS OF BEARING IS : THE WEST LINE OF LOT
19, BLOCK 4 WAS ASSUMED TO BEAR N 29°20' E AS SHOWN
ON THE RECORD PLAT.

SCALE 1" = 40'



"I hereby certify that I have surveyed the above described property and that the above
map is a true representation of its exterior boundary and shows the size and location of
all visible structures, apparent easements and encroachments if any."

This survey is made for the present owners of the property, and those who
purchase, mortgage, or guarantee the title thereto, within one year from
the date hereof.

JOB # 10-138

TAX ID # GWHA 00093

DATED THIS 15th, DAY OF SEPTEMBER, 2010.



Jeffrey L. Kimps
JEFFREY L. KIMPS S - 2436
Wisconsin Registered Land Surveyor
(original if signed in red)

311-2010