


EXCEPTING therefrom the North 8 feet.

N6884 Avataia Trail
Elkhorn, Wisconsin. 53121

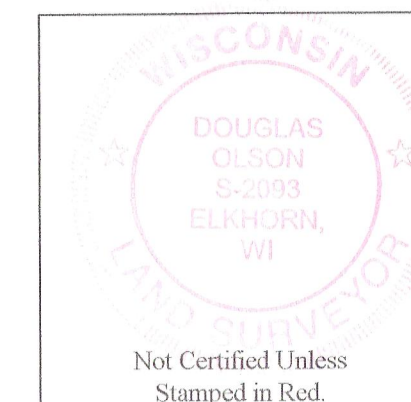

Wisconsin Street * P.O. Box 322 * Elk Horn, Wisconsin. 53121
Telephone: (262) 723-3434 * Facsimile: (262) 723-8044
Email: jensen.olson@elknet.net

Survey Date: Sept. 16, 2011.
Revisions: No. 1 - Proposed House
No. 2 - House under construction

Scale in Feet
1" = 20'



Legend

Sheet 1 of 1 Sheets

Job Reference Number

2011.114

Drawing Name: Gmr16e-20111114-20111114Plat.scd

2011.114

(50' Wide)

119.97'

House
Under Construction

0.529	Acre
23,037	Sq.Ft.

**Reservation for "WATER
SUPPLY AND PLAYGROUND
PURPOSES"** restriction has
been removed by Affidavit of
Correction recorded October
21, 2011, as Doc. No. 824396.

Also
City Easement
ed Sept. 23, 2003,
c. No. 576808.

Also
Utility Easement (50' Wide)

Recorded Sept. 23, 2003,
in Doc. No. 576808.

10' Common Force Main Area
Doc. No. 576808.

Edge of mown grass
Edge of corn field

B l o c k

Approximate location of Unit 40
Doc. No. 576808.

Approximate location of Unit 41
Doc. No. 576808.

Approximate location of Unit 43
Doc. No. 576808.

Copyright 2011 by Jensen & Olson Land Surveying, LLC.

All rights reserved. No part of this survey plat may be reproduced or transmitted in any form by any means - graphic, electronic, or mechanical, including photocopying, tracing, or information storage and retrieval systems - without permission in writing from Douglas G. Olson, Jensen & Olson Land Surveying, LLC.

I hereby certify that I have surveyed the above described property and the map hereon is correct to the best of my professional knowledge and belief and shows the size and location of the property, its exterior boundaries, the location and dimensions of all visible structures thereon, boundary fences, apparent easements and roadways and visible encroachments, if any.

This survey is made for the exclusive use of the present owners of the property, and also those who purchase, mortgage or guarantee title thereto, within one year from the date hereof.

Douglas G. Olson
Wisconsin Registered Land Surveyor - 2093

GI 658B

316-2104