


PLAT OF SURVEY
OF THE NORTH, EAST AND SOUTH LINES OF

EMAIL: ambit@tds.net

PARCEL IDENTIFICATION NO.: GLW 00359

WISCONSIN STATUTES ESTABLISHES THE ORDINARY HIGH WATER MARK AS THE LEGAL BOUNDARY ALONG WATERFRONT PROPERTIES. THE WI. DEPT. OF NATURAL RESOURCES AND WALLWORTH COUNTY HAD NO ESTABLISHED O.H.W.M. ELEVATION FOR LAKE WANDAMEGA. THE WATER LINE ELEVATION IS GRAPHICALLY DEPICTED TO GIVE AN IDEA OF THE LAKE LOCATION ADJACENT TO BLOCK 118.

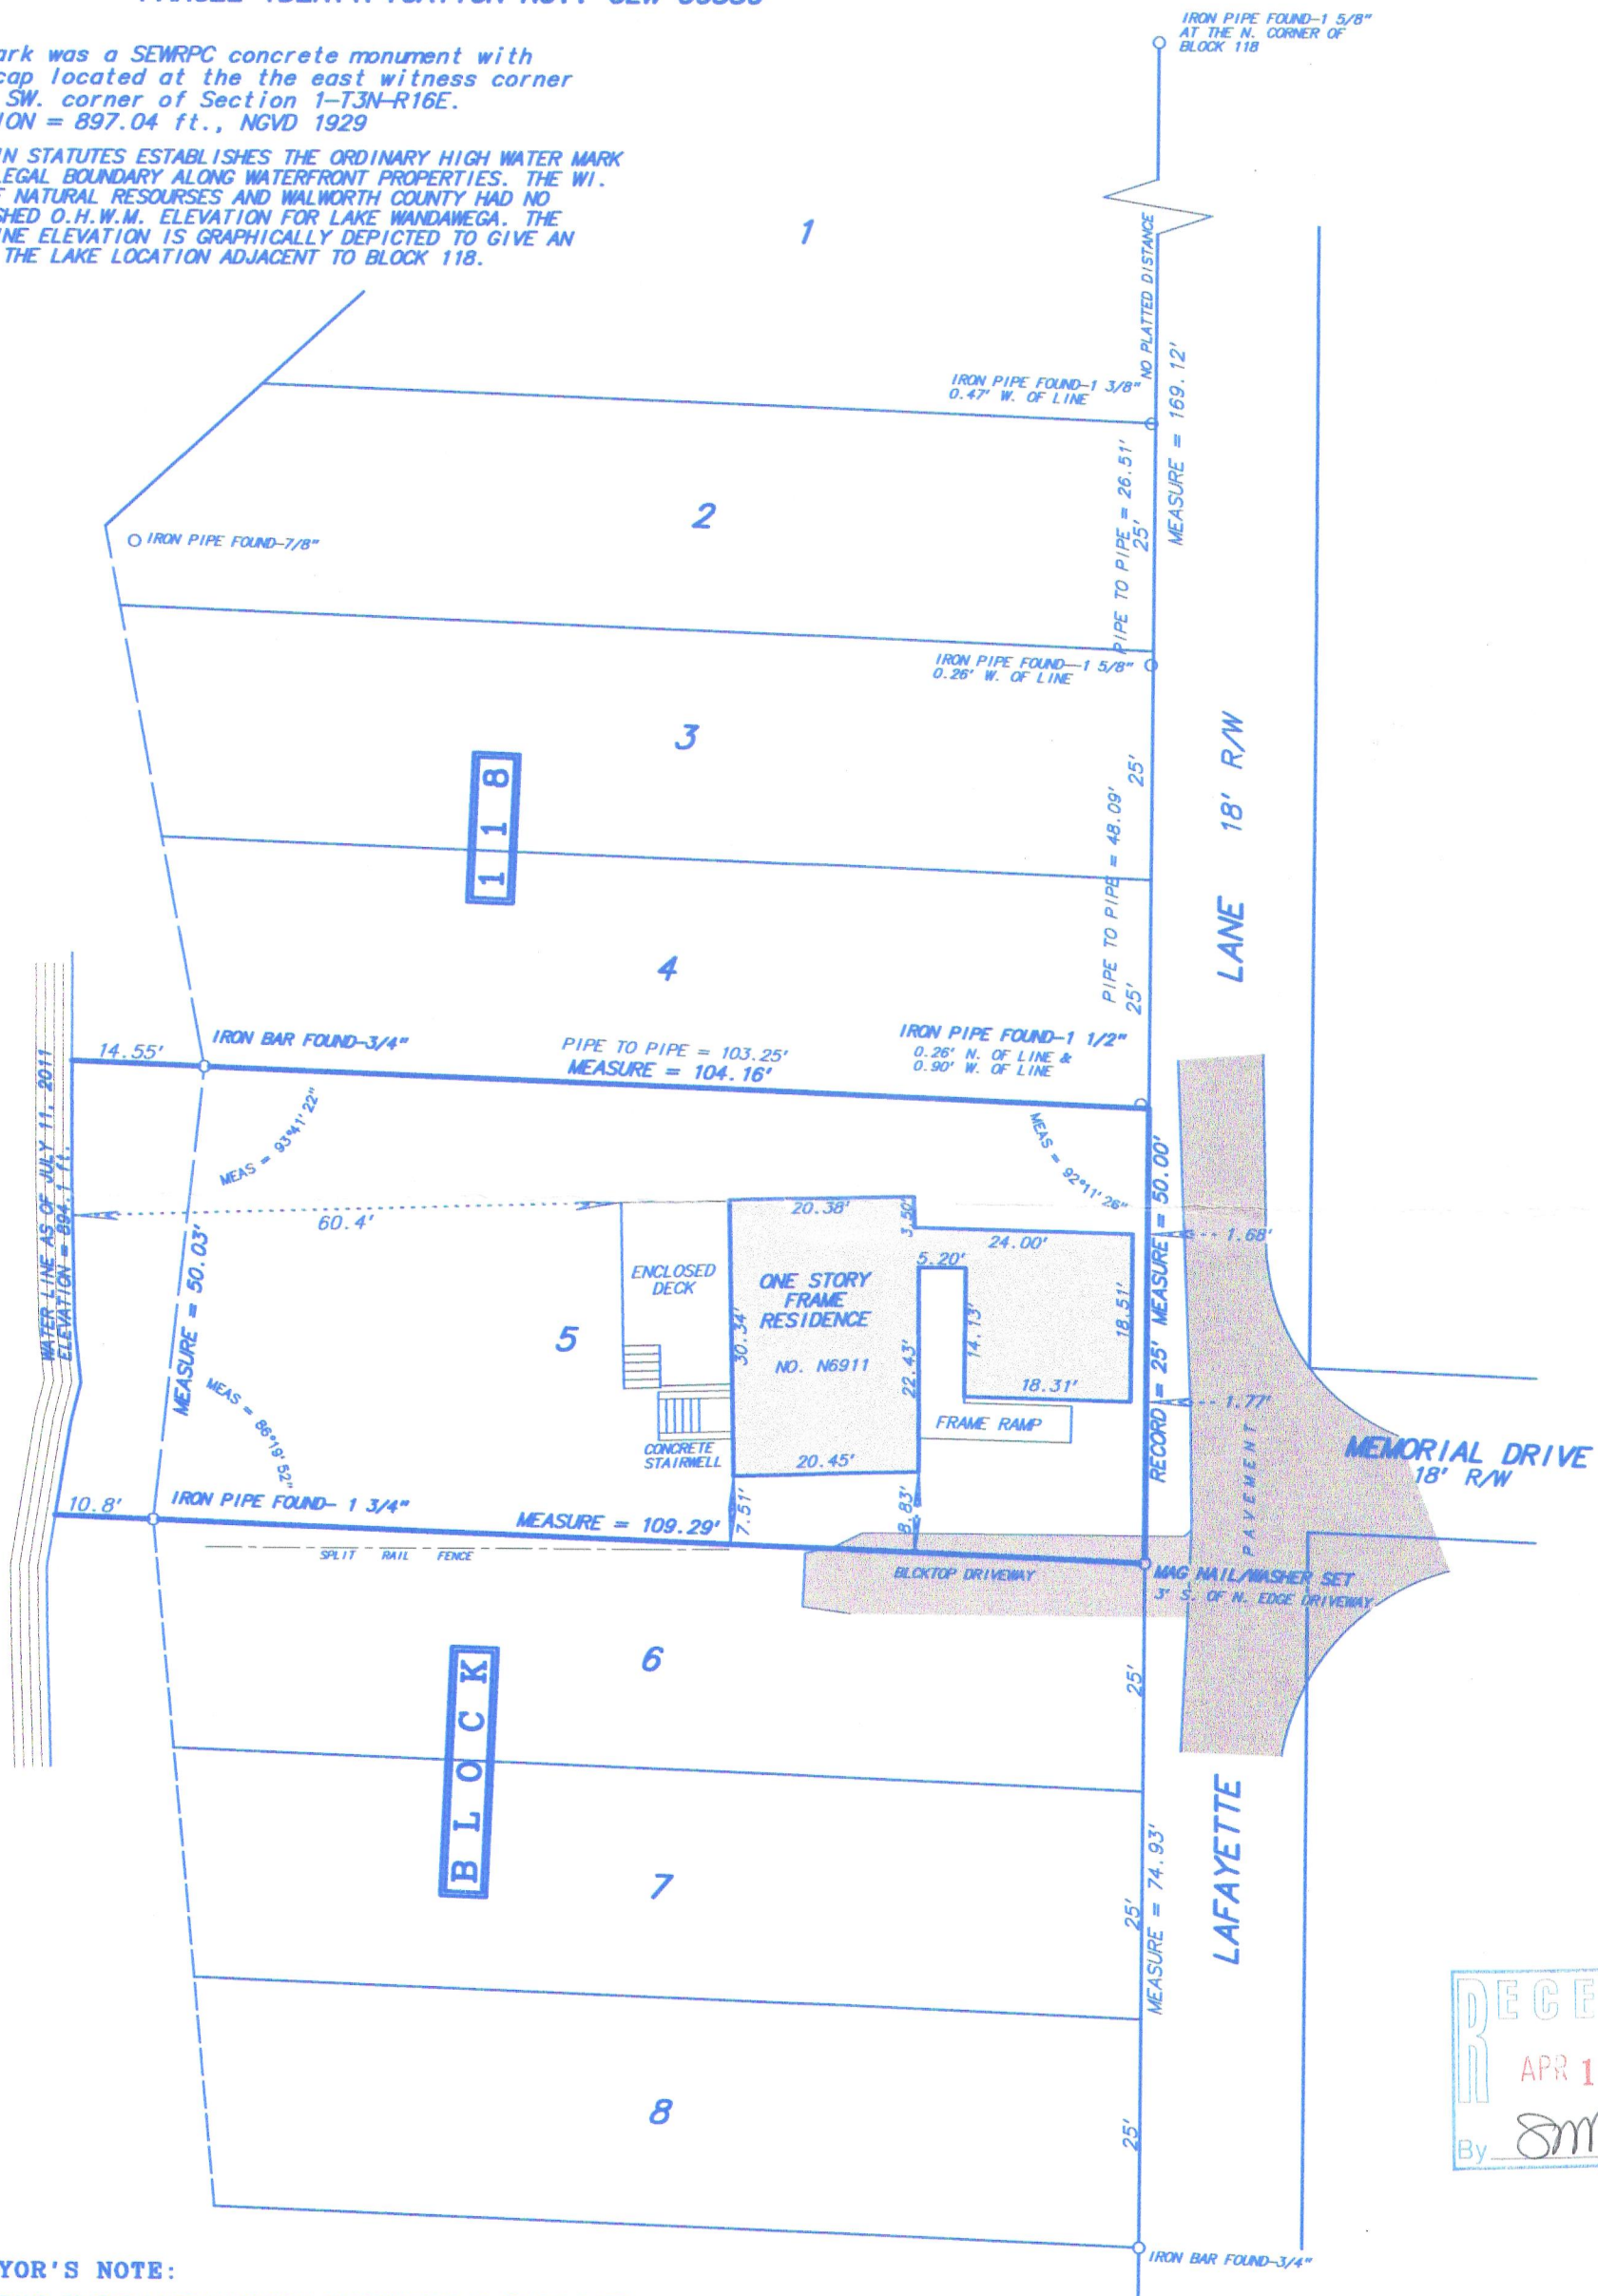

RECEIVED
APR 19 2012
By SMF

ACCORDING TO THE LAKE WANDAMEGA SUBDIVISION PLAT ALL LOTS ARE 25' x 100' UNLESS OTHERWISE NOTED. LOT 5, BLOCK 118 WAS SURVEYED BY JOSEPH M. BIAGI ON AUGUST 30, 1950 AND SAID SURVEY HAD LOT 5 WITH A WIDTH OF 50 FEET AND ALL REMAINING LOTS IN BLOCK 118 WITH A WIDTH OF 25 FEET WITH THE EXCEPTION OF LOT 1. NO EXPLANATION IS GIVEN BY MR. BIAGI OTHER THAN STATING THE SURVEY WAS MADE ACCORDING TO THE OFFICIAL RECORDS. THERE IS NO INDICATION ON THE SUBDIVISION PLAT THAT SAID LOT 5 WAS TO BE A 50 FOOT WIDE LOT.

I hereby certify that I have surveyed the above described property and the above plat is a true representation thereof and shows the size and location of the property, its exterior boundaries, the location and dimensions of all visible structures thereon, boundary fences, apparent easements and roadways and visible encroachments, if any.

This survey is made for the exclusive use of the present owners of the property, and also those who purchase, mortgage or guarantee the title thereto within ONE YEAR from the date hereof.

Dated at Bassett, Wisconsin this 18th day of JULY 2011.

Mark A. Bolender
Mark A. Bolender
Wisconsin Registered Land Surveyor S - 1784

SCALE: 1 inch = 20 feet
ORDERED BY: K. Lewis / Lewis & Levinson
JOB NO.: 1 1 0 5 9

GLW-359

316-2109