


PREPARED FOR:
DIANE KRAUSE
SHORWEST REALTY
LAKE GENEVA, WI. 53147

PLAT OF SURVEY


- OF -

PATHFINDER SURVEYING INC.
(formerly)
J.K. SURVEYING INC.
P.O BOX 322
LAKE GENEVA, WI. 53147
WWW.PATHFINDERSURVEYING.NET
262-248-8303

LOT 2, BLOCK 10 COOL HILL PARK ADDITION No. 1, LOCATED IN THE SW 1/4 OF SECTION 35, TOWN 4 NORTH, RANGE 16 EAST AND IN THE NW 1/4 OF SECTION 2 AND THE NE 1/4 OF SECTION 3, TOWN 3 NORTH, RANGE 16 EAST, WALWORTH COUNTY, WISCONSIN.

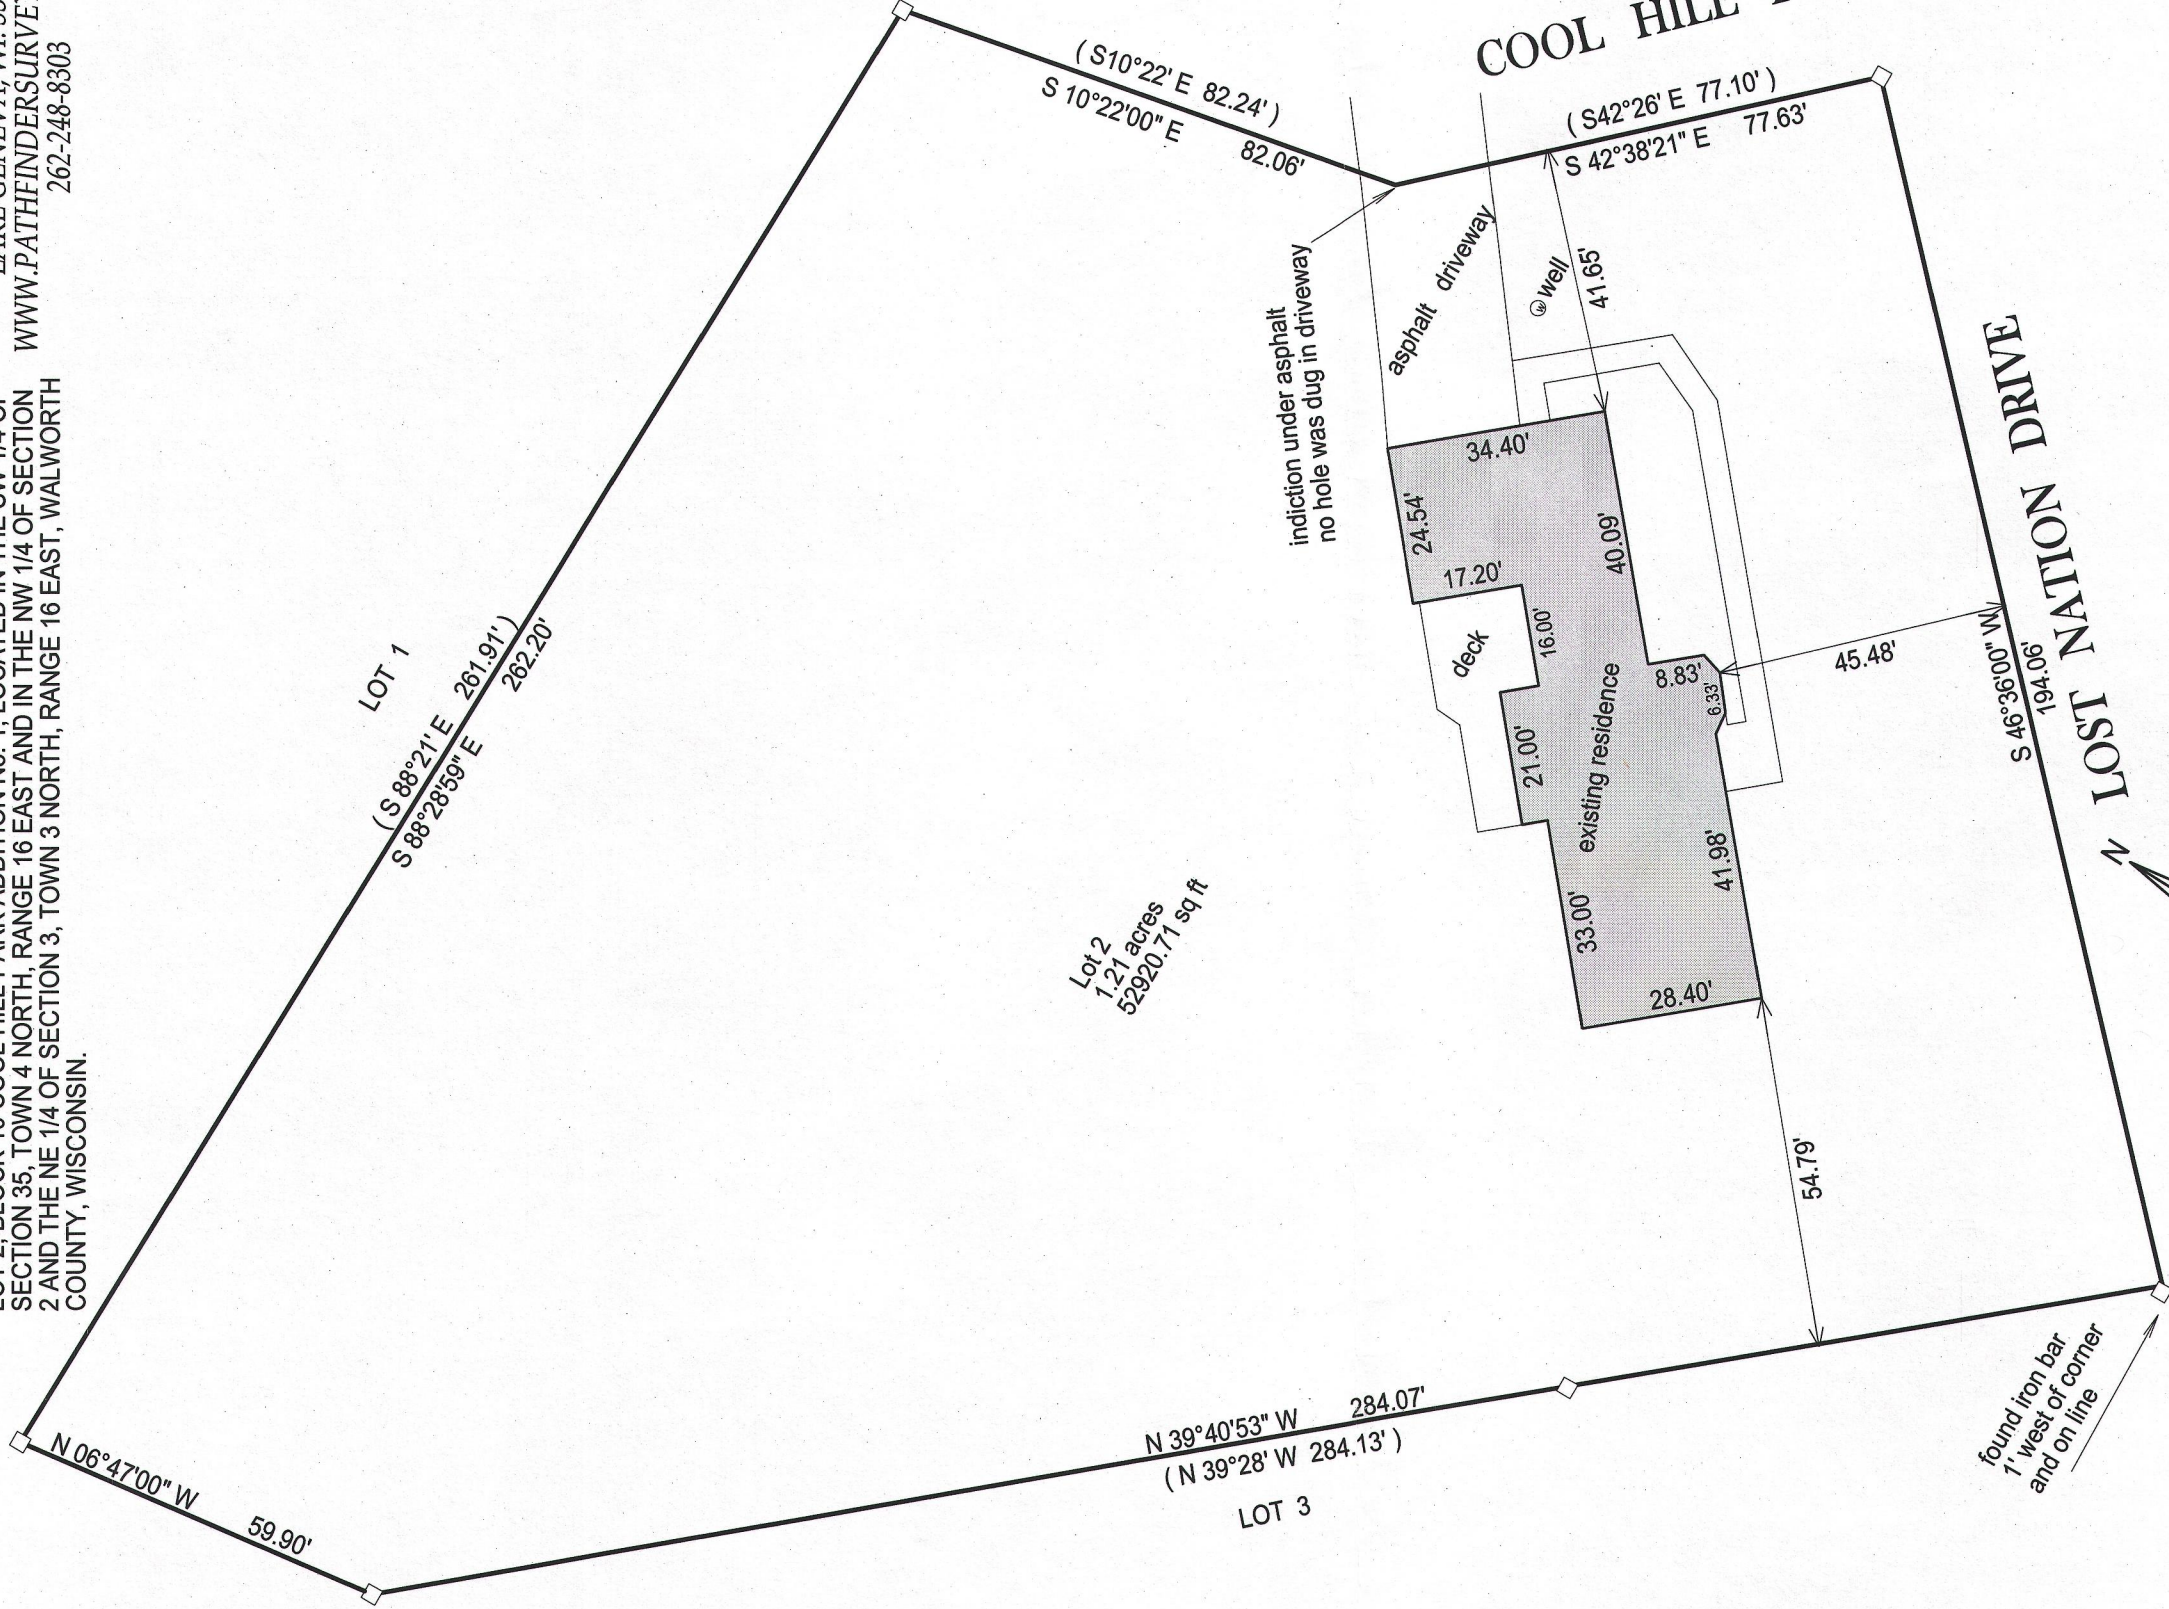

BASIS OF BEARING OF THIS PLAT: THE WEST LINE OF COOL HILL DRIVE WAS ASSUMED TO BEAR S10°22' E AS RECORDED ON THE RECORD SUBDIVISION PLAT.

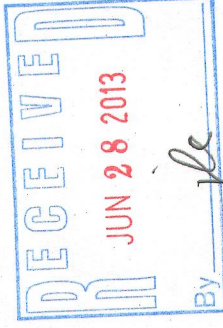

I hereby certify that I have surveyed the above- described property and the above map is a true representation thereof and shows the size and location of the property, its exterior boundaries, the location and dimensions of all structures thereon, fences, appariant easements and roadways and visible encroachments if any.

This survey is made for the present owners of the property, and those who purchase, mortgage, or guarantee the title thereto, within one year from the date hereof.

DATED THIS 6TH DAY OF MAY, 2013.

- () = recorded as
- = found iron bar
- = found iron pipe
- = set iron pipe
- = set iron bar

SCALE 1" = 30'

JOB # 13-47

TAX ID #
GCHA 00002

JEFFREY L KIMPS S - 2436
Wisconsin Registered Land Surveyor
(original if signed in red)

316-2144