


PREPARED FOR
ROBERT PESKA
W5127 HAWKHUNTER RD.
ELKHORN WI. 53121

PLAT OF SURVEY

KROTT SURVEYING INC.
N3705 WILLOW BEND LANE
LAKE GENEVA WI. 53147
PHONE # (262)248-3697
FAX # (262)249-0639

-OF-

LOTS 28, 29 AND 30, BLOCK 102, LAKE WANDAWEGA SUBDIVISION, LOCATED
IN SECTIONS 1 AND 2, TOWN 3 NORTH, RANGE 16 EAST, TOWN OF SUGAR CREEK
WALWORTH COUNTY, WISCONSIN.

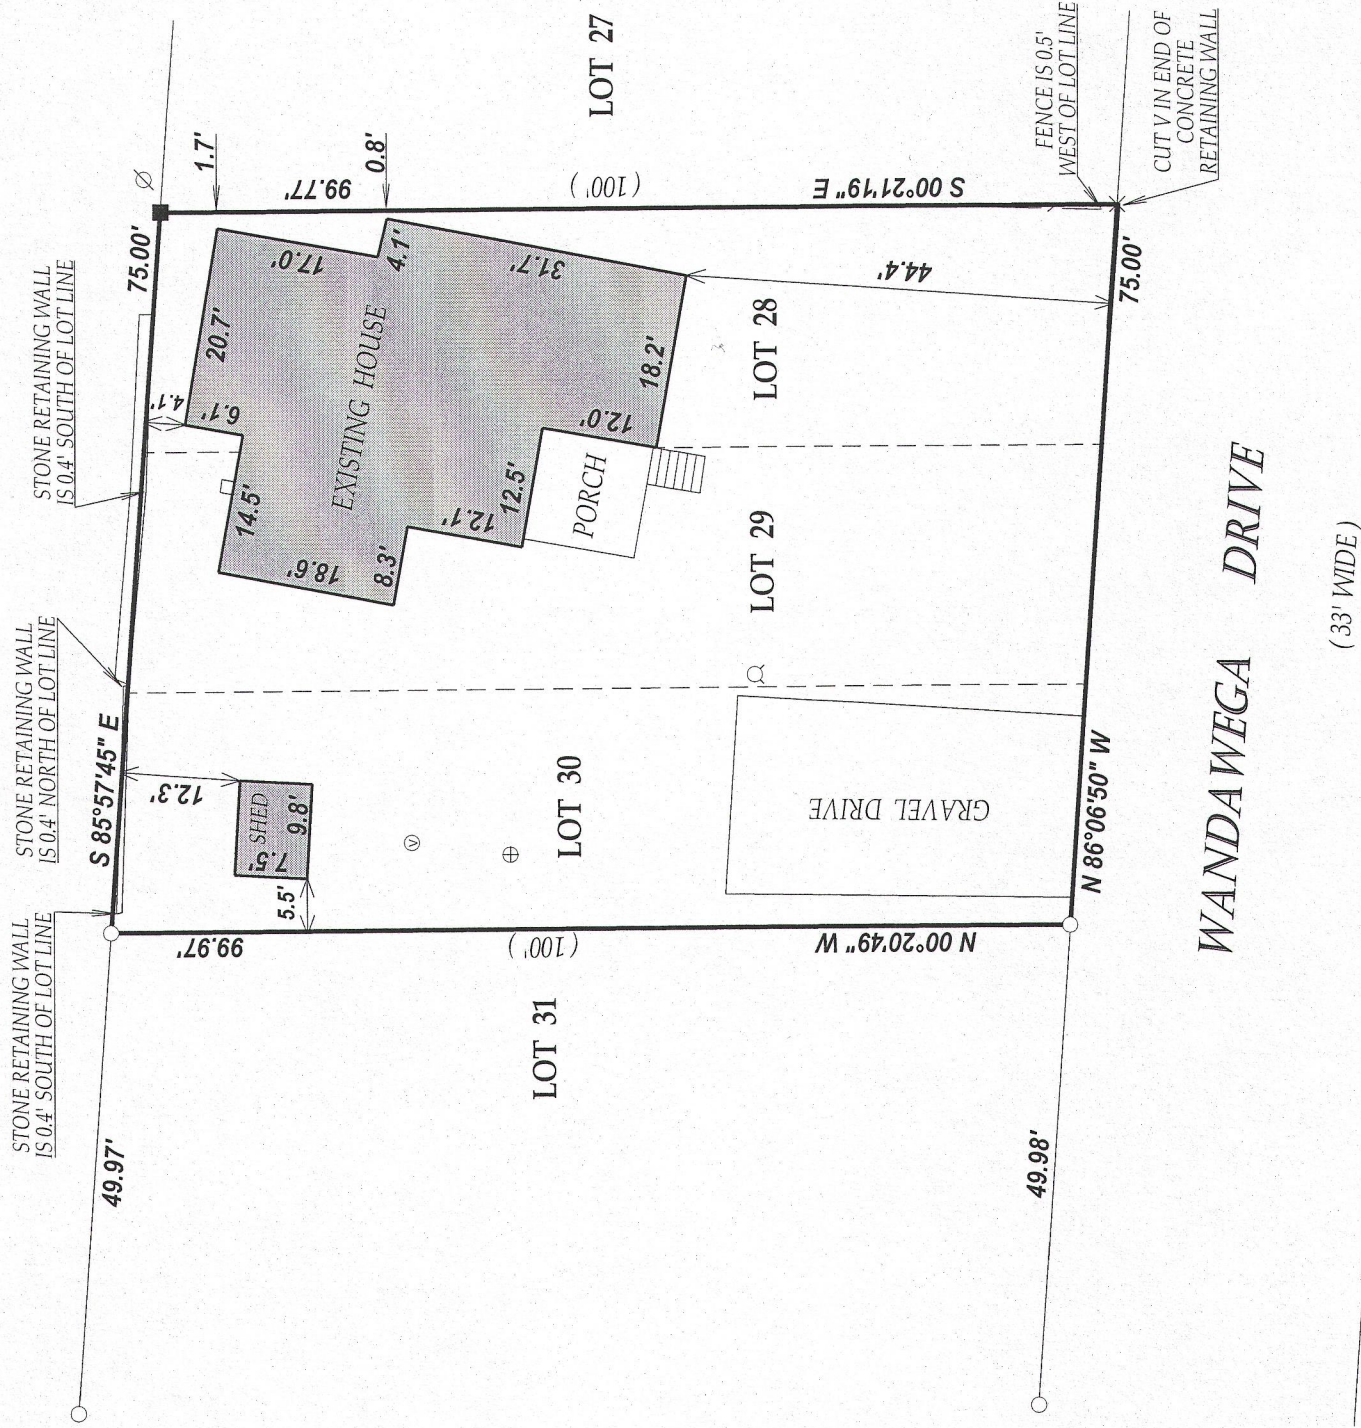


LEGEND


- FOUND IRON PIPE
- SET IRON BAR
- ⊕ CONCRETE ACCESS COVER
- ⊙ VENT
- ⊘ WELL
- ⊙ UTILITY POLE
- ⊗ RECORDED AS

TAX ID # GLW00239

JOB # 13-053

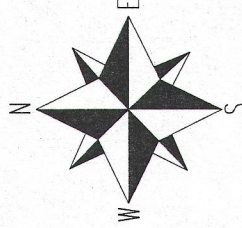


SCALE 1" = 20'

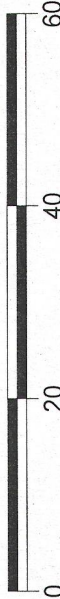

NOTE: BEARINGS ARE REFERENCED TO PREVIOUS SURVEY RECORDS

I have surveyed the above-described property and the above map is a true representation thereof and shows the size and location of the property, its exterior boundaries, the location and dimensions of all structures thereon, fences apparent easements and roadways and visible encroachments, if any.

This survey is made for the exclusive use of the present owners of the property, and also those who purchase, mortgage, or insure the title thereto within one (1) year from date hereof, and as to them I warrant the accuracy of said survey map.

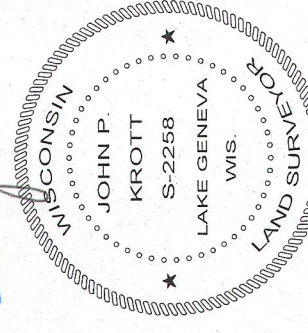

DATED THIS 6th DAY OF MAY 2013

John P. Krott

JOHN KROTT S - 2258
Wisconsin Registered Land Surveyor
(original if signed in red)

316-2146