


FARRIS, HANSEN & ASSOC. INC.

7 RIDGWAY COURT- P.O. BOX 437
ELKHORN, WISCONSIN 53121
PHONE (262) 723-2098
FAX (262) 723-5886

PLAT OF SURVEY

LOTS 10 THRU 14 OF BLOCK 122 LAKE WANDAWEGA SUBDIVISION
LOCATED IN THE SW 1/4 SECTION 1, TOWN 3 NORTH, RANGE 16 EAST
WALWORTH COUNTY, WISCONSIN

MEMORIAL PARK DRIVE (18' WIDE)

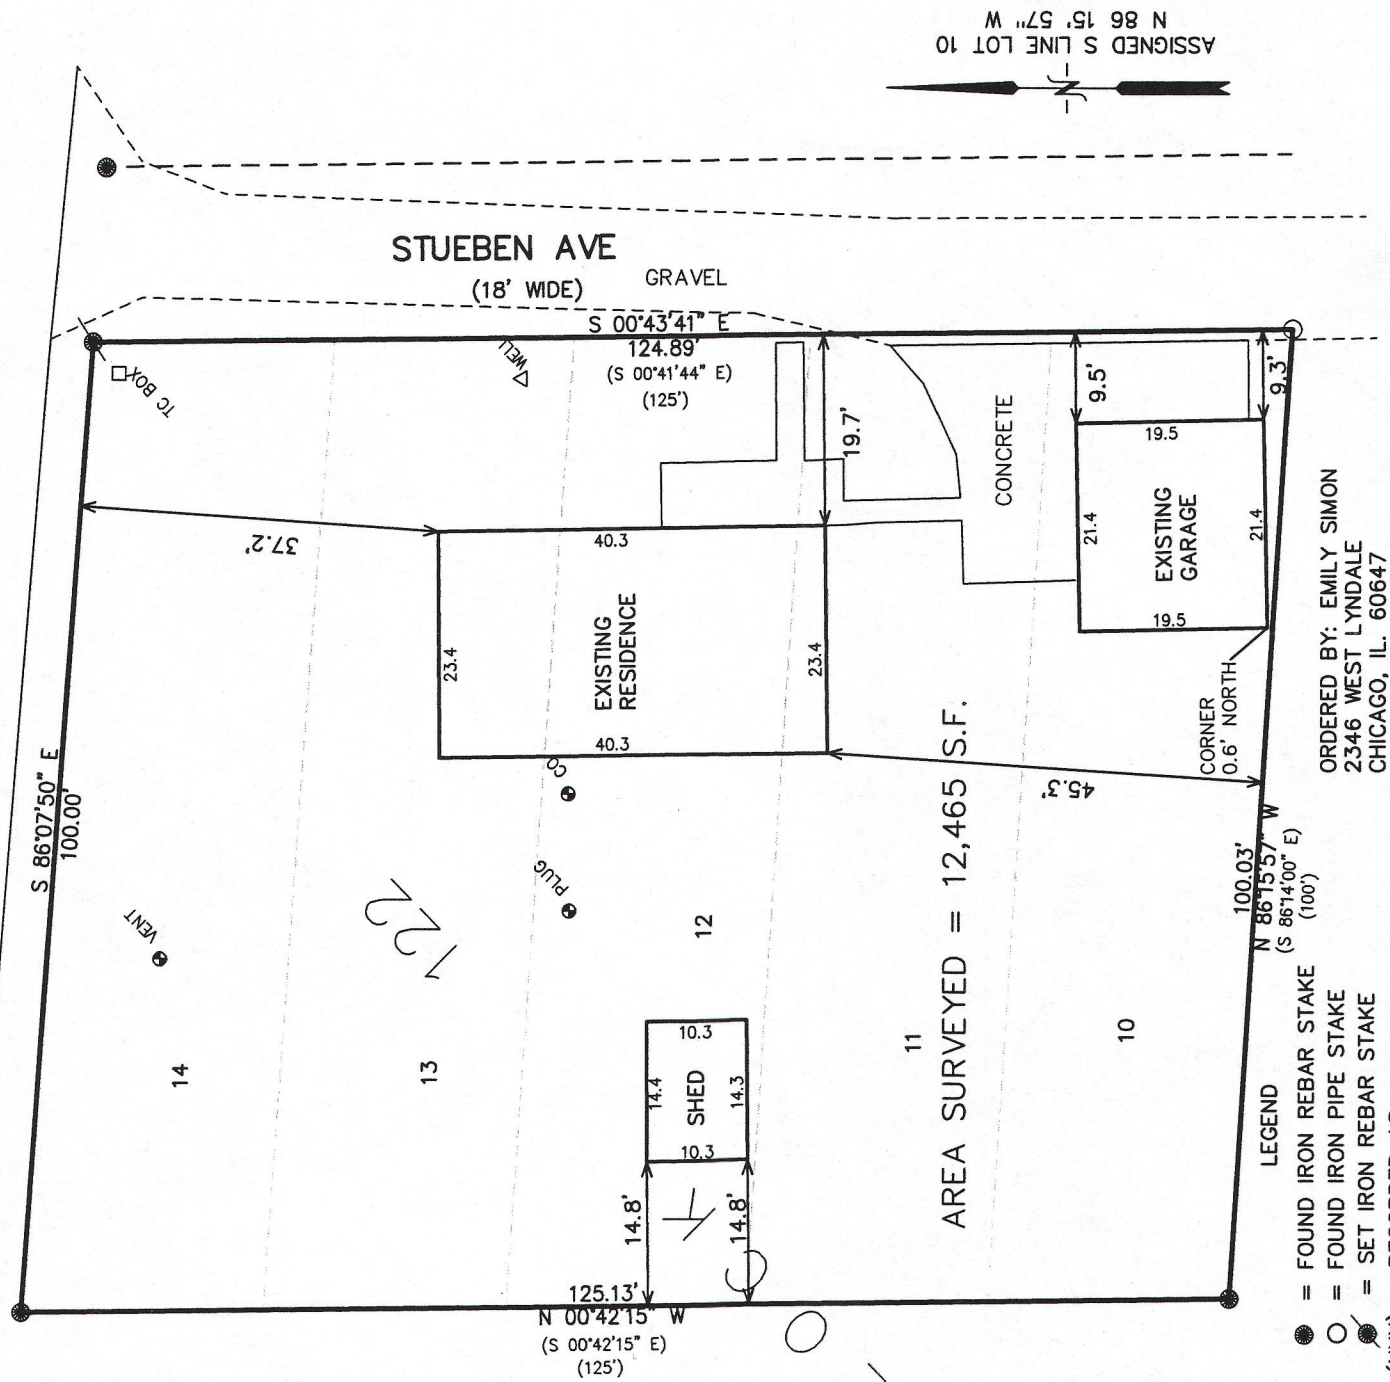

N 86°15'57" W
ASSIGNED S LINE LOT 10

LEGEND

- = FOUND IRON REBAR STAKE
- = FOUND IRON PIPE STAKE
- ⦿ = SET IRON REBAR STAKE
- (XXX) = RECORDED AS

ORDERED BY: EMILY SIMON
2346 WEST LYNDALE
CHICAGO, IL. 60647

NOTE: COPIES OF THIS MAP TO WHICH THE FOLLOWING CERTIFICATE WILL APPLY SHOW SURVEYOR'S ORIGINAL SEAL AND SIGNATURE IN RED INK. COPIES BY ANY OTHER MEANS MAY HAVE ALTERATIONS WHICH DO NOT REPRESENT THE SURVEYOR'S WORK PRODUCT.



I HEREBY CERTIFY THAT THE ABOVE DESCRIBED PROPERTY HAS BEEN SURVEYED UNDER MY DIRECTION AND THAT THE ABOVE MAP IS A TRUE REPRESENTATION THEREOF AND SHOWS THE SIZE AND LOCATION OF THE PROPERTY AND ITS EXTERIOR BOUNDARIES. THIS SURVEY IS MADE FOR THE USE OF THE PRESENT OWNERS OF THE PROPERTY, AND ALSO THOSE WHO PURCHASE, MORTGAGE, OR GUARANTEE THE TITLE THERETO WITHIN ONE YEAR FROM THE DATE HEREOF.

DATED: JUNE 20, 2013

Peter S. Gordon

PETER S. GORDON R.L.S. 2101

PROJECT NO. 8820
DATED: 06-20-2013
SHEET 1 OF 1 SHEETS

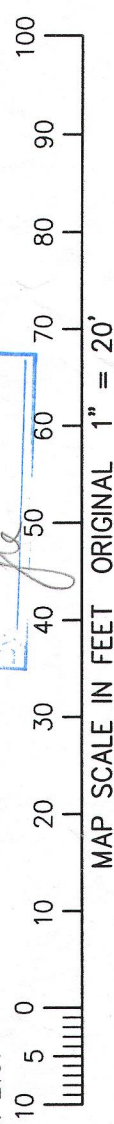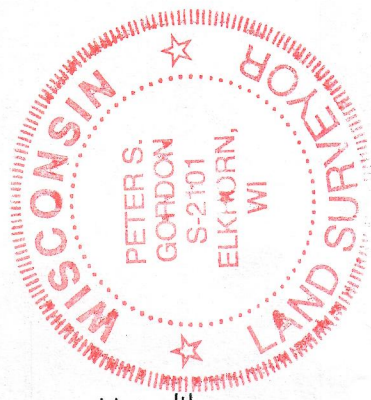

JUN 20 2013

GLW-375

316-2147