

Don

Jean

Bay

Plat of Survey

of

Lot 22 of Baywood Estates,


a subdivision located in the Northeast 1/4 of Section 2, Town 3 North,
Range 16 East, Town of Sugar Creek, Walworth County, Wisconsin.

Surveyed for:

Coldwell Banker, Leith & Associates


102 North Wisconsin Street
Elkhorn, Wisconsin. 53121

Lot 23

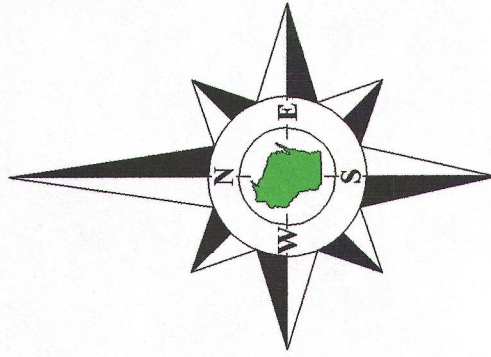

Bearings reference to the
plat of Baywood Estates.

Lot 21

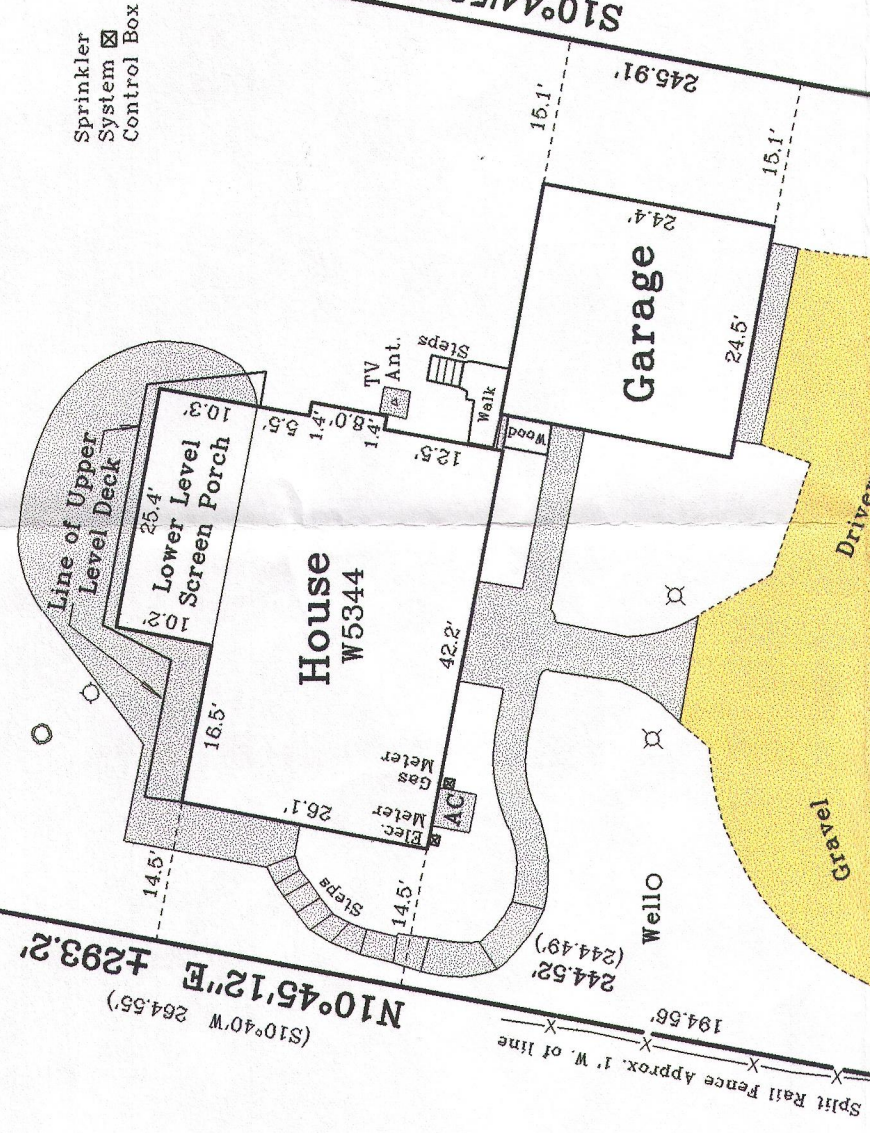

Lot 22

Tax Parcel

GBE 00022

0.672 Acre

29,287 Sq.Ft.

(N76°28'W 100.13')
N76°27'03"W 99.86'

N76°36'15"W 100.08'
(N76°28'W 100.13')
Overhead Wires

Plantation Road
(66' Wide)



Notes:

- 1) This survey plat is not certified unless signed and sealed in red ink.
- 2) This survey is subject to Wisconsin lien laws. This Plat of Survey is the notice of intent to file lien. Lien waiver required.

Copyright 2013 by Jensen & Olson Land Surveying, LLC.

All rights reserved. No part of this survey plat may be reproduced or transmitted in any form by any means - graphic, electronic, or mechanical, including photocopying, tracing, or information storage and retrieval systems - without permission in writing from Douglas G. Olson, Jensen & Olson Land Surveying, LLC.

I hereby certify that I have surveyed the above described property and the map hereon is correct to the best of my professional knowledge and belief and shows the size and location of the property, its exterior boundaries, the location and dimensions of all visible structures thereon, boundary fences, apparent easements and roadways and visible encroachments, if any.

This survey is made for the exclusive use of the present owners of the property, and also those who purchase, mortgage or guarantee title thereto, within one year from the date hereof.

Douglas G. Olson
Wisconsin Registered Land Surveyor - 2093

Sheet 1 of 1 Sheets

Drawing Name: Sht 16-2013087-2013087(Plat.sj)

Job Reference Number

2013.087

Legend

- Found Iron Pipe
- Found Iron Rod
- Recorded Information
- Utility Pole
- Concrete Cover
- Asphalt Surface
- Lamp
- Pedestal
- Septic Vent
- Sprinkler
- Gravel

Jensen & Olson Land Surveying, LLC

45 South Wisconsin Street * P.O. Box 322 * Elkhorn, Wisconsin. 53121


Telephone: (262) 723-3434 * Facsimile: (262) 723-8044

Email: jensen.olson@elknet.net

Survey Date: August 2, 2013.

Revisions:

Scale in Feet
1" = 20'

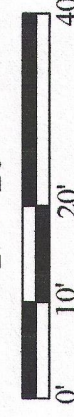

2013.087

316-2149