


PREPARED FOR
MIKE COLLINS


PLAT OF SURVEY

PATHFINDER SURVEYING INC.
(formerly)
J.K. SURVEYING INC.
P.O BOX 322
LAKE GENEVA, WI. 53147
WWW.PATHFINDERSURVEYING.NET
262-248-8303

- OF -
LOS 1 - 6 AND LOTS 43 - 46, BLOCK 109 OF LAKE WANDAWEGA
SUBDIVISION, LOCATED IN THE SW 1/4 OF SECTION 1, TOWN 3
NORTH, RANGE 16 EAST, TOWN OF SUGAR CREEK, WALWORTH
COUNTY, WISCONSIN.

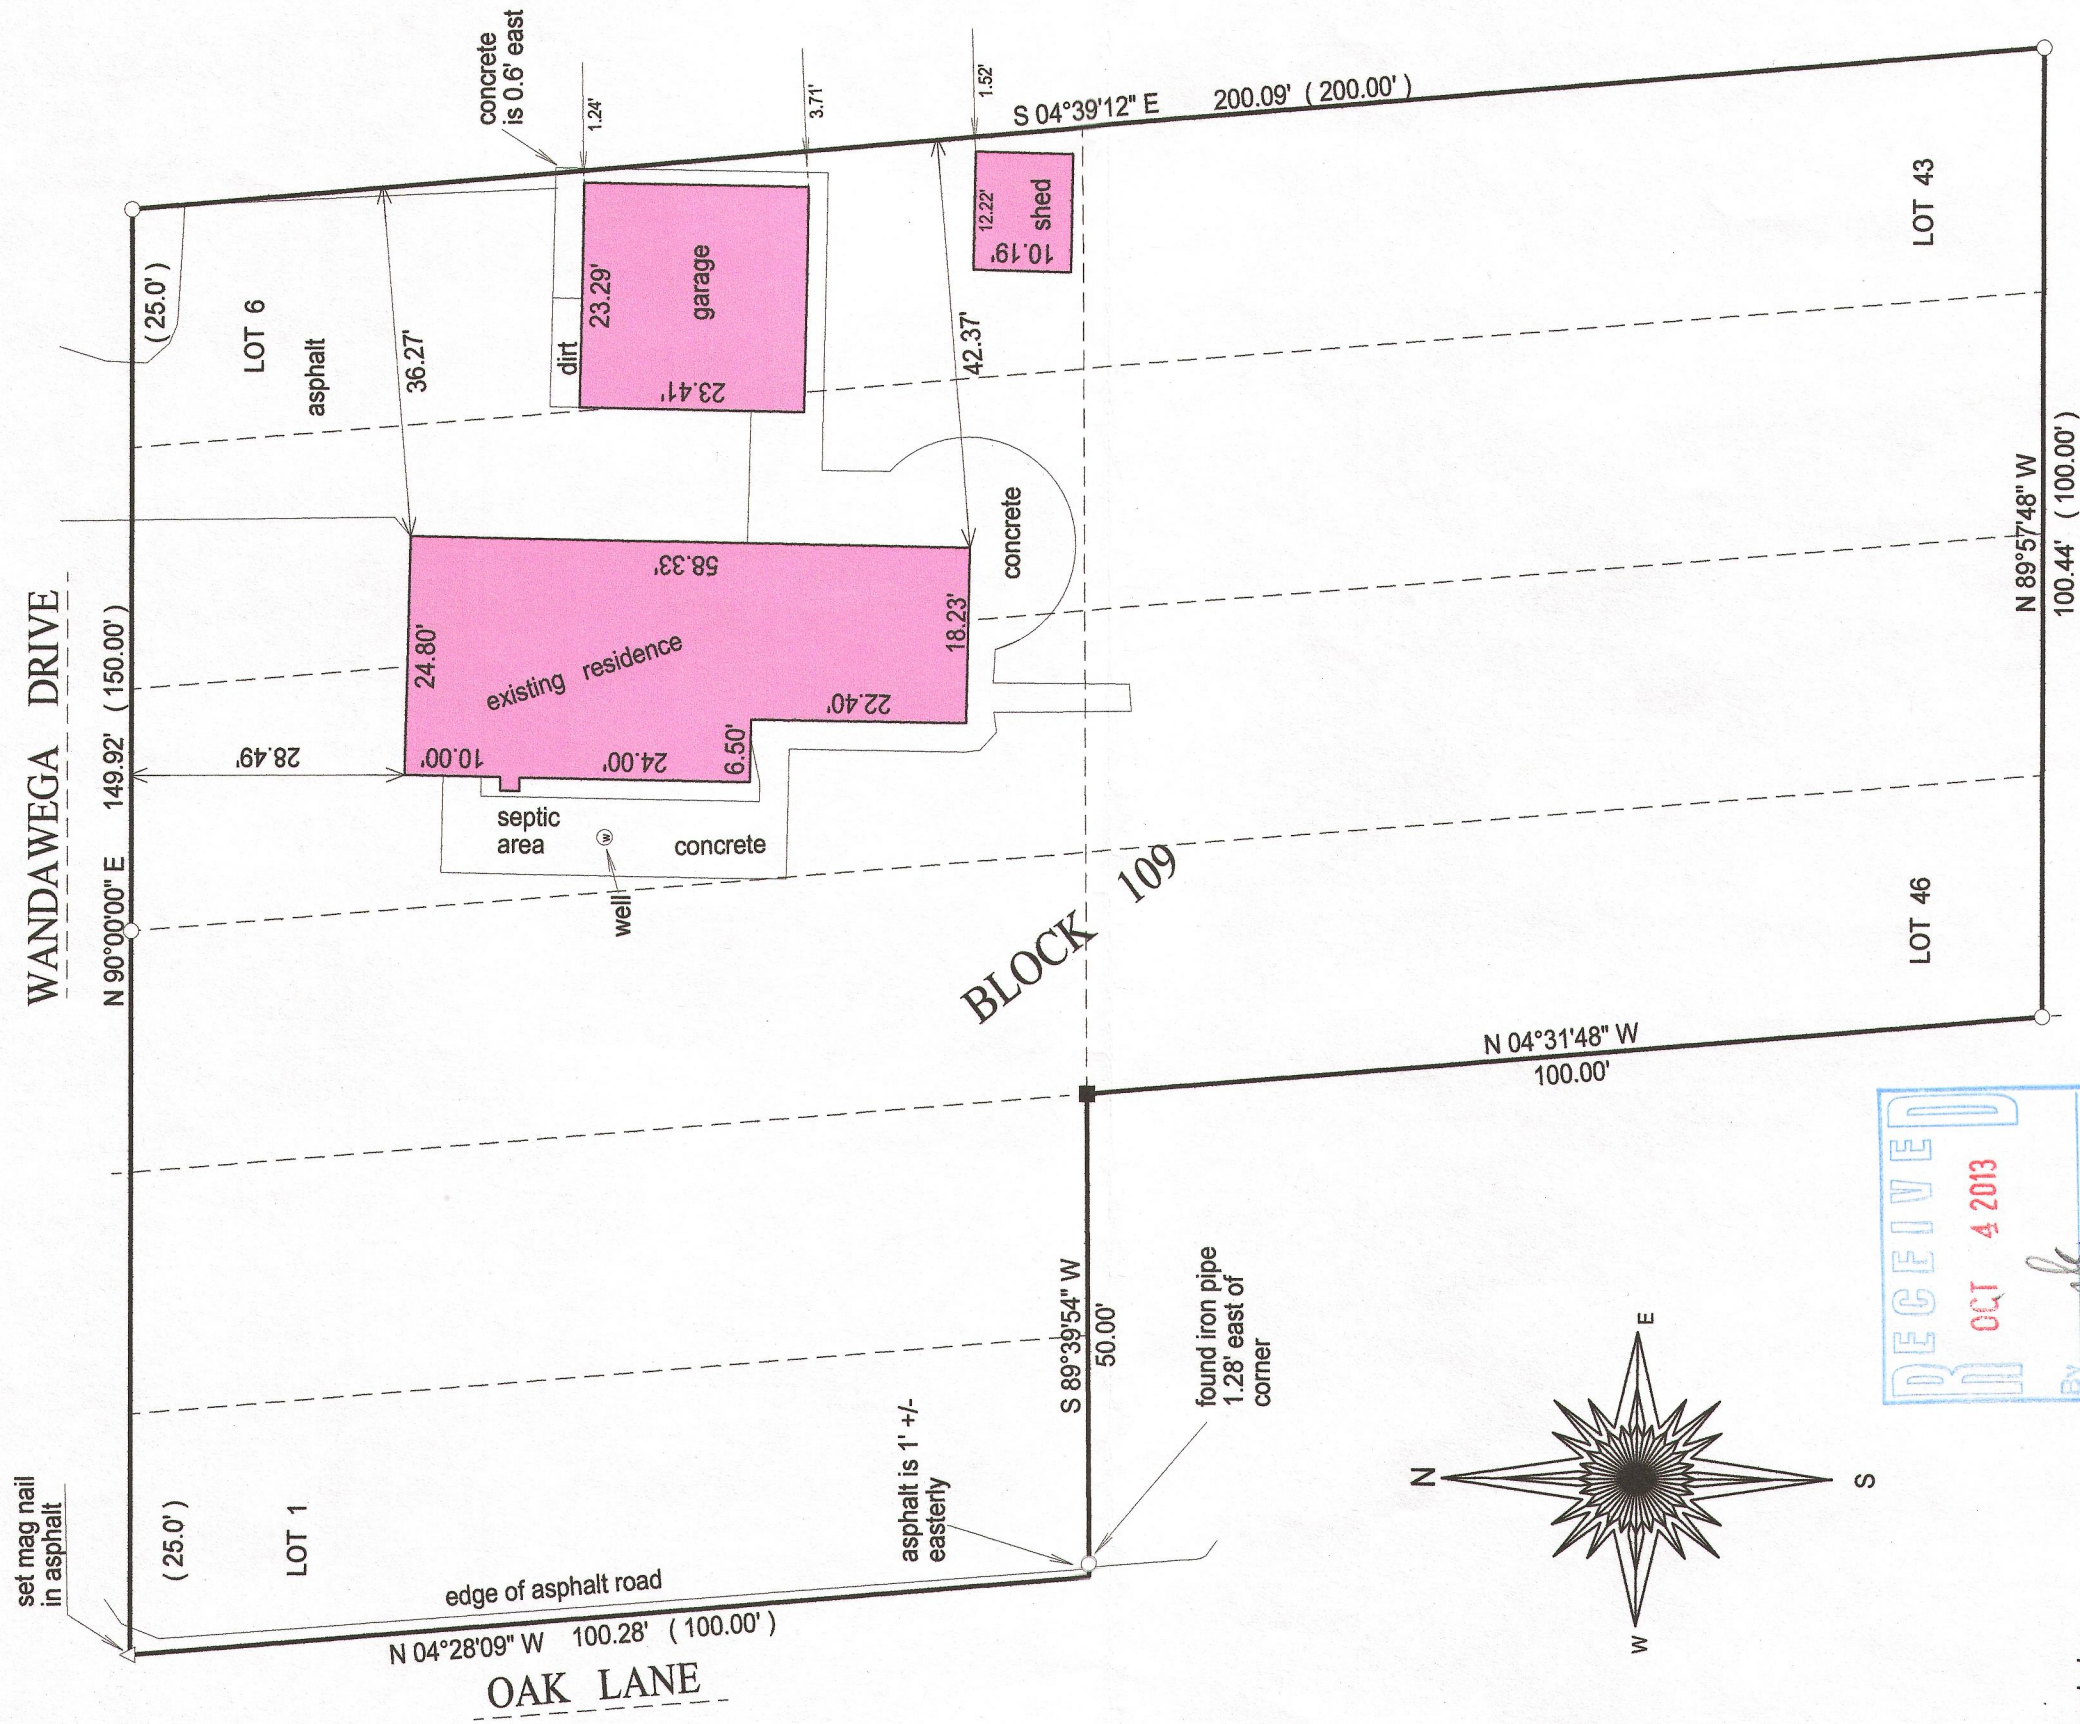

- () = recorded as
- = found iron bar
 - = found iron pipe
 - = set iron pipe
 - = set iron bar
- SCALE 1" = 20'

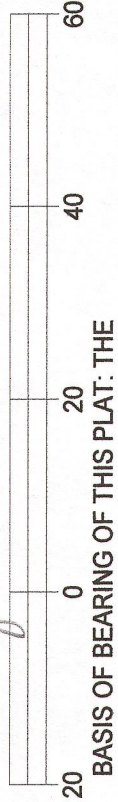

I hereby certify that I have surveyed the above-described property and the above map is a true representation thereof and shows the size and location of the property, its exterior boundaries, the location and dimensions of all structures thereon, fences, apparent easements and roadways and visible encroachments if any.

This survey is made for the present owners of the property, and those who purchase, mortgage, or guarantee the title thereto, within one year from the date hereof.

JOB # 13-128

TAX ID # GLW 00306, 00308
AND 00323

DATED THIS 5TH DAY OF AUGUST, 2013.



JEFFREY L. KIMPS - S-2436
Wisconsin Registered Land Surveyor
(original if signed in red)

GLW-306
GLW-307
GLW-308

GLW-323

316-2153