

LAND-MARK SURVEYING

Mark L. Miritz

Wisconsin Registered Land Surveyor S-2582

N9330 Knuteson Drive
Whitewater, WI 53190
Phone: (262) 495-3284
MARKMIRITZ@
LAND-MARKSURVEYING.COM

PLAT OF SURVEY

LOT 1 OF CERTIFIED SURVEY MAP NO. 4479, LOCATED
IN PART OF THE NORTHWEST 1/4 OF THE SOUTHEAST
1/4 OF SECTION 29, TOWN 3 NORTH, RANGE 16 EAST,
SUGAR CREEK TOWNSHIP, WALWORTH COUNTY, WISCONSIN.


OWNERS: LESLIE A. PELNAR
CHRISTOPHER PELNAR
N5450 CTY ROAD "O"
ELKHORN, WI 53121

ZONED A-1

THIS IS A FARM SEPARATION


NOTE:
SOIL BORINGS WERE LOCATED FOR
PROPOSED REPLACEMENT SYSTEM

Horizontal Datum is based on the
Wisconsin State Plane Coordinate
System Grid, South Zone, North
American Datum of 1927, all
bearings are referred to Grid
North. The West line of the SE 1/4
of Section 29-3-16 was assumed
to bear N 02°26'57" W

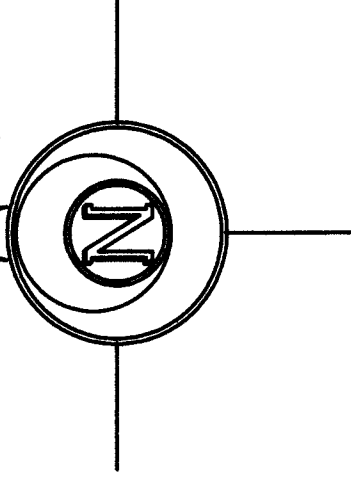


SCALE: 1 INCH = 60 FEET

CENTER OF
SECTION 29-3-16

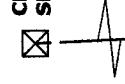

535.35'

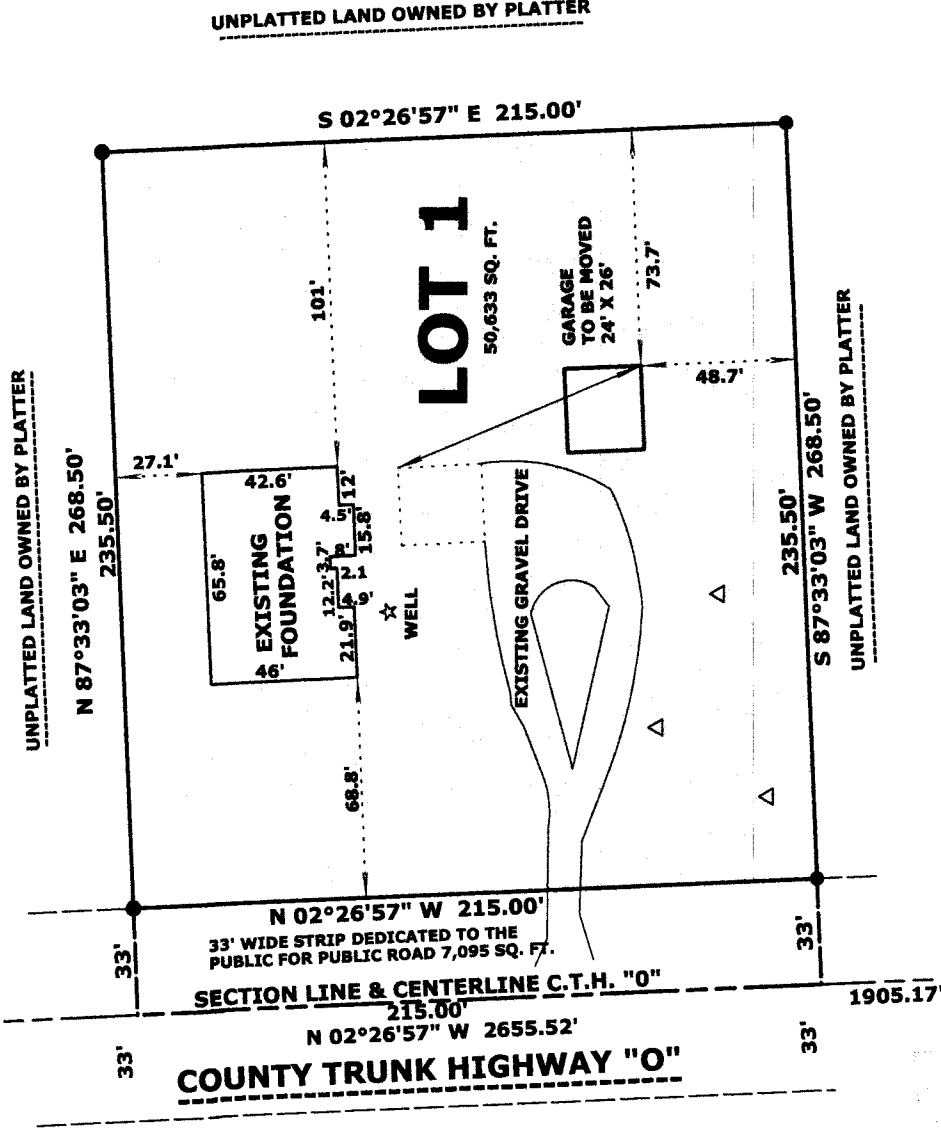

SOUTH 1/4 CORNER
SEC. 29-3-16


DEC 1 2013

LEGEND

FOUND COUNTY MONUMENT

FOUND IRON ROD

SOIL BORING

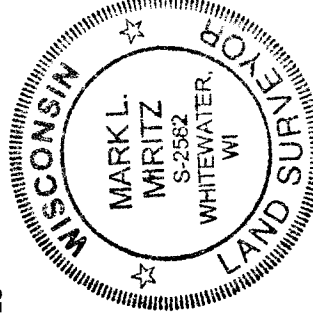

"I hereby certify that the above described property has
been surveyed by me or under my direction and that the
above map is a true representation thereof and shows the
size and location of the property, its exterior boundaries,
the location of all visible structures and dimensions of all
principal buildings thereon, boundary fences, apparent
easements, roadways and visible encroachments, if any."
This survey is made for the use of the present owners of
the property, and also those who purchase, mortgage, or
guarantee the title thereto within one year from date
hereof."

Mark L. Miritz
MARK L. MIRITZ
WISCONSIN REGISTERED
LAND SURVEYOR S-2582

REVISED MAY 31, 2013 TO MOVE GARAGE EAST
REVISED JULY 2, 2013 TO SHOW FOUNDATION
"AS BUILT"

DATE: MAY 22, 2013 JOB NO. 10.101

GA4479-1

316-2160