



LAND-MARK SURVEYING
 Mark L. Miritz
 Wisconsin Registered Land Surveyor S-2582

N9330 Knutson Drive
 Whitewater, WI 53190
 Phone: (262) 495-3284
 FAX: (262) 495-8421
 LAND-MARKSURVEYING.COM

PLAT OF SURVEY

Unit 17 and so much of the undivided interest in the common areas and facilities appurtenant to such unit in a condominium commonly known as Lauderdale Lakes Estates Condominium, created under the unit ownership act of the State of Wisconsin by a declaration dated June 22, 1995 and recorded on June 30, 1995 in the office of the Register of Deeds for Walworth County, Wisconsin, in Volume 635 of Records on page 6186 as Document No. 308536 and any and all amendments, addendum thereto.

ORDERED BY: CHERYL HANSEN
 RE/MAX GENEVA REALTY
 101 BROAD STREET, SUIT 102
 LAKE GENEVA, WI 53147

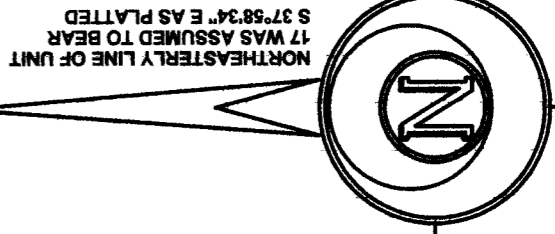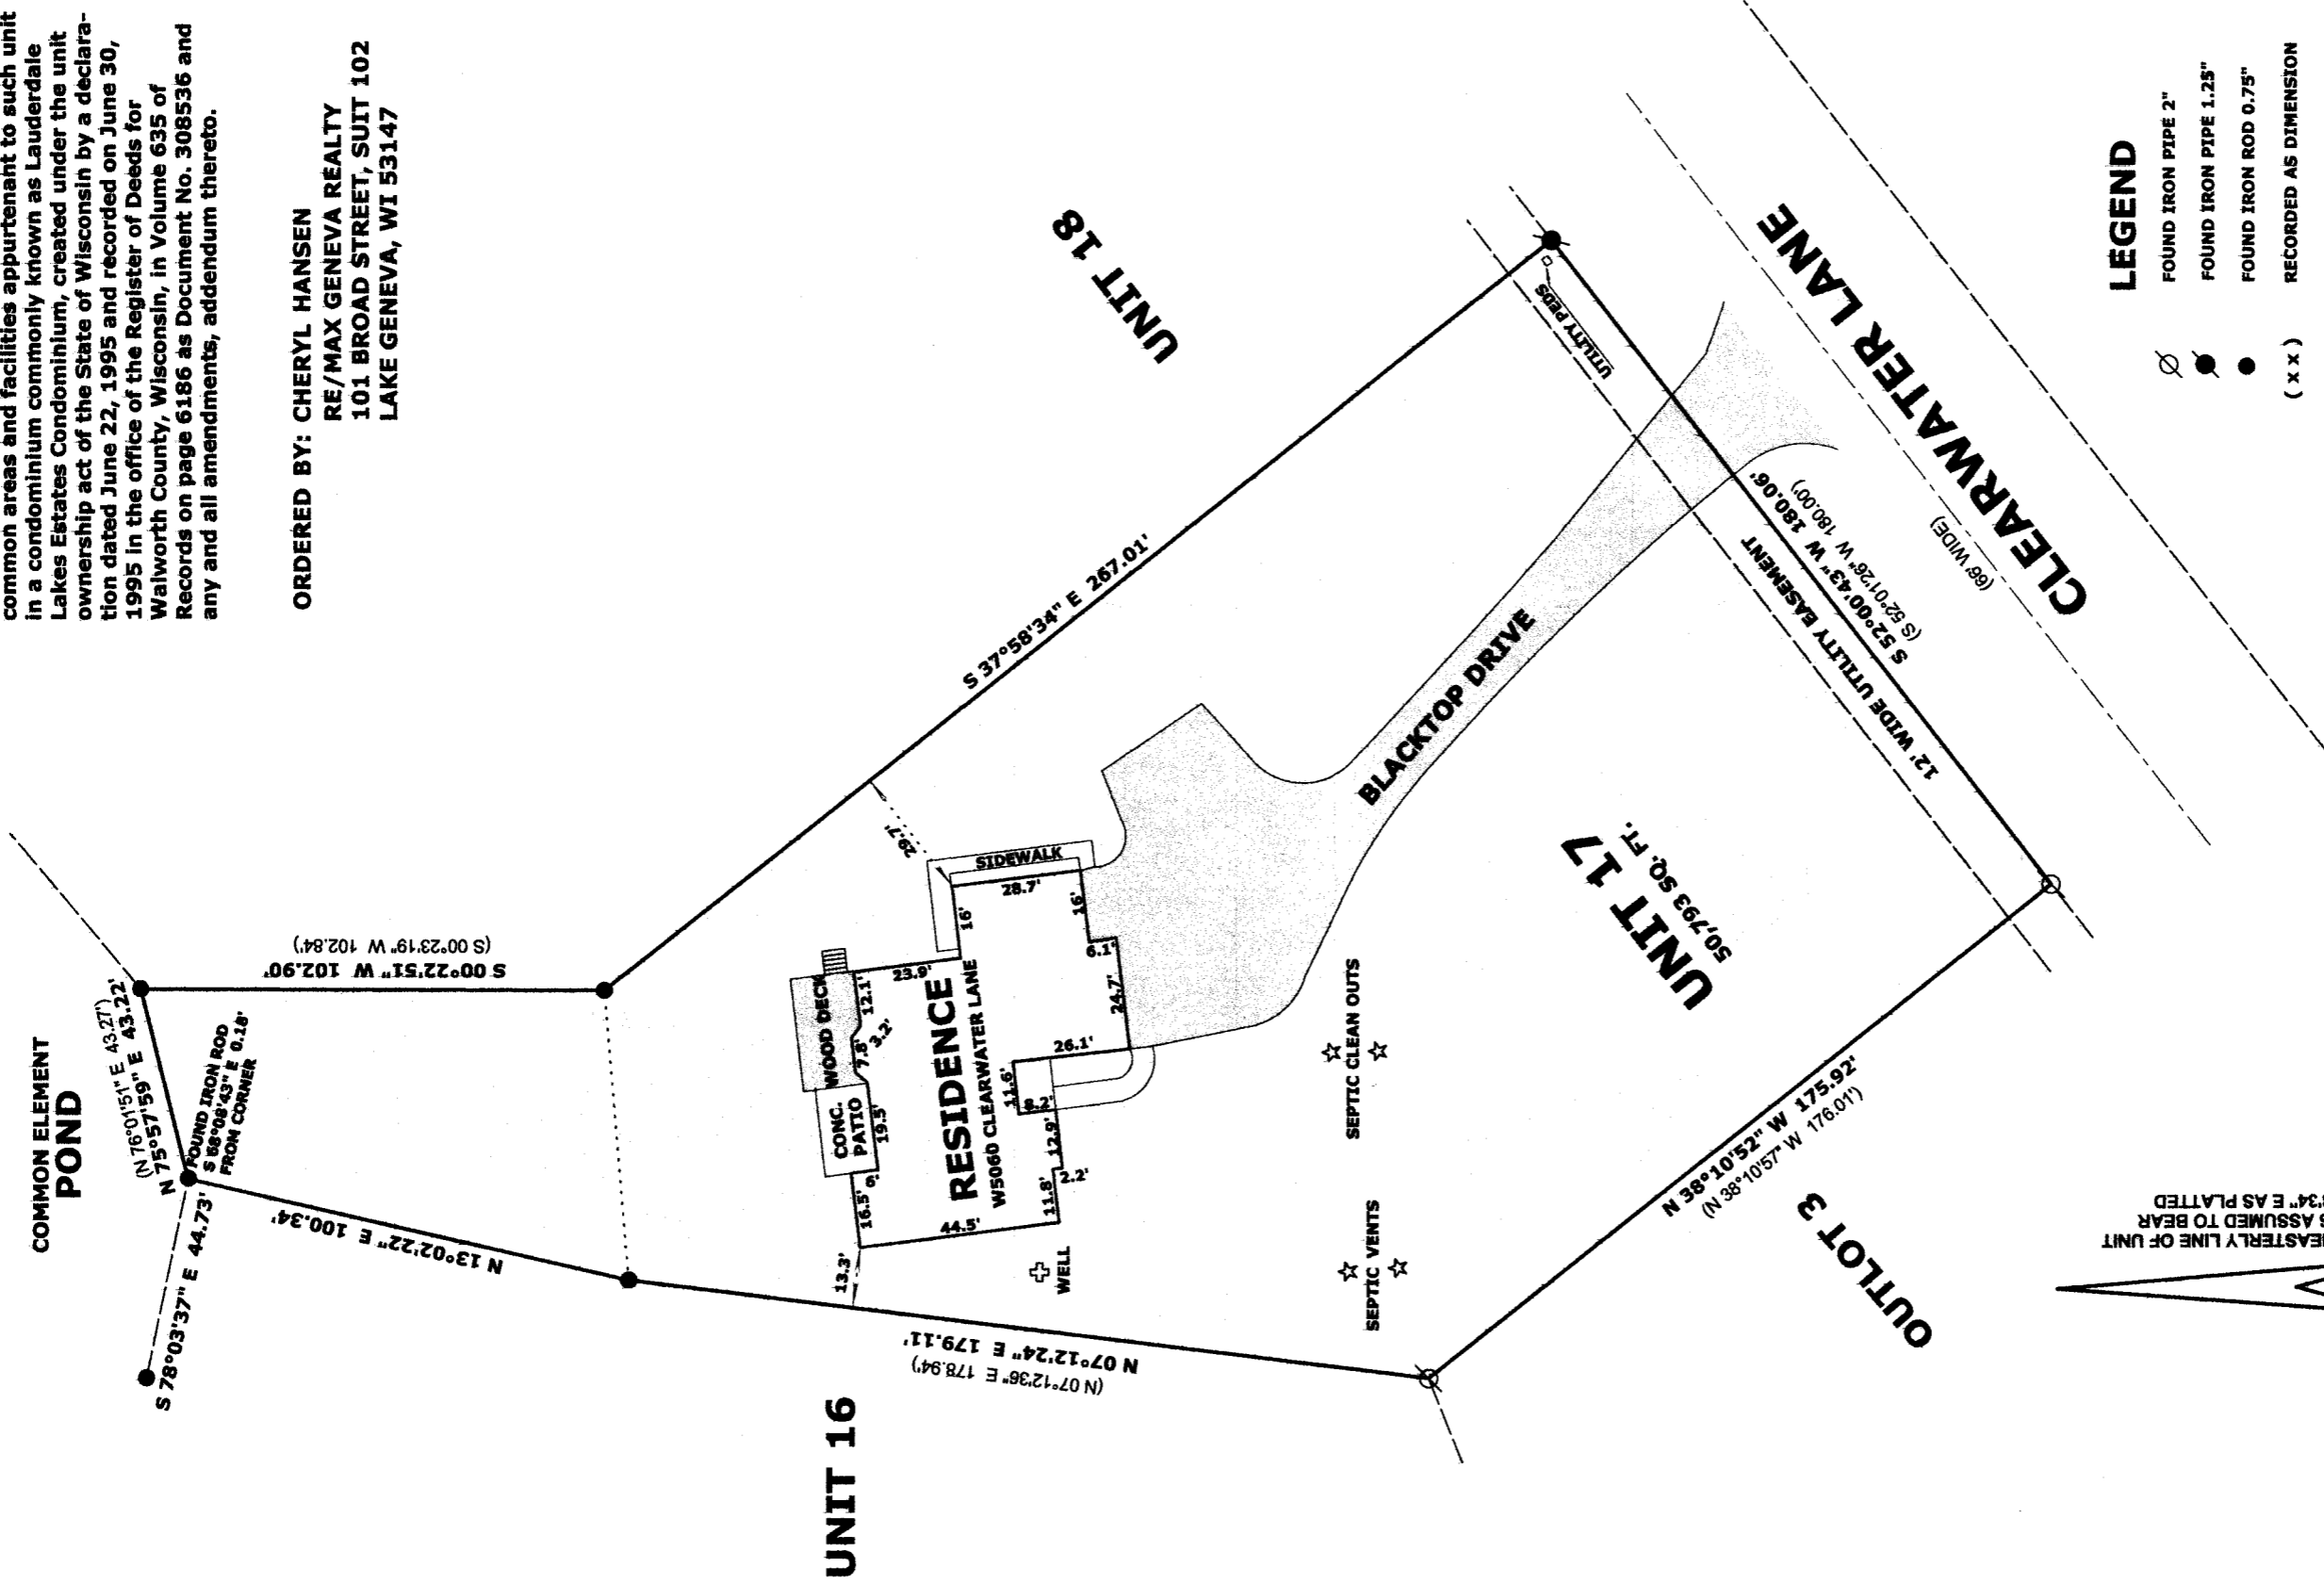

- LEGEND**
- FOUND IRON PIPE 2"
 - FOUND IRON PIPE 1.25"
 - FOUND IRON ROD 0.75"
 - (x x) RECORDED AS DIMENSION

SCALE: 1 INCH = 40 FEET

"I hereby certify that the above described property has been surveyed by me or under my direction and that the above map is a true representation thereof and shows the size and location of the property, its exterior boundaries, the location of all visible structures and dimensions of all principal buildings thereon, boundary fences, apparent easements, roadways and visible encroachments, if any." "This survey is made for the use of the present owners of the property, and also those who purchase, mortgage, or guarantee the title thereto within one year from date hereof."



Mark L. Miritz
 MARK L. MIRITZ
 WISCONSIN REGISTERED
 LAND SURVEYOR S-2582

DEC 1 2 2013

fe GLEJ -13 316-2163

DATE: NOV. 11, 2013 JOB NO. 13.1107