

LAND-MARK SURVEYING

Mark L. Miritz

Wisconsin Registered Land Surveyor S-2582

N9330 Knuteson Drive

Whitewater, WI 53190

Phone: (262) 495-3284


MARKMIRITZ@

LAND-MARKSURVEYING.COM

PLAT OF SURVEY


LOTS FOURTEEN (14), FIFTEEN (15) AND SIXTEEN (16), IN BLOCK ONE HUNDRED SIXTEEN (116), IN LAKE WANDAWEGA SUBDIVISION, ACCORDING TO THE RECORDED PLAT THEREOF, IN TOWN OF SUGAR CREEK, WALWORTH COUNTY, WISCONSIN. ALSO A PARCEL OF LAND LOCATED IN THE SOUTHWEST 1/4 OF SECTION 1, TOWN 3 NORTH, RANGE 16 EAST, DESCRIBED AS FOLLOWS: COMMENCING AT THE SOUTHWEST CORNER OF LOT 31, BLOCK 116, LAKE WANDAWEGA SUBDIVISION, THENCE WEST TO THE EAST LINE OF SUGAR CREEK LANE AND THE PLACE OF BEGINNING; RUN THENCE EAST TO THE SOUTHWEST CORNER OF LOT 31, BLOCK 116, LAKE WANDAWEGA SUBDIVISION; THENCE NORTH TO THE SOUTHEAST CORNER OF LOT 16, BLOCK 116, THENCE WEST TO THE EAST LINE OF SUGAR CREEK LANE; THENCE SOUTH TO THE PLACE OF BEGINNING, FORMERLY DESCRIBED AS LOTS 17 AND 18, BLOCK 116, LAKE WANDAWEGA SUBDIVISION.

ORDERED BY: CONNIE POGGENSEE
THE RAULAND AGENCY
118 KENOSHA STREET
WALWORTH, WI 53184

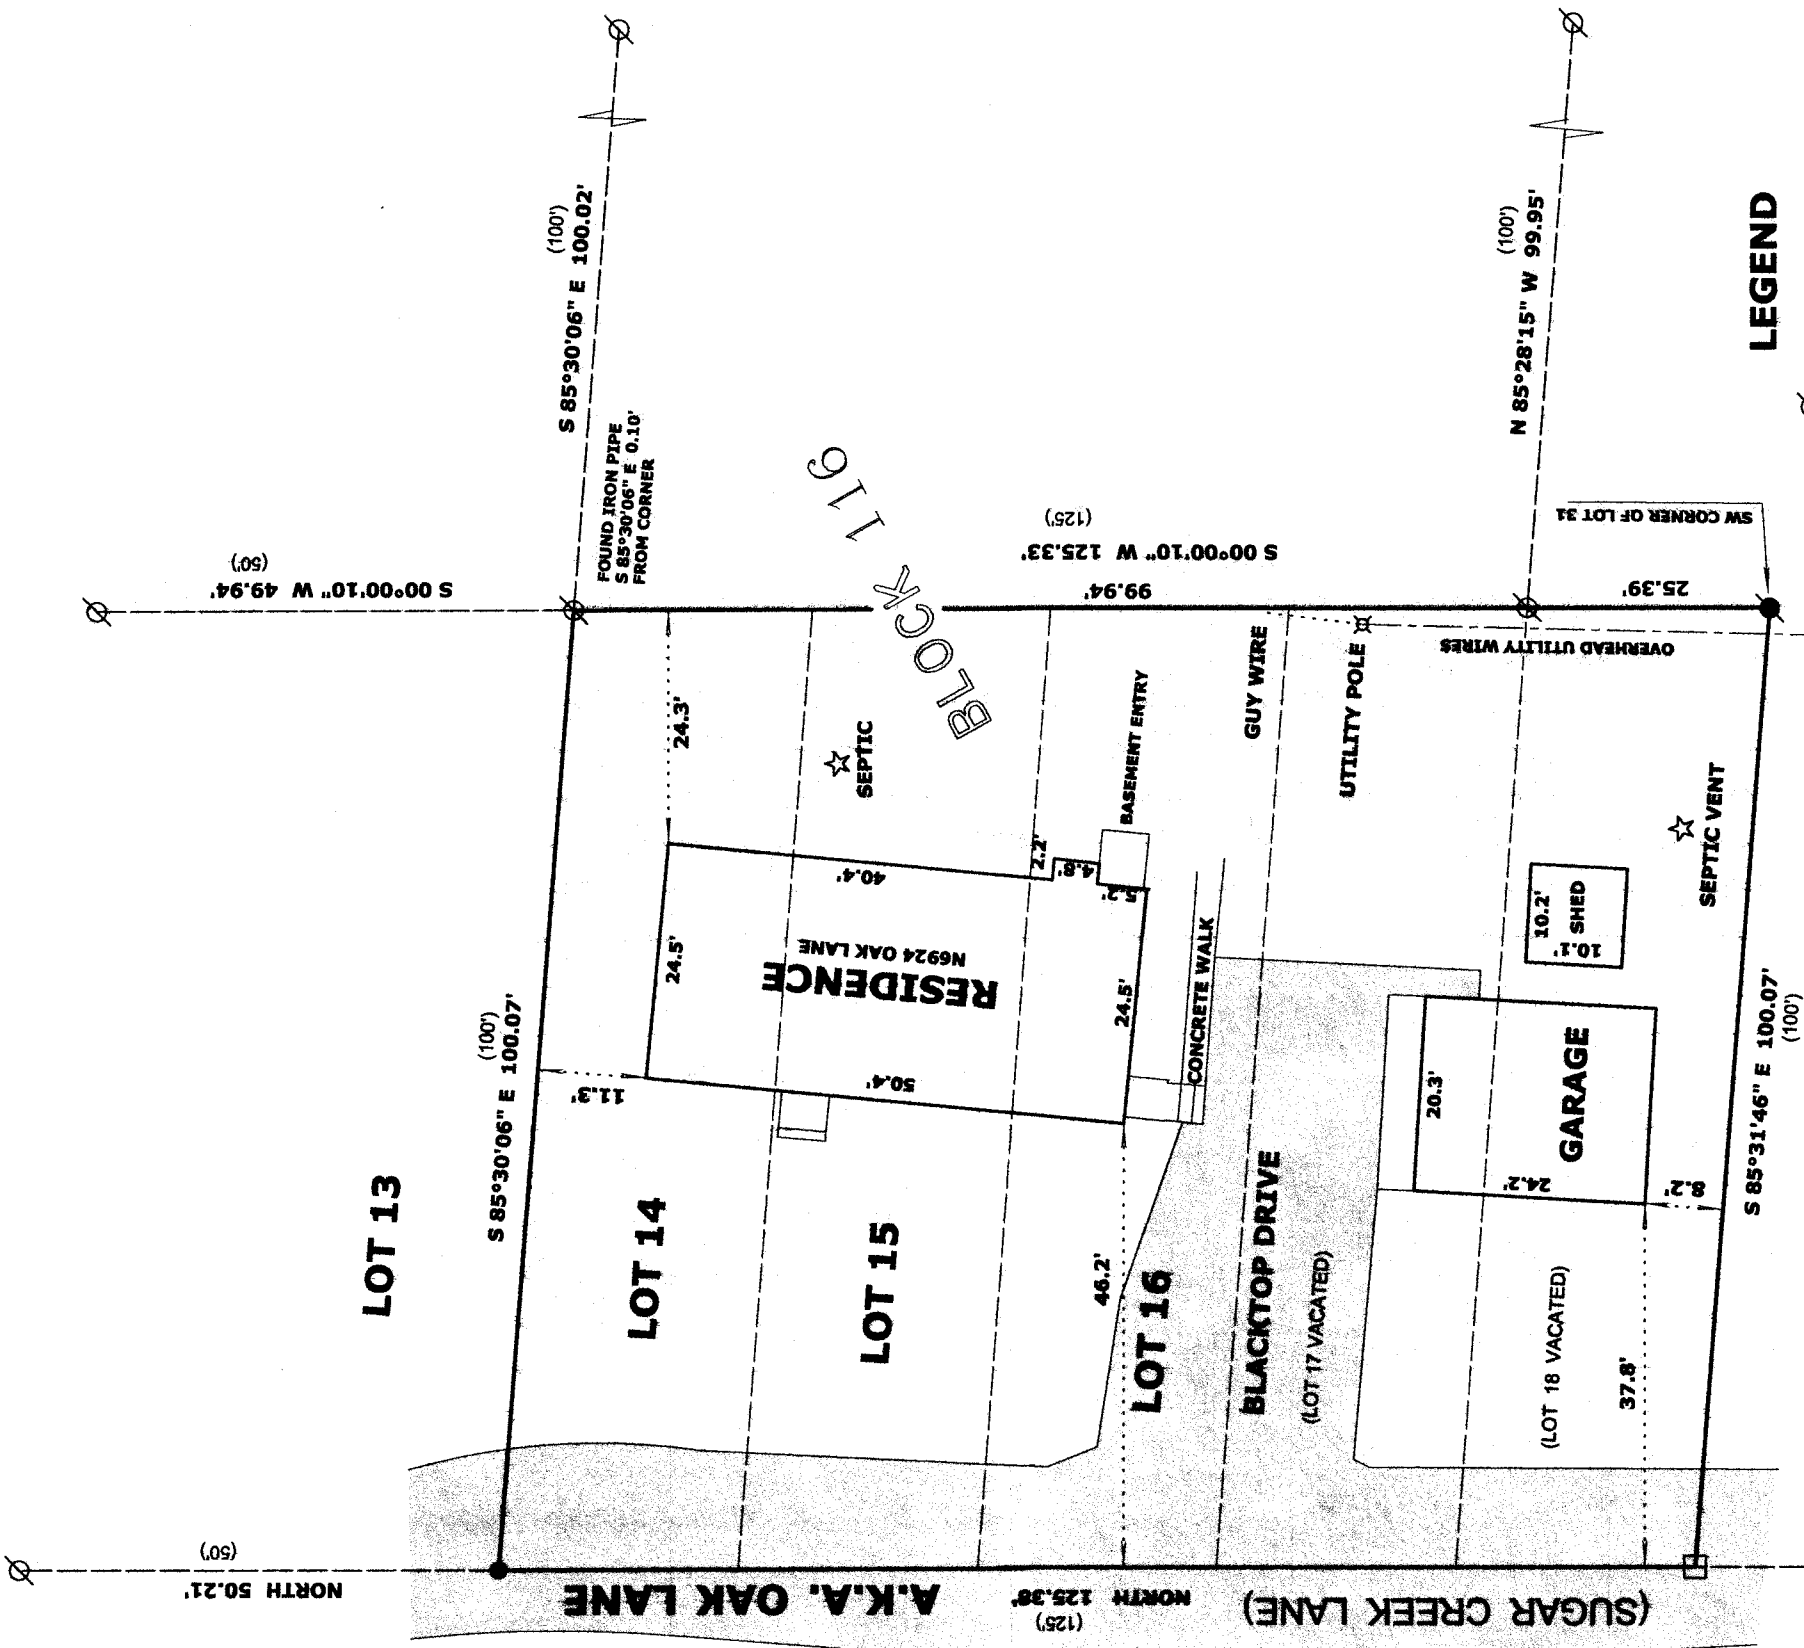

THE EAST LINE OF SUGAR CREEK
LANE WAS ASSUMED TO BEAR NORTH

DEC 1 2 2013

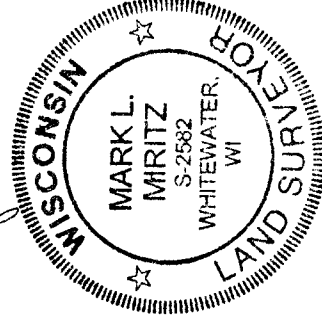

SCALE: 1 INCH = 20 FEET

"I hereby certify that the above described property has been surveyed by me or under my direction and that the above map is a true representation thereof and shows the size and location of the property, its exterior boundaries, the location of all visible structures and dimensions of all principal buildings thereon, boundary fences, apparent easements, roadways and visible encroachments, if any." "This survey is made for the use of the present owners of the property, and also those who purchase, mortgage, or guarantee the title thereto within one year from date hereof."

Mark L. Miritz
MARK L. MIRITZ
WISCONSIN REGISTERED
LAND SURVEYOR S-2582

GLW-347
G 8C 1-11B1

DATE: OCT. 11, 2013 JOB NO. 13.1006