


FARRIS, HANSEN & ASSOCIATES, INC.

ENGINEERING - ARCHITECTURE - SURVEYING
7 RIDGWAY COURT - P.O. BOX 437 - ELKHORN, WISCONSIN 53121
PHONE: (262) 723-2098 FAX: (262) 723-5886
PLAT OF SURVEY

- WORK ORDERED BY -
RICHARD HOWARTH
C/O COLONY REALTY
35 S. WISCONSIN STREET
ELKHORN, WI. 53121

LOT 8 OF BLOCK 10 COOL HILL PARK ADDITION 1
LOCATED IN THE NE 1/4 SECTION 3
TOWN 3 NORTH, RANGE 16 EAST
WALWORTH COUNTY, WISCONSIN

Lot 8 in Block 10 of Cool Hill Park Addition No. 1, according to the plat thereof recorded November 6, 1988 in Volume 16 of Plats, on Page 1 as Document No. 808143, in Walworth County, Wisconsin.

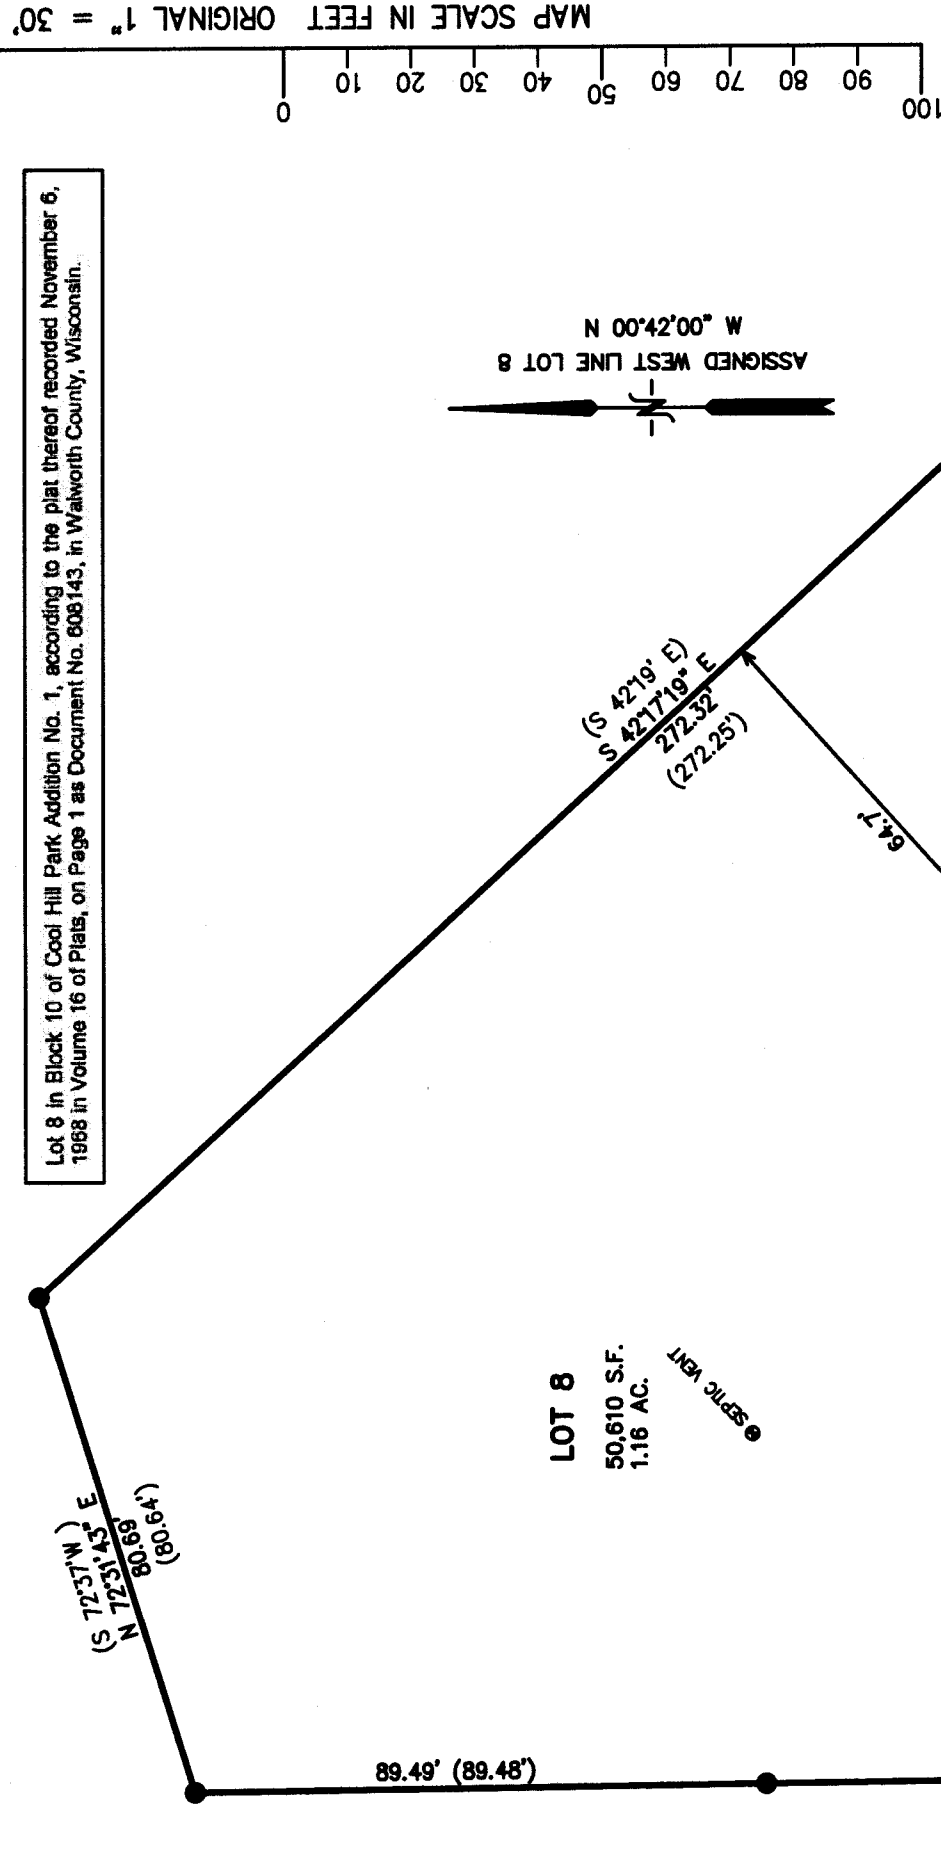


NOTE: COPIES OF THIS MAP TO WHICH THE FOLLOWING CERTIFICATE WILL APPLY SHOW THE SURVEYOR'S ORIGINAL SEAL AND SIGNATURE IN RED INK. COPIES BY ANY OTHER MEANS MAY HAVE ALTERATIONS WHICH DO NOT REPRESENT THE SURVEYOR'S WORK PRODUCT.

I HEREBY CERTIFY THAT THE ABOVE DESCRIBED PROPERTY HAS BEEN SURVEYED UNDER MY DIRECTION AND THAT THE ABOVE MAP IS A TRUE REPRESENTATION THEREOF AND SHOWS THE SIZE AND LOCATION OF THE PROPERTY, ITS EXTERIOR BOUNDARIES, THE LOCATION OF ALL VISIBLE STRUCTURES, AND DIMENSIONS OF ALL PRINCIPLE BUILDINGS THEREON, BOUNDARY FENCES, APPARENT EASEMENTS, ROADWAYS, AND VISIBLE ENCROACHMENTS, IF ANY. THIS SURVEY IS MADE FOR THE USE OF THE PRESENT OWNERS OF THE PROPERTY, AND ALSO THOSE WHO PURCHASE, MORTGAGE, OR GUARANTEE THE TITLE THERETO WITHIN ONE YEAR FROM THE DATE HEREOF.

DATED: JANUARY 9, 2014

PETER S. GORDON

PROJECT: 8941
DATE: 12-27-2013
SHEET 1 OF 1

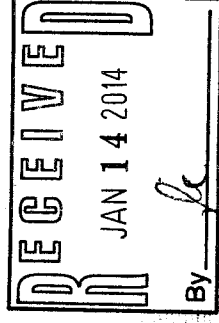

GCHA-8 316-2171