




* Verify exact number with Town Engineering Department

* outside finish grade = EL 102.00 (advisory only) - top of foundation = EL 102.67 (advisory only) unless otherwise determined in writing by Town Engineering Department
top of foundation elevation = 102.71

Scale
1" = 100'

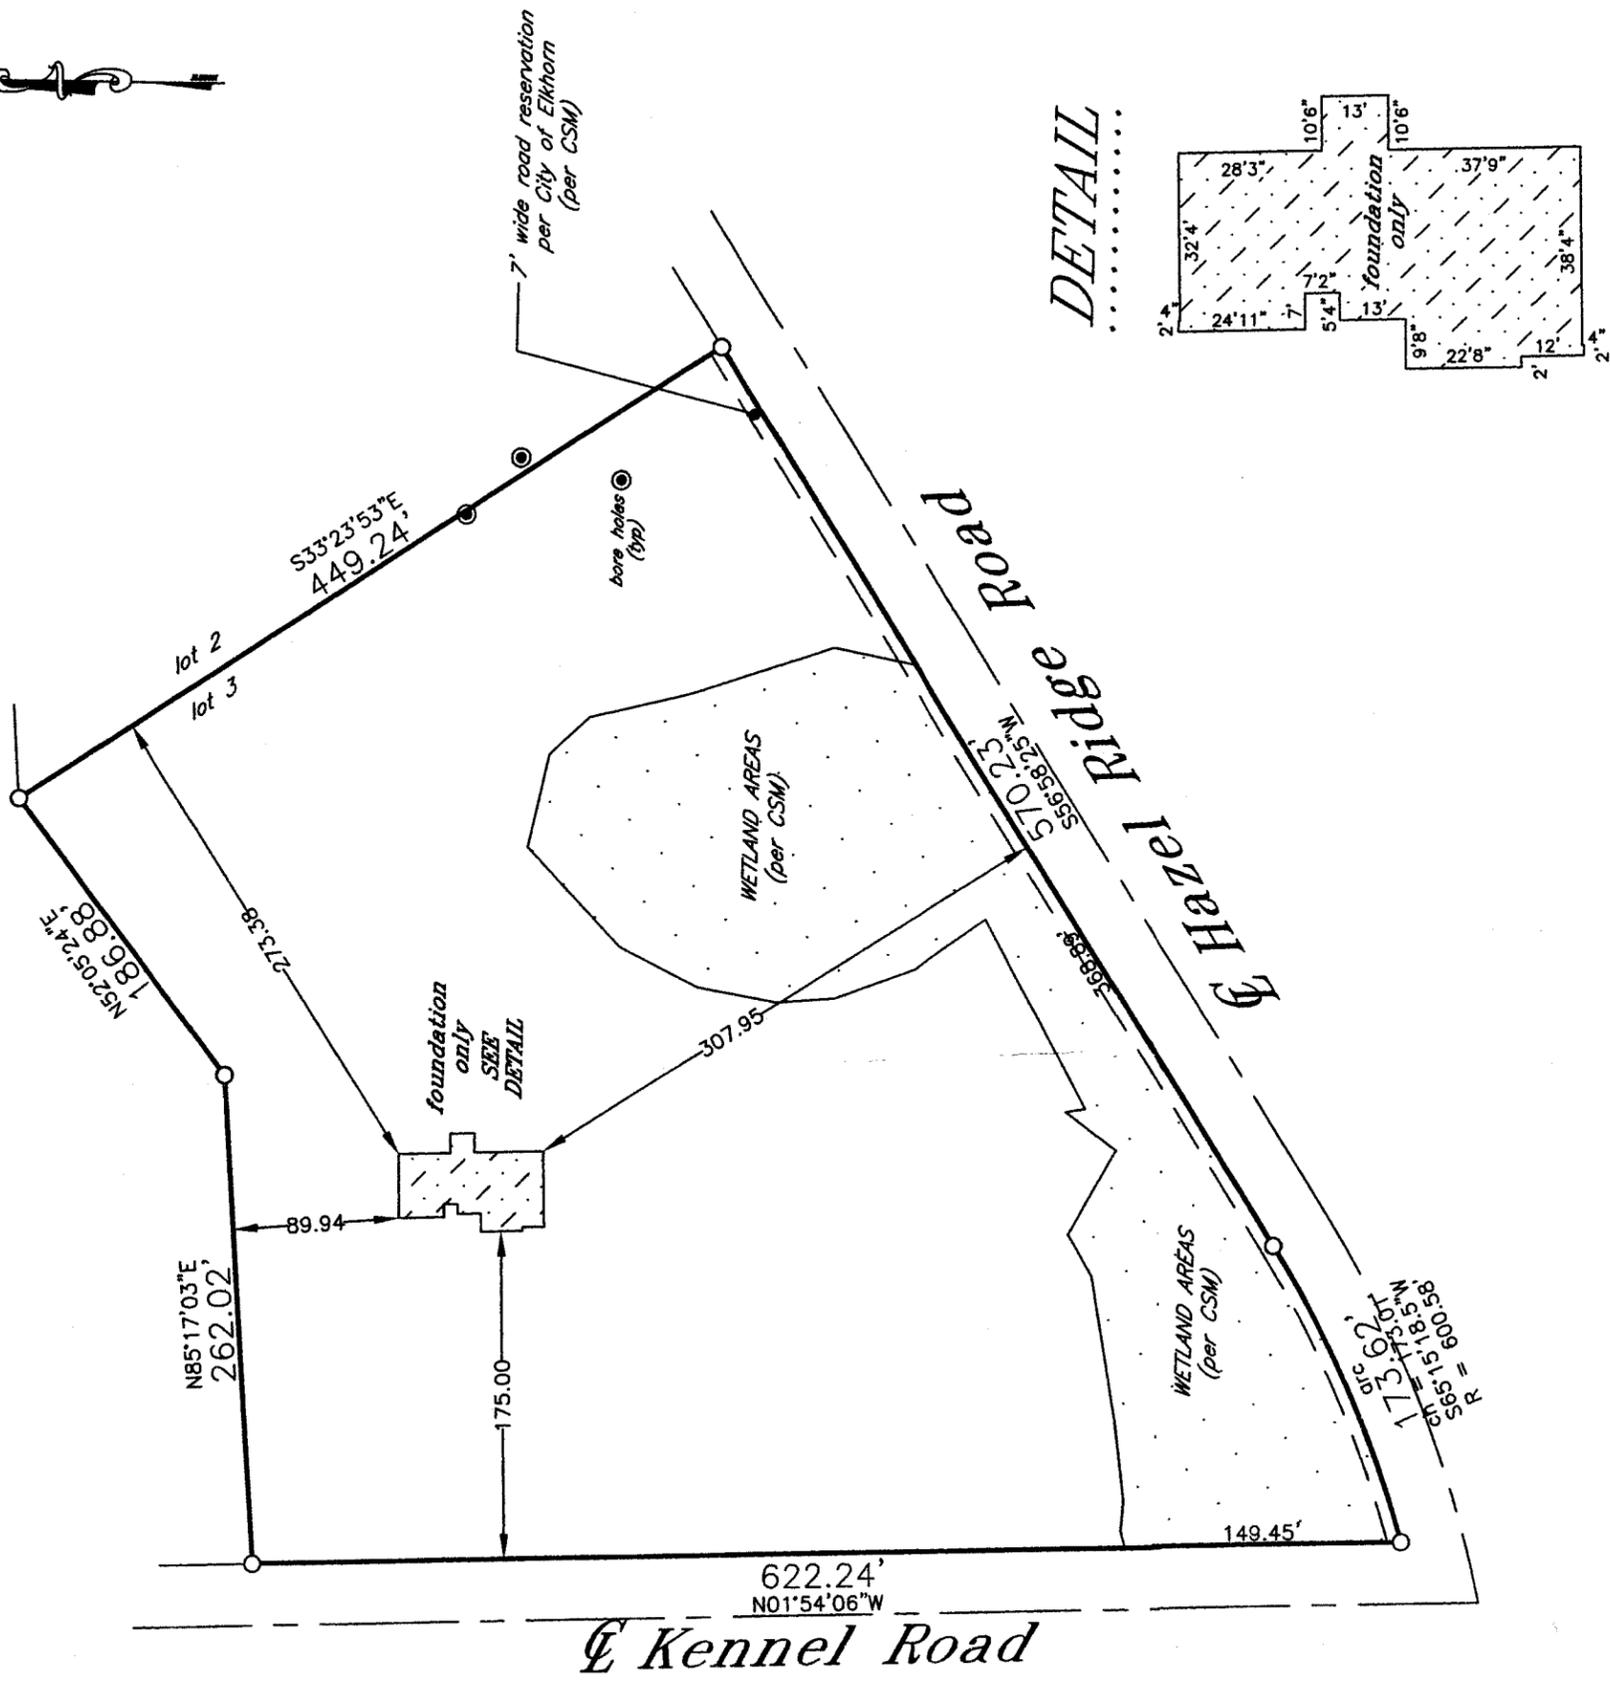


DETAIL

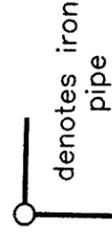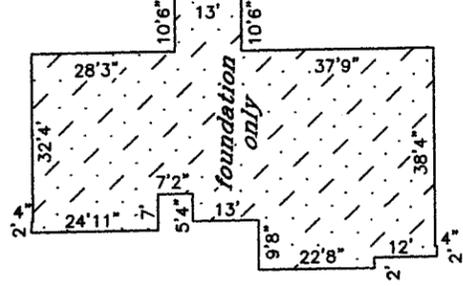

Proposed building field staked true size. Contractor to verify all dimensions before building by same. Refer to a current title report for easements or restrictions which may affect the use of this site that are not shown on the recorded certified survey map.


J.K.R. SURVEYING, INC.
8121 22ND AVENUE
KENOSHA, WI 53143

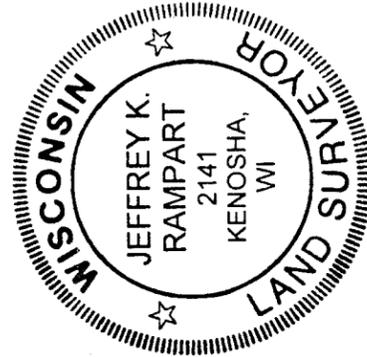

I hereby certify that this property was surveyed under my direction and this plat is a true representation thereof.

[Signature]

Reg. Land Surveyor
October 9, 2013
Revised 12/17/13

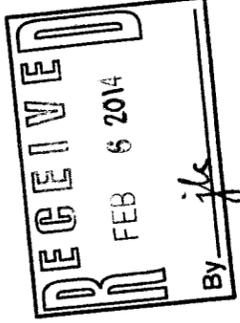

Plat of Survey of
LOT 3 OF
CERTIFIED SURVEY MAP NO. 4008

in NE1/4 Section 34-3-16
TOWN OF SUGAR CREEK
WALWORTH COUNTY, WIS.

-for-
Newport Builders

GA4008-3 316-2177