

Mark L. Miritz


LAND-MARKSURVEYING.COM

LAND-MARKSURVEYING.COM

ORDERED BY: CONNIE POGGENSEE
RAULAND AGENCY INC.
118 KENOSHA STREET
WALWORTH, WI 53184

PLAT OF SURVEY

**LOTS 58, 59, 60, 61 AND 62, IN BLOCK "A", NORTH LAKE BEACH, TRACT NO. 1,
AS PLATTED, SAID PLAT BEING RECORDED IN VOLUME 7 OF PLATS ON PAGE 166,
TOWN OF SUGAR CREEK, WALWORTH COUNTY, WISCONSIN.**

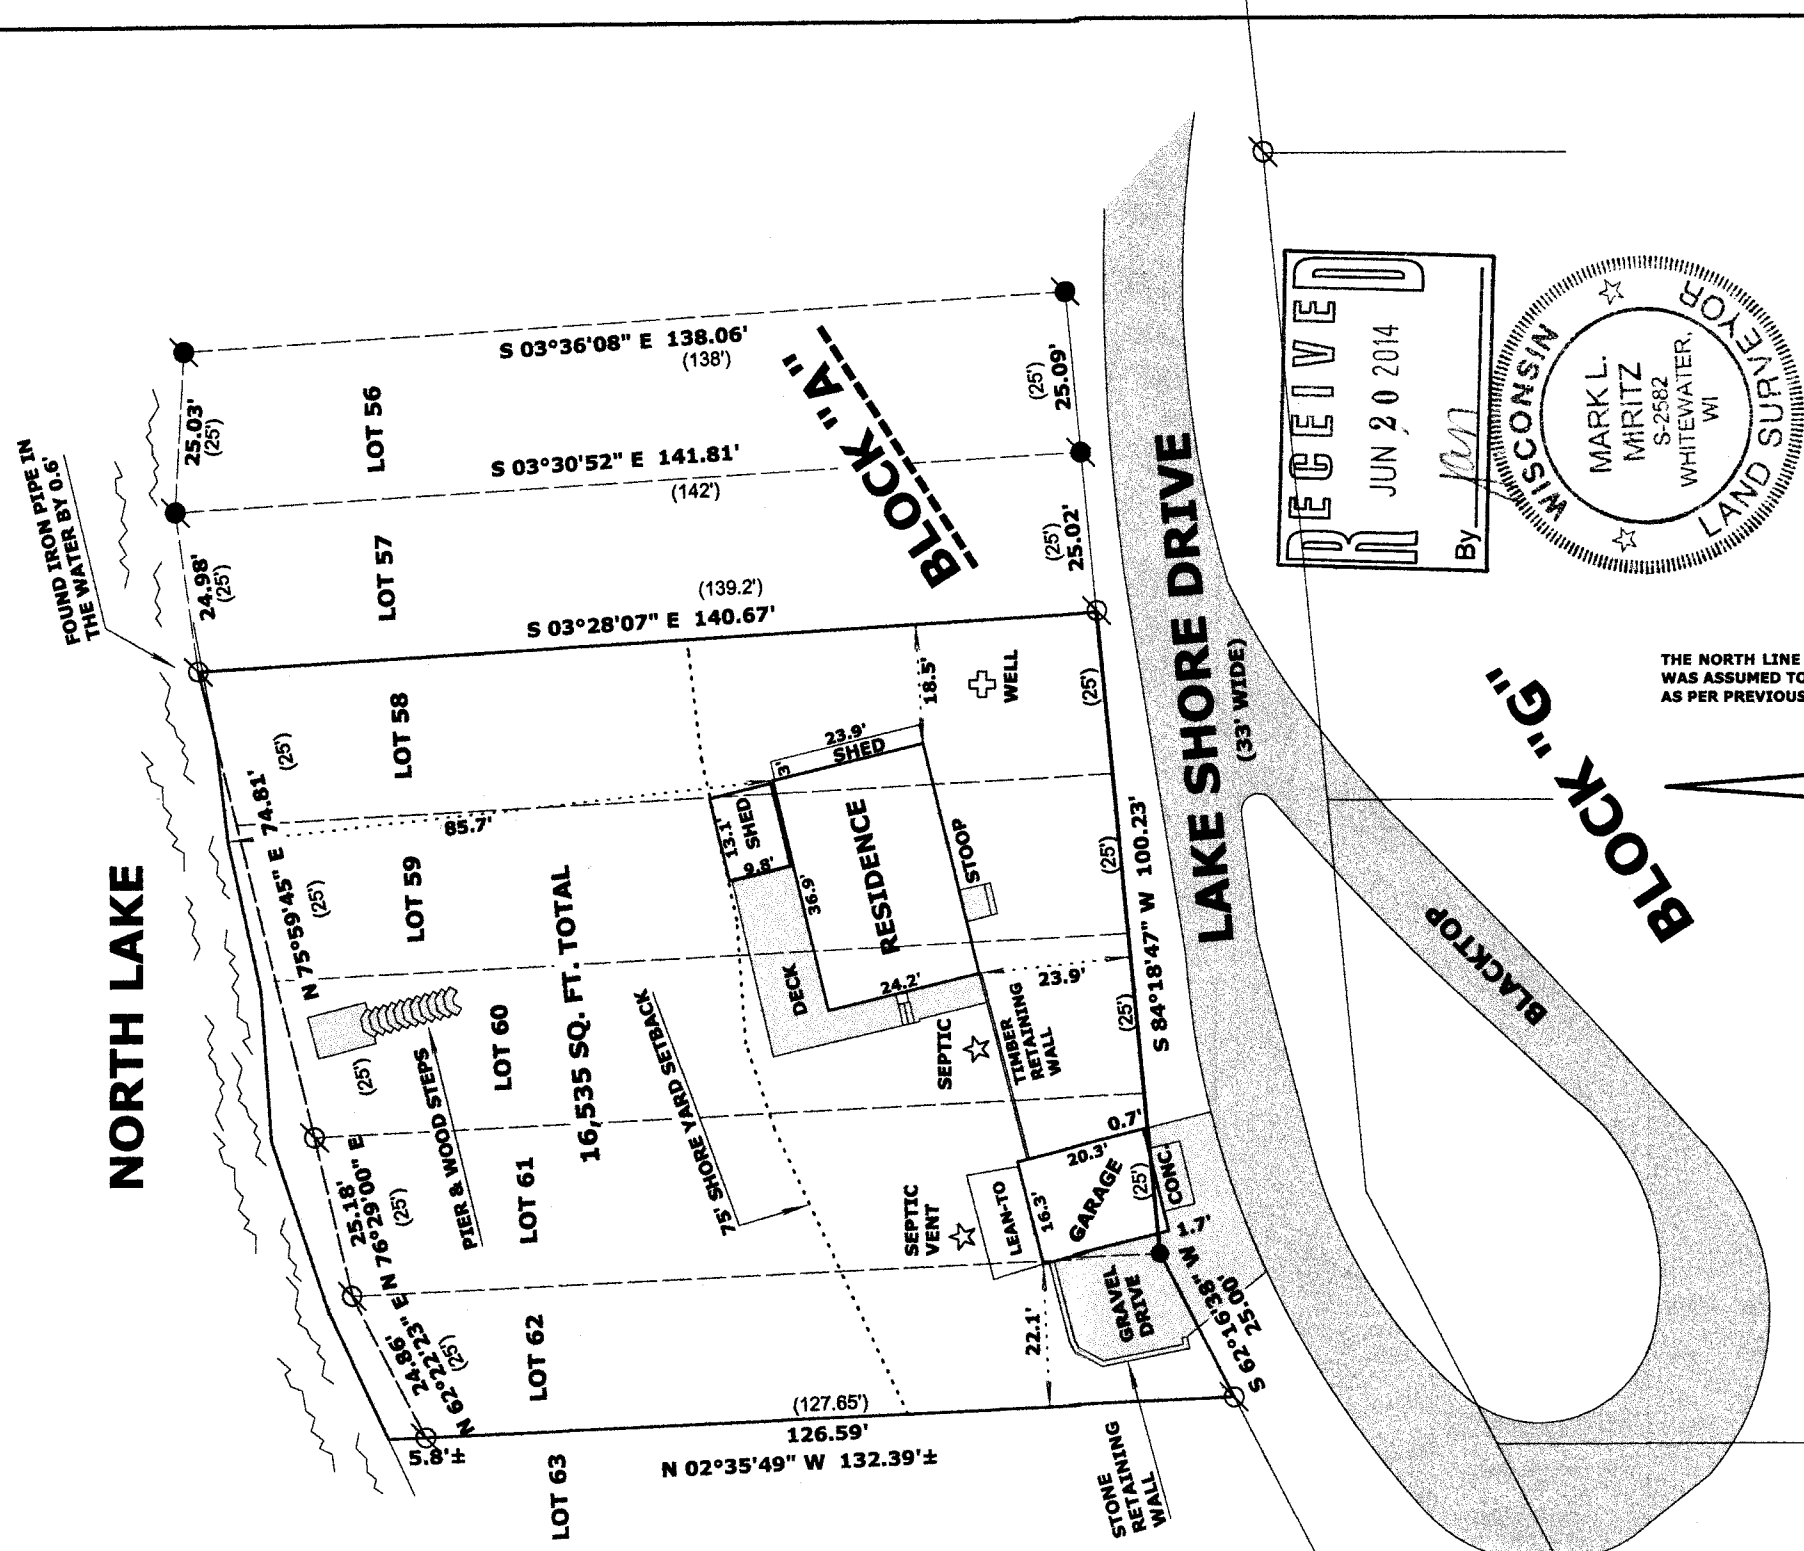

SCALE: 1 INCH = 30 FEET

"I hereby certify that the above described property has been surveyed by me or under my direction and that the above map is a true representation thereof and shows the size and location of the property, its exterior boundaries, the location of all visible structures and dimensions of all principal buildings thereon, boundary fences, apparent easements, roadways and visible encroachments, if any."

"This survey is made for the use of the present owners of the property, and also those who purchase, mortgage, or guarantee the title thereto within one year from date hereof."

Mark L. Miritz
MARK L. MIRITZ

DATE: MAY 13, 2014 JOB NO. 14.502

GNLB-30

316-2183