


PREPARED FOR
TOM MARTIN
KEEFE REAL ESTATE
ELKHORN, WI

PLAT OF SURVEY

- OF -

PATHFINDER SURVEYING INC.
(formerly)
J.K. SURVEYING INC.
P.O. BOX 322
LAKE GENEVA, WI 53147
WWW.PATHFINDERSURVEYING.NET
262-248-8303

LOTS 0 THRU 9 AND LOTS 14 1/2 THRU 23, BLOCK "C"
NORTH LAKE BEACH TRACT #1, LOCATED IN TOWN 3
NORTH, RANGE 16 EAST, TOWN OF SUGAR CREEK,
WALWORTH COUNTY, WISCONSIN

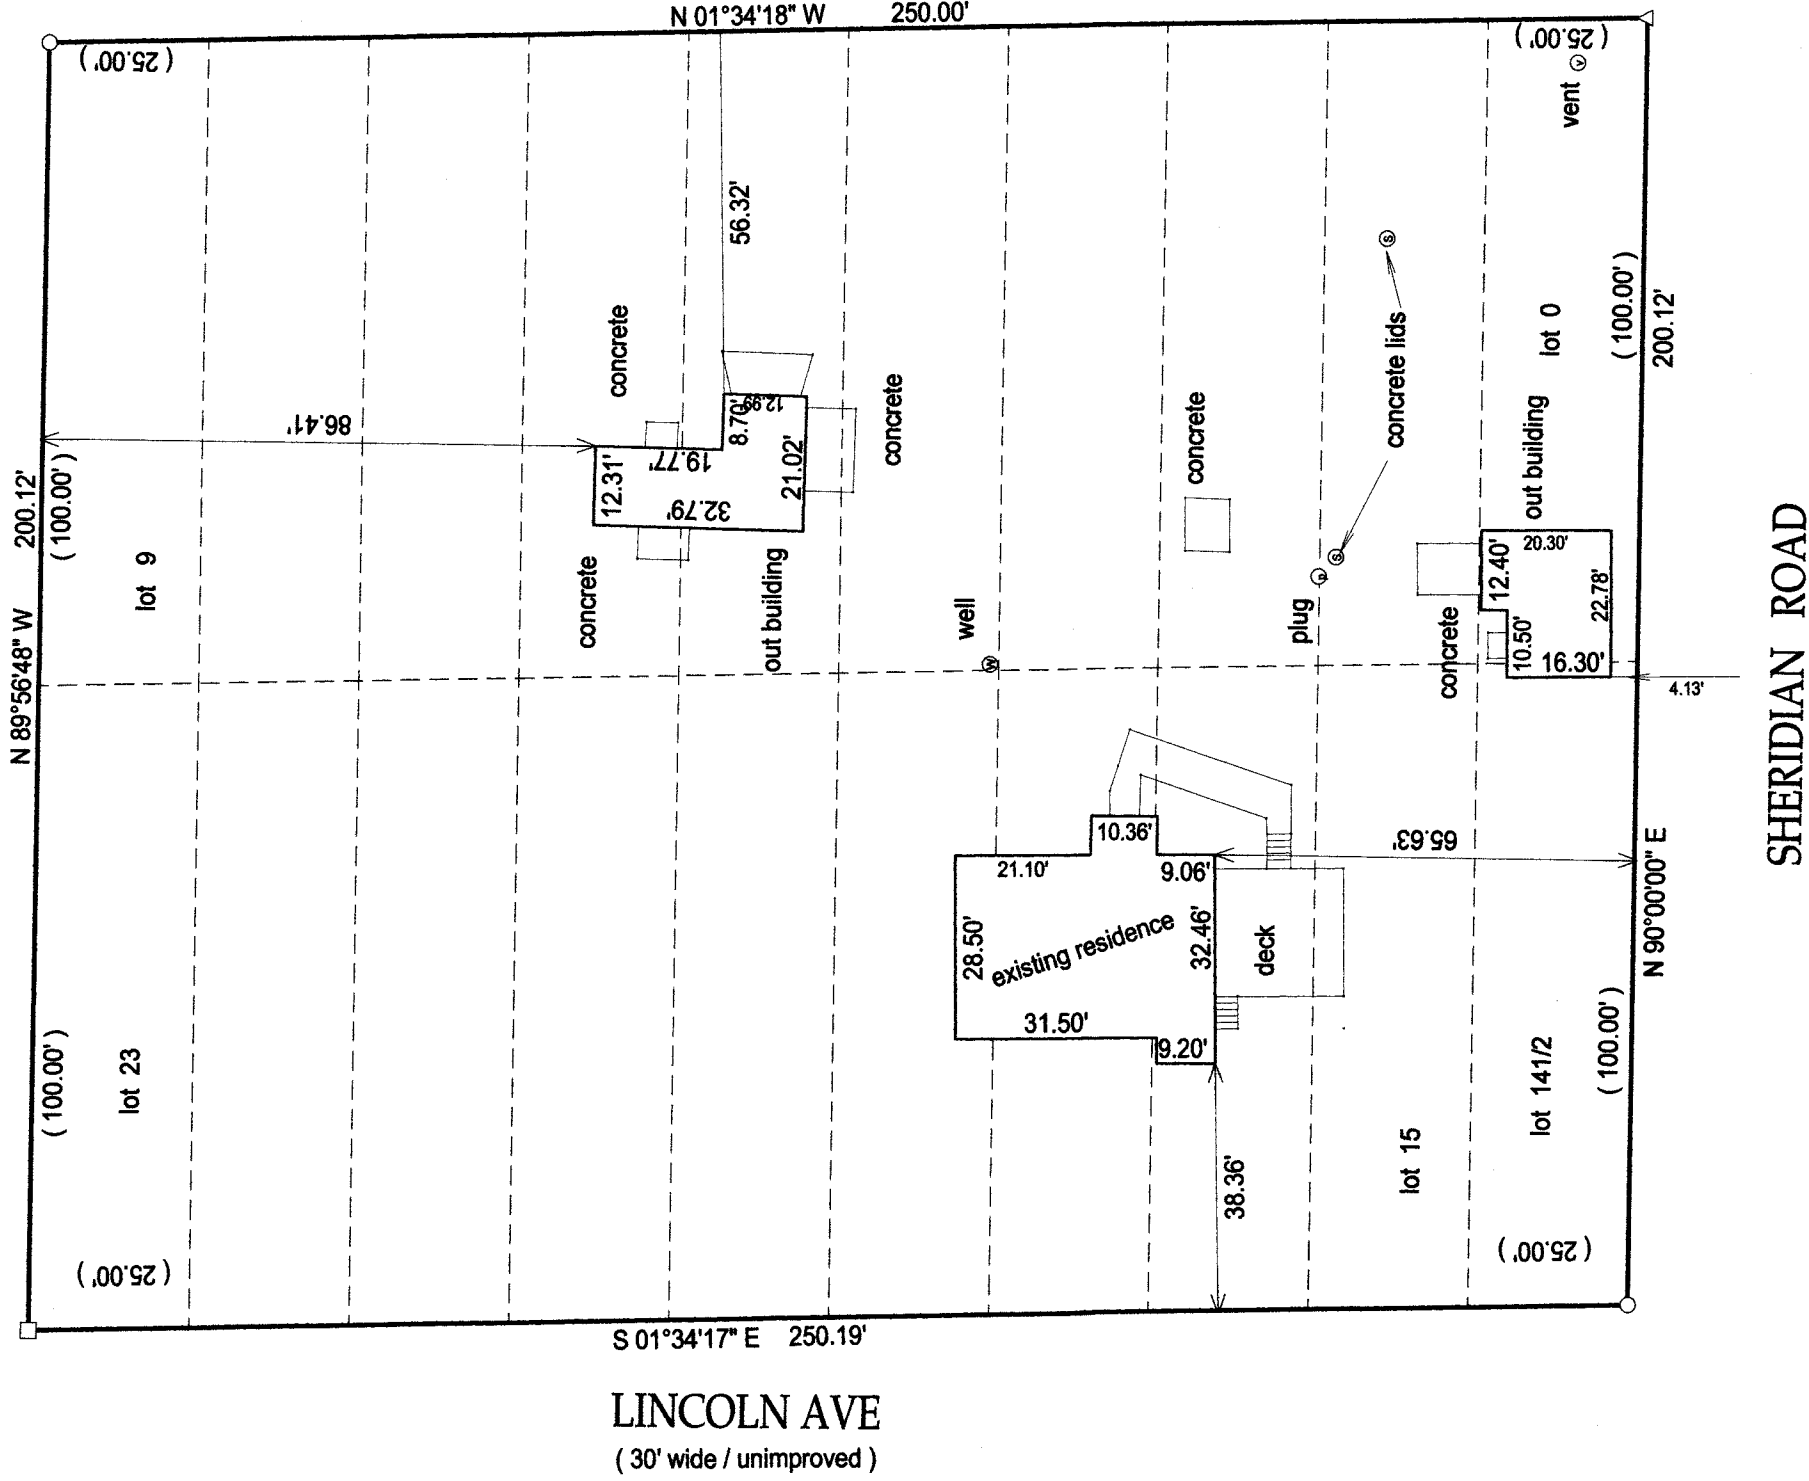


- () = recorded as
- = found iron bar
- = found iron pipe
- = set iron pipe
- = set iron bar

SCALE 1" = 30'

JOB # 13-222
13-236

TAX ID #
GNLB00041

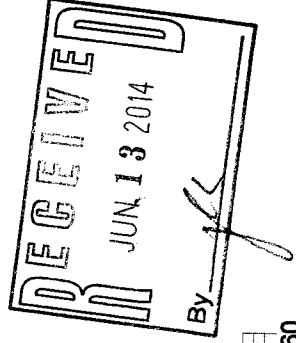

BASIS OF BEARING OF THIS PLAT: THE NORTH LINE
OF SHERIDIAN RD. WAS ASSUMED TO BEAR EAST.

"I hereby certify that I have surveyed the above described property and that the above map is a true representation of its exterior boundaries and shows the size and location of all visible structures, apparent easements and encroachments if any."

This survey is made for the present owners of the property, and those who purchase, mortgage, or guarantee the title thereto, within one year from the date hereof.



Jeffrey L. Kimps
JEFFREY L. KIMPS S-2436
Wisconsin Registered Land Surveyor
(original if signed in red)

DATED THIS 21ST DAY OF NOVEMBER, 2013

GNLB -41 316-2187