


PREPARED FOR
TOM MARTIN
KEEFE REAL ESTATE
ELKHORN WI

PLAT OF SURVEY

- OF -

PATHENDER SURVEYING INC.
(formerly)
J.K. SURVEYING INC.
P.O. BOX 322
LAKE GENEVA WI. 53157
WWW.PATHENDERSURVEYING.NET
262-248-8303

LOTS 31 AND 32 BLOCK "A" NORTH LAKE
BEACH TRACT #1, LOCATED IN TOWN 3 NORTH,
RANGE 16 EAST, TOWN OF SUGAR CREEK,
WALWORTH COUNTY, WISCONSIN

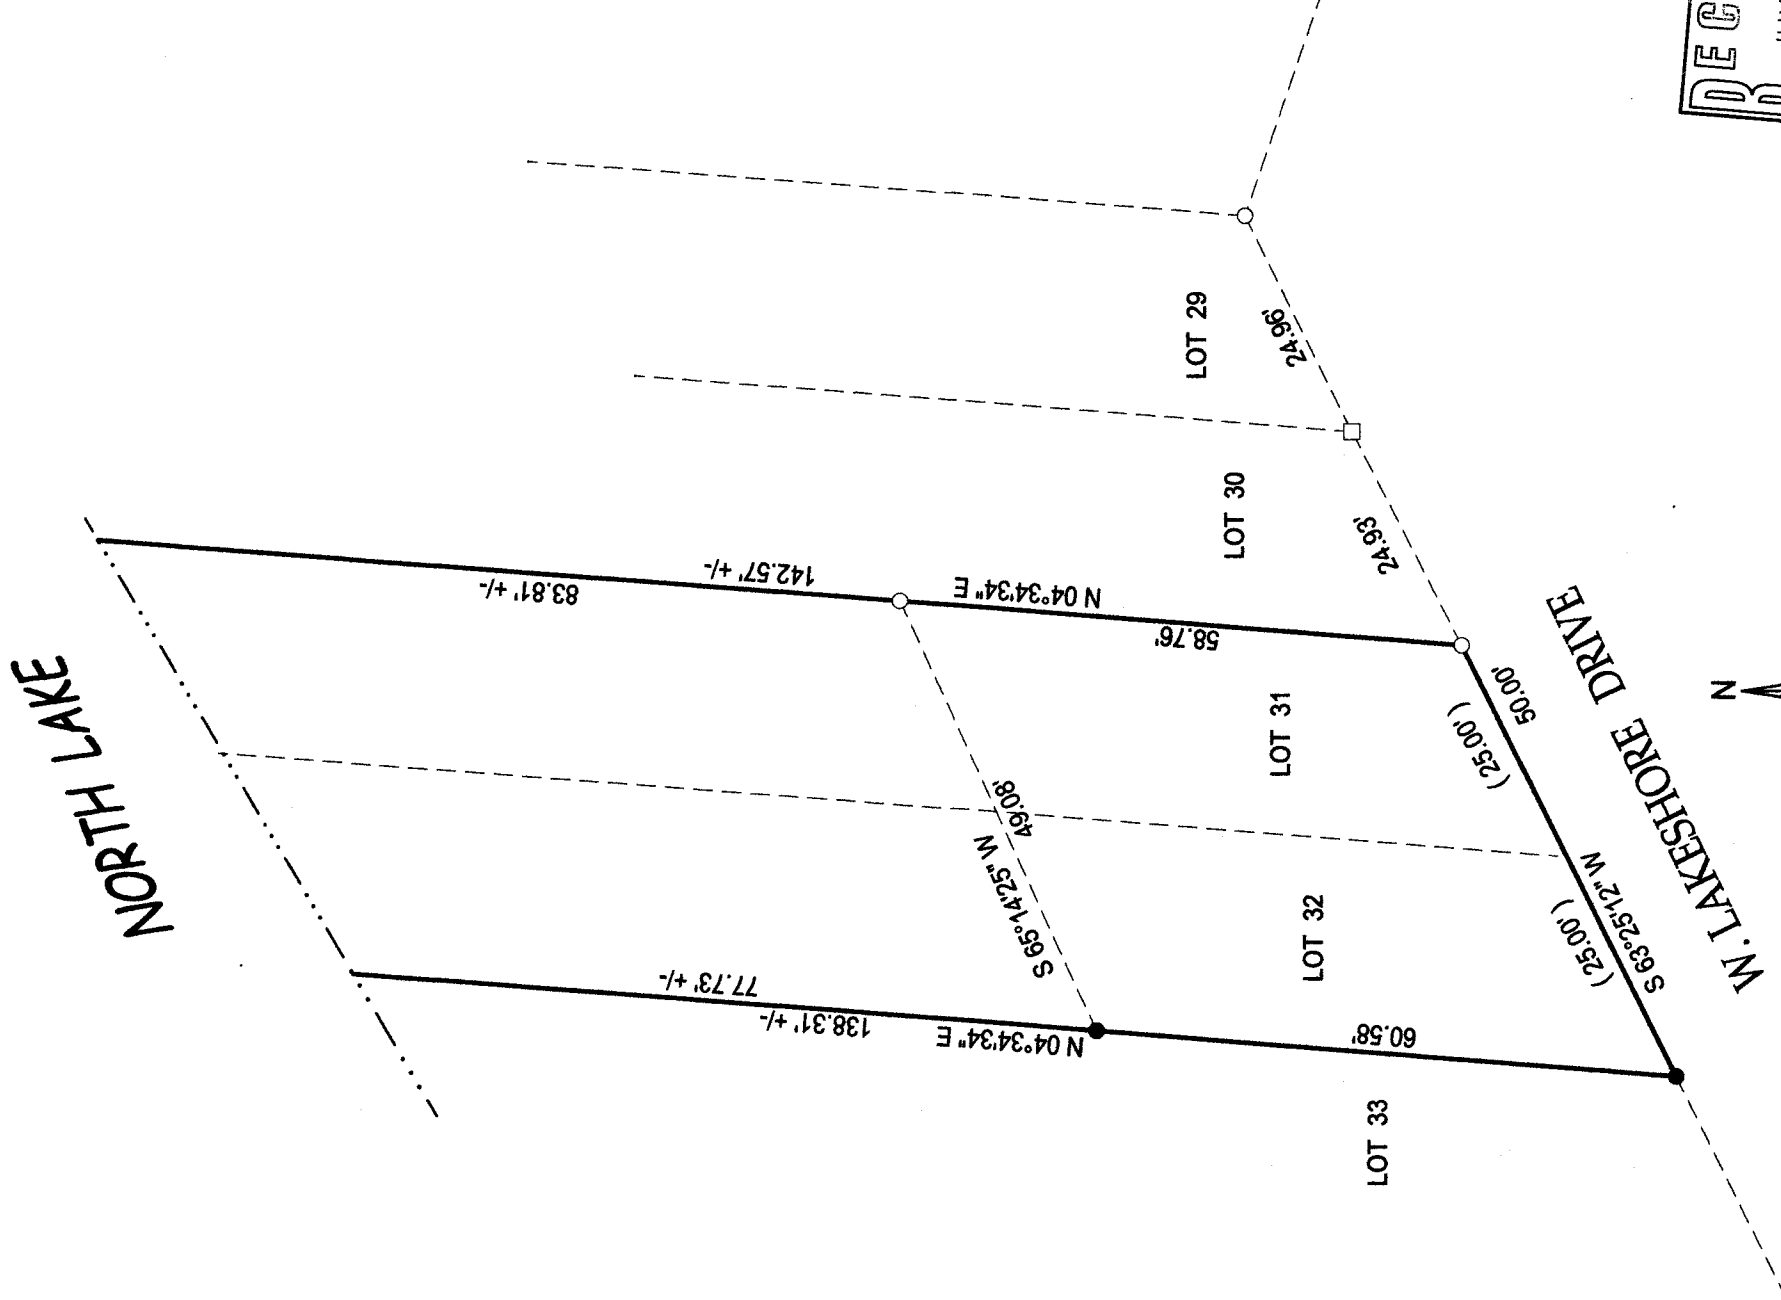



- () = recorded as
- = found iron bar
- = found iron pipe
- = set iron pipe
- = set iron bar

SCALE 1" = 20'



JOB # 13-237

TAX ID #

GNLB00019

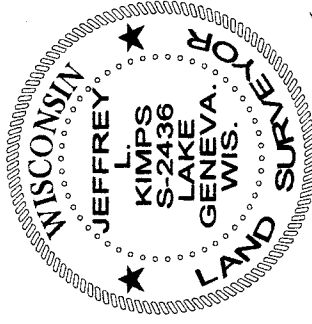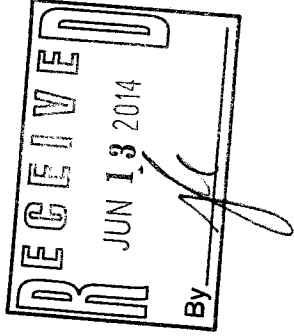

Jeffrey L. Kimps
JEFFREY L. KIMPS S - 2436
Wisconsin Registered Land Surveyor
(original if signed in red)

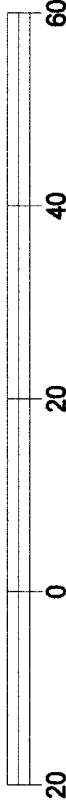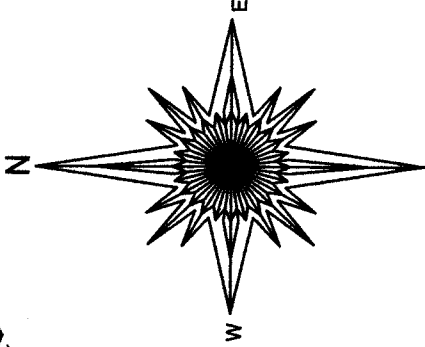

BASIS OF BEARING OF THIS PLAT: COMPASS BEARING NORTH.

"I hereby certify that I have surveyed the above described property and that the above map is a true representation of its exterior boundaries and shows the size and location of all visible structures, apparent easements and encroachments if any."

This survey is made for the present owners of the property, and those who purchase, mortgage, or guarantee the title thereto, within one year from the date hereof.

DATED THIS 21ST DAY OF NOVEMBER, 2013.

GNLB-19 316-2188