

PLAT OF SURVEY

-OF-


LOTS 19, 20 AND 21, BLOCK 40, IN THE THIRD MAP OF INTERLAKEN SUBDIVISION, TOWN OF SUGAR CREEK, WALWORTH COUNTY, WISCONSIN.

SURVEY FOR: DOROTHY McMILLAN
SURVEY ADDRESS: N6757 ARBUTUS ROAD, ELKHORN, WI 53121

NOTE: REFER TO A CURRENT TITLE REPORT FOR EASEMENTS, RESTRICTIONS OR COVENANTS WHICH MAY AFFECT THIS PROPERTY.

LEGEND

- FOUND IRON PIPE WITH A PLASTIC CAP
- ⋈ FOUND IRON PIPE
- FOUND IRON ROD
- ✦ SET IRON PIPE
- () RECORDED AS

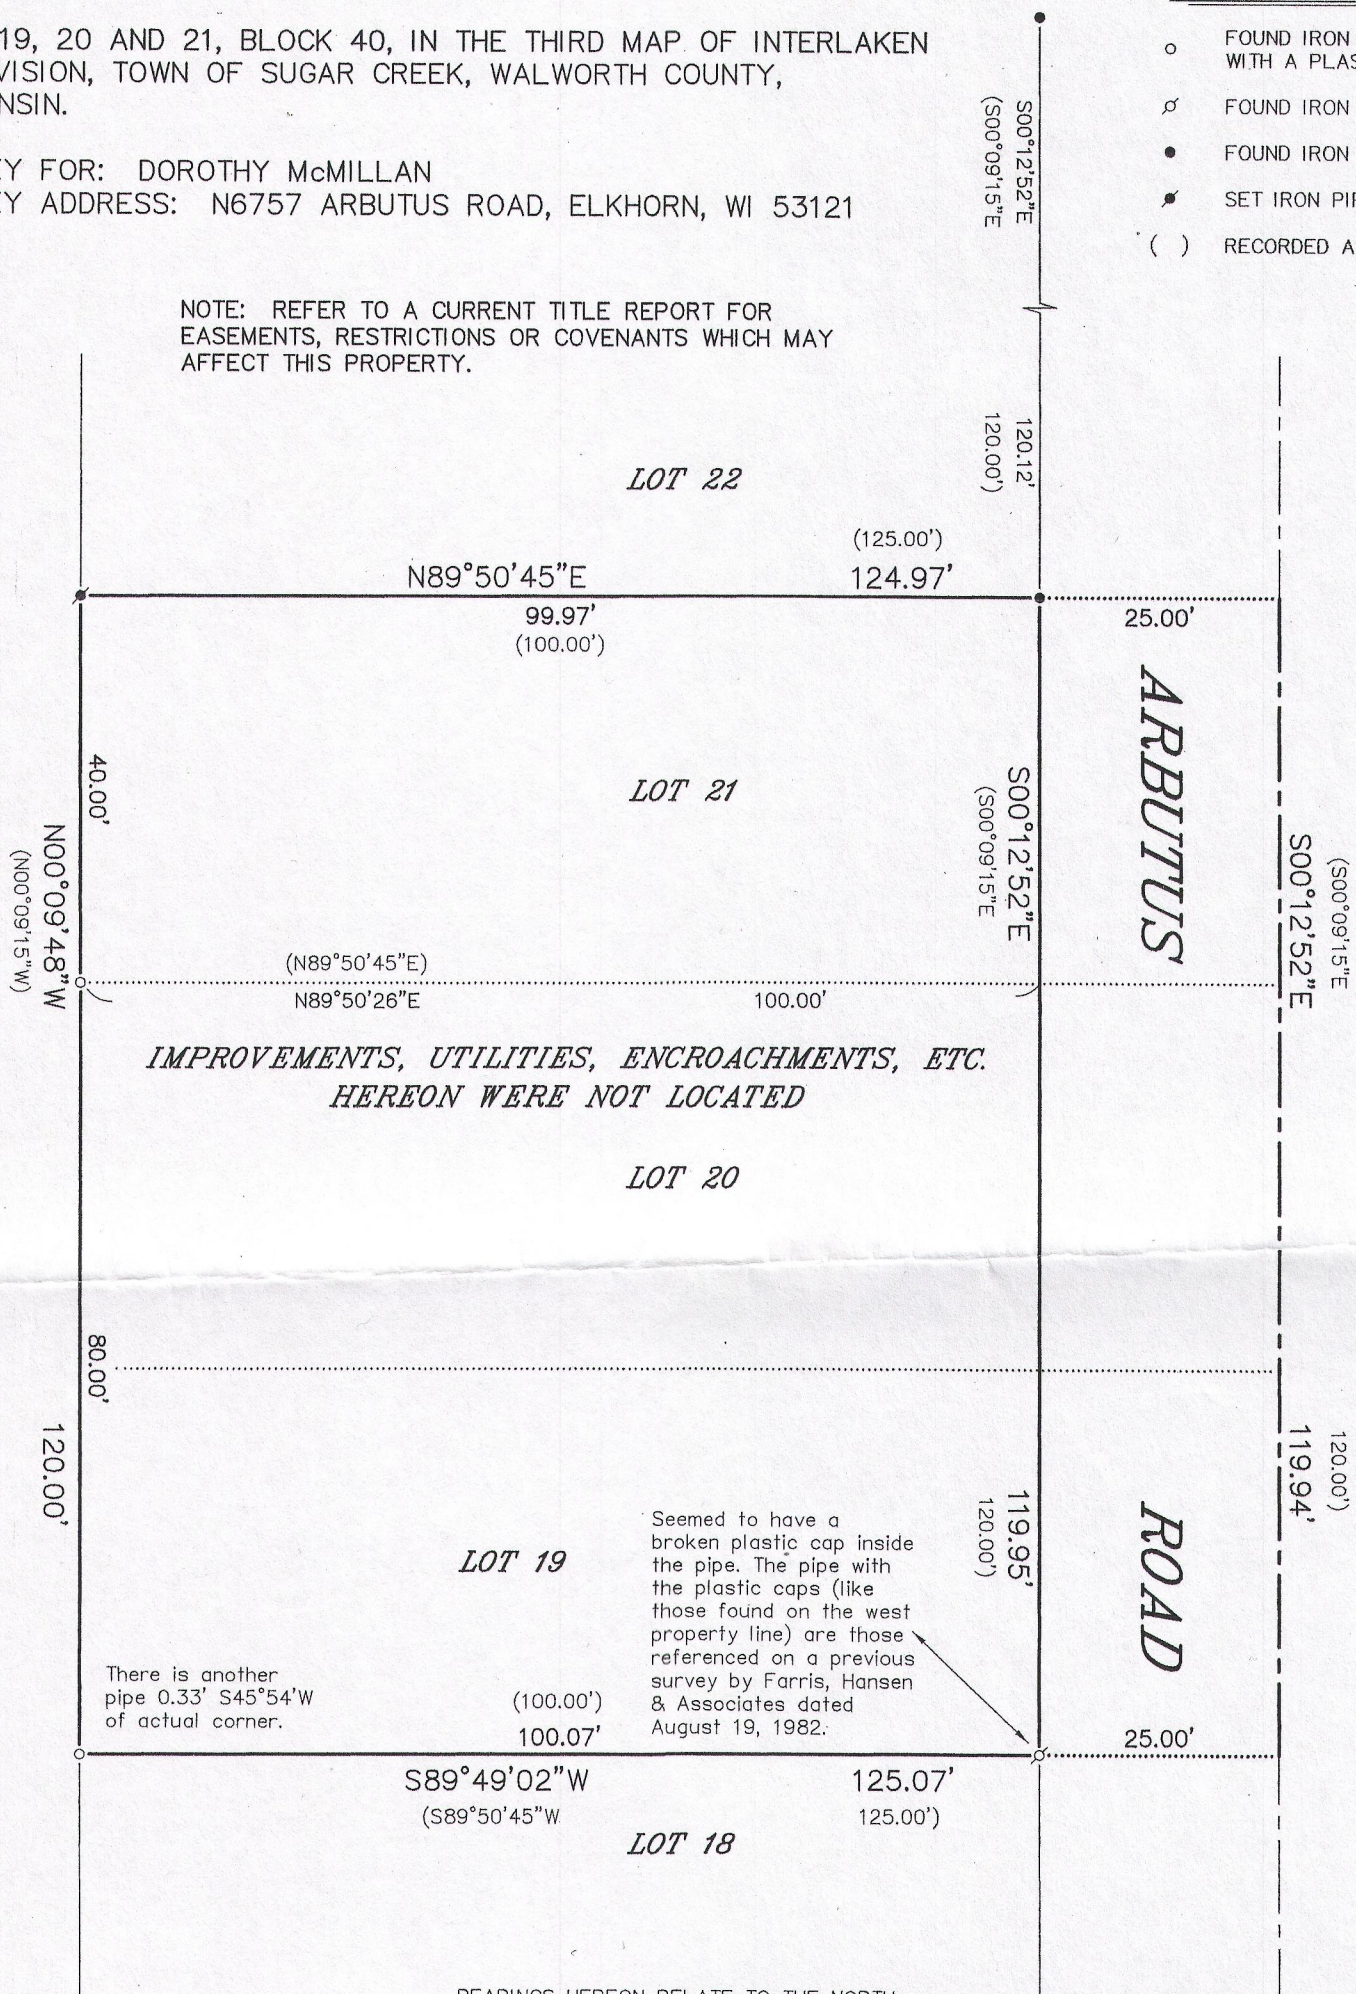




NOTE: THIS IS A SURVEY TO MARK PROPERTY LINES ONLY. NO IMPROVEMENTS, ENCROACHMENTS, UTILITIES, ETC. ARE DEPICTED HEREON PER AGREEMENT WITH THE ABOVE NAMED CLIENT.

"I HEREBY CERTIFY THAT I HAVE SURVEYED THE ABOVE DESCRIBED PROPERTY AND THAT THE ABOVE MAP IS A CORRECT REPRESENTATION THEREOF AND SHOWS THE SIZE AND LOCATION OF THE PROPERTY, ITS EXTERIOR BOUNDARIES, BOUNDARY FENCES AND ROADWAYS."

"THIS SURVEY IS MADE FOR THE USE OF THE PRESENT OWNERS OF THE PROPERTY, AND THOSE WHO PURCHASE, MORTGAGE, OR GUARANTEE THE TITLE THERETO WITHIN ONE YEAR FROM DATE HEREOF."

SATTER SURVEYING, LLC
LAND SURVEYS, MAPPING AND PLANNING
272 ORIGIN STREET
BURLINGTON, WI 53105
262-661-4239

0 10' 20' 40'
SCALE: 1" = 20'

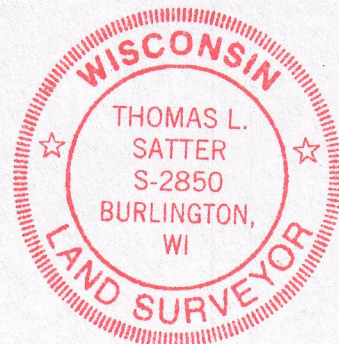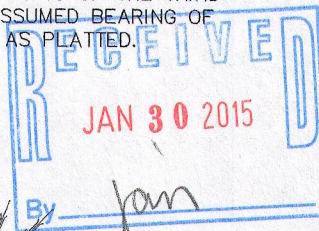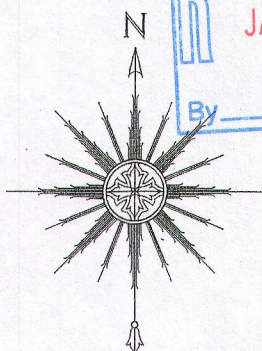

THIS IS NOT AN ORIGINAL PRINT UNLESS THIS SEAL IS RED.

Thomas L. Satter

THOMAS L. SATTER

S-2850

DECEMBER 24, 2014
DATE

121402
JOB NUMBER

GI-358

316-2204