



PLAT OF SURVEY of Lots 1, 2, and 3, Block 23, Second Map of Interlaken,
located in the SE $\frac{1}{4}$ of Section 11, T3N R16E, Walworth County, Wisconsin.

Surveyed for: C. Murray of B.E.S.P. Corp. Elkhorn, Wisconsin.

Dated: July 11, 1977

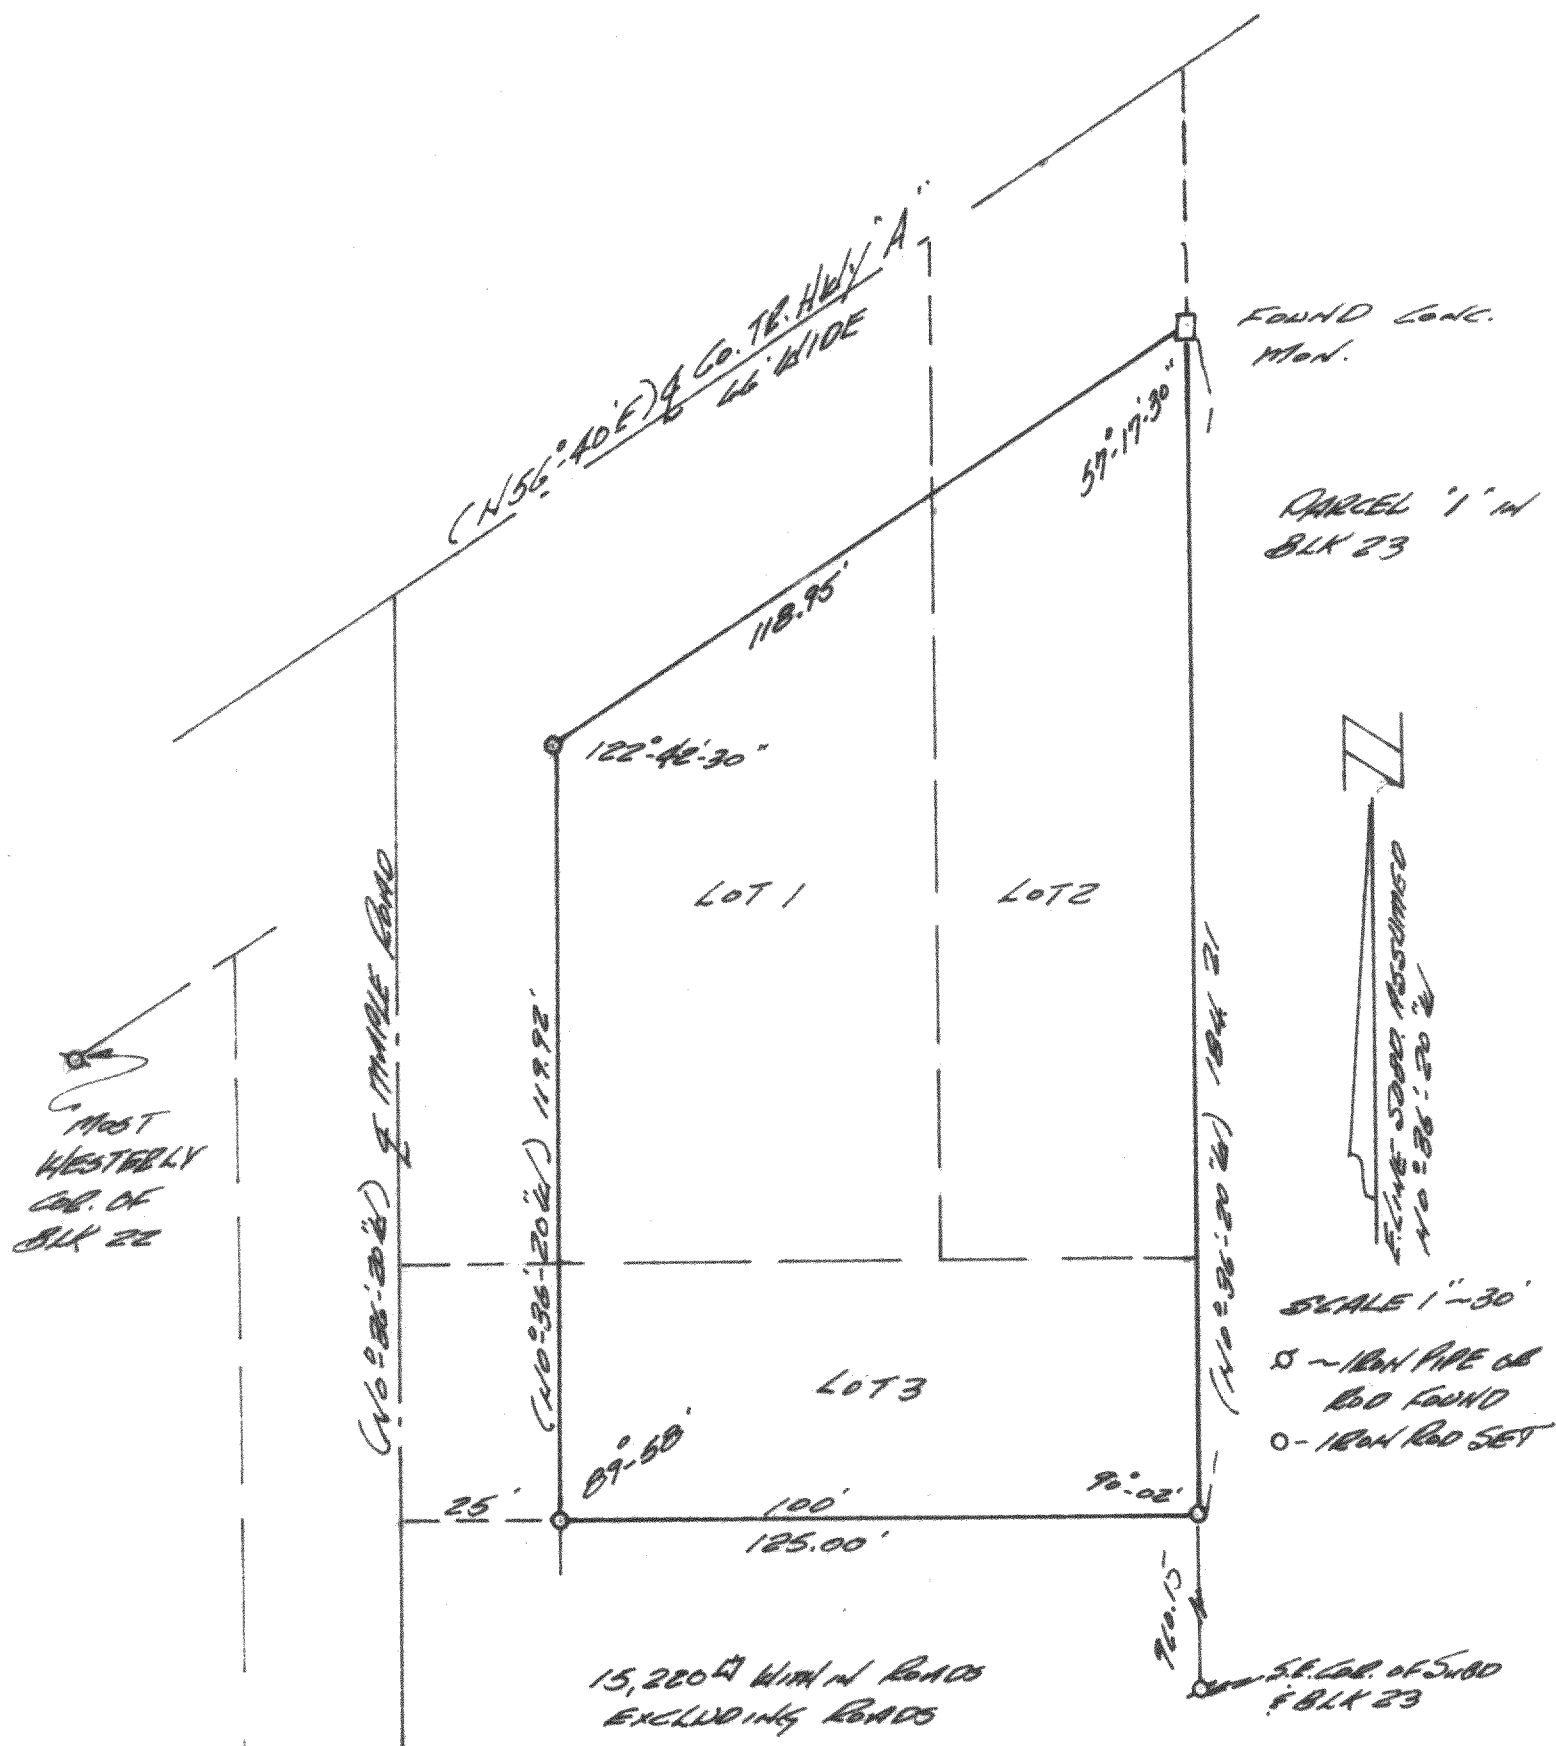

I certify that I have surveyed the above described land and that the plat shown hereon is an accurate survey and a true representation thereof and correctly shows the exterior boundary lines and all divisions of said property.

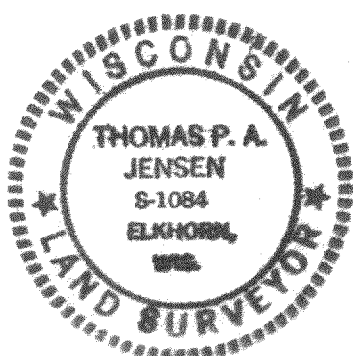

Thomas P. A. Jensen
Thomas P. A. Jensen
Elkhorn, Wisconsin

61-259c

316-224