


PREPARED FOR
CHRISTINE FOX
SHOREWEST REALTY
830 E GENEVA ST
DELAVAN, WI 53115

PLAT OF SURVEY

- OF -

LOTS 24 AND 25, BLOCK 4 LAKE WANDAWEGA HIGHLANDS, A SUBDIVISION LOCATED
IN SECTIONS 11 AND 12, TOWN 3 NORTH, RANGE 16 EAST OF THE FOURTH PRINCIPAL
MERIDIAN, TOWN OF SUGAR CREEK, COUNTY OF WALWORTH AND STATE OF
WISCONSIN.

PATHFINDER SURVEYING INC.
(formerly)
J.K. SURVEYING INC.
W2888 KRUEGER RD. STE. "D"
262-248-8303

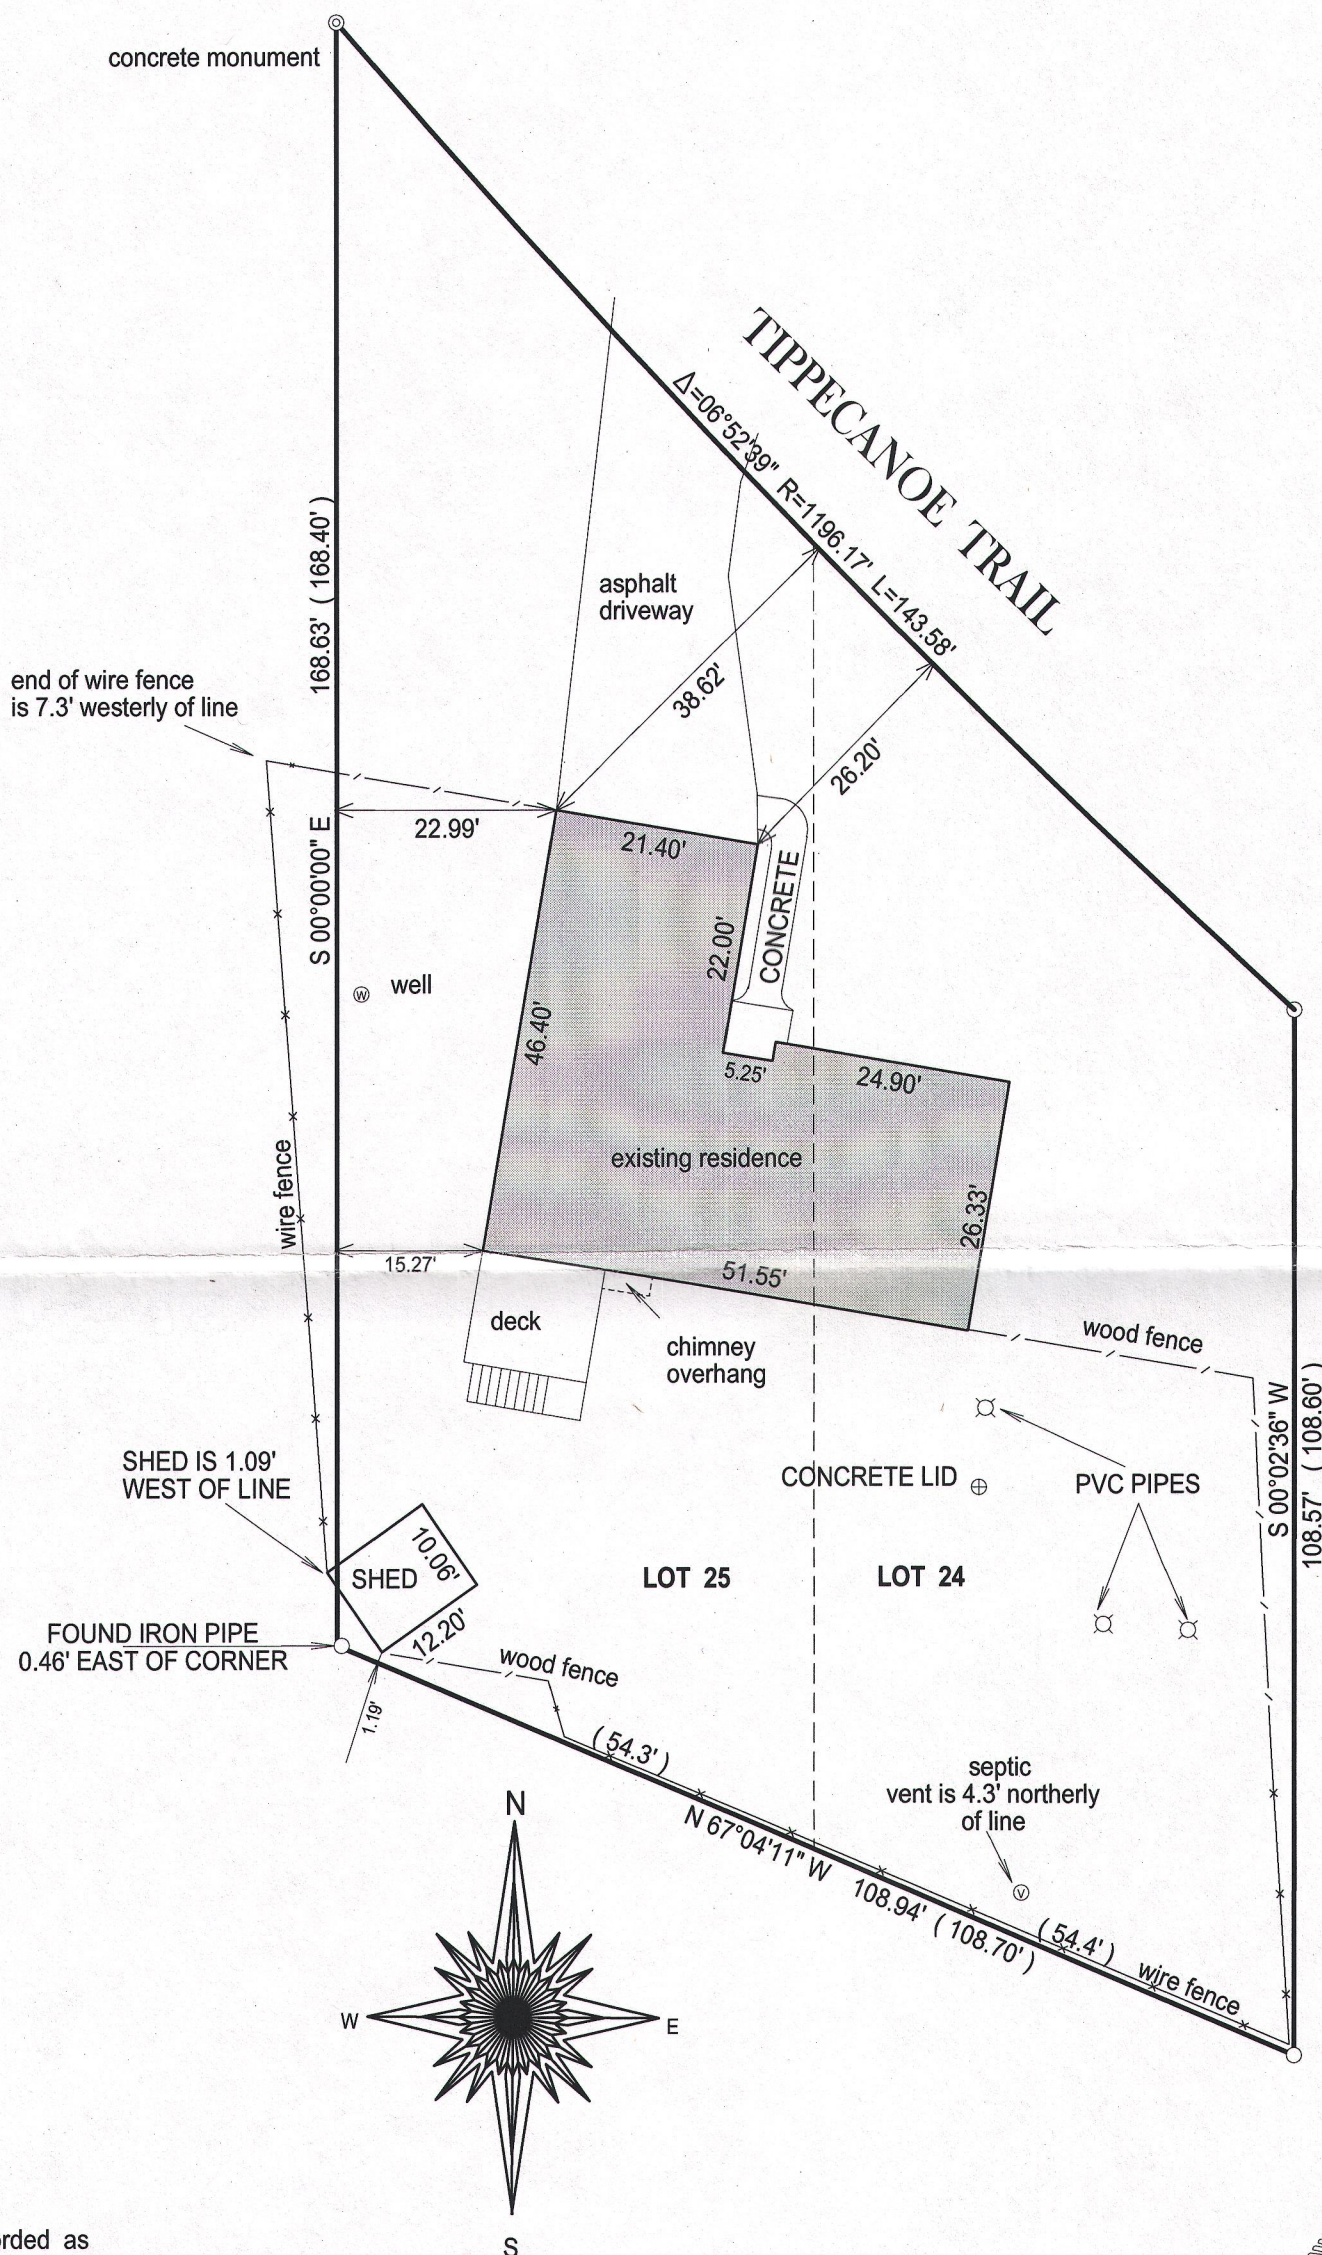

- () = recorded as
- = found iron bar
- = found iron pipe
- = set iron pipe
- = set iron bar

SCALE 1" = 20'

JOB # 09-078ud

TAX ID #

GWH 00059

20 0 20 40


BASIS OF BEARING OF THIS PLAT: THE WEST LINE
OF LOT 25 WAS ASSUMED TO BEAR NORTH.

COMPARE LEGAL DESCRIPTION ABOVE AND DRAWING WITH DEED. FOR BUILDING RESTRICTIONS AND
EASEMENTS NOT SHOWN, REFER TO DEED, ABSTRACT SOURCES AND LOCAL MUNICIPAL CODES. NOTIFY
THE SURVEYOR IMMEDIATELY OF ANY DISCREPANCY.

"I hereby certify that I have surveyed the above described property and that
the above map is a true representation thereof and shows the size and
location of all visible structures, apparent easements and encroachments
if any."

This survey is made for the present owners of the property, and those who
purchase, mortgage, or guarantee the title thereto, within one year from
the date hereof.

DATED THIS 31st day of October, 2015.

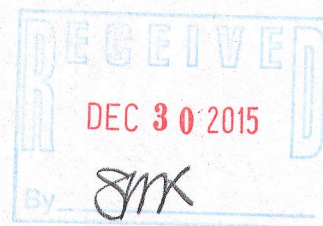

JEFFREY L. KIMPS S - 2436
Wisconsin Registered Land Surveyor
(original if signed in red)