

PREPARED FOR
DAVID & REBEECCA WOODS
W5673 BABCOCK RD
ELKHORN, WI 53121


PLAT OF SURVEY

- OF -

LOTS 11, 12, 19 AND 20, BLOCK 74 OF THE FIFTH MAP OF
INTERLAKEN, LOCATED IN THE NW 1/4 OF SECTION 14,
TOWN 3 NORTH, RANGE 16 EAST, TOWN OF SUGAR
CREEK, COUNTY OF WALWORTH AND STATE OF WISCONSIN.

PATHFINDER SURVEYING INC.
(formerly)
J.K. SURVEYING INC.
P.O BOX 322
LAKE GENEVA, WI. 53147
WWW.PATHFINDERSURVEYING.NET
262-248-8303

BABCOCK ROAD

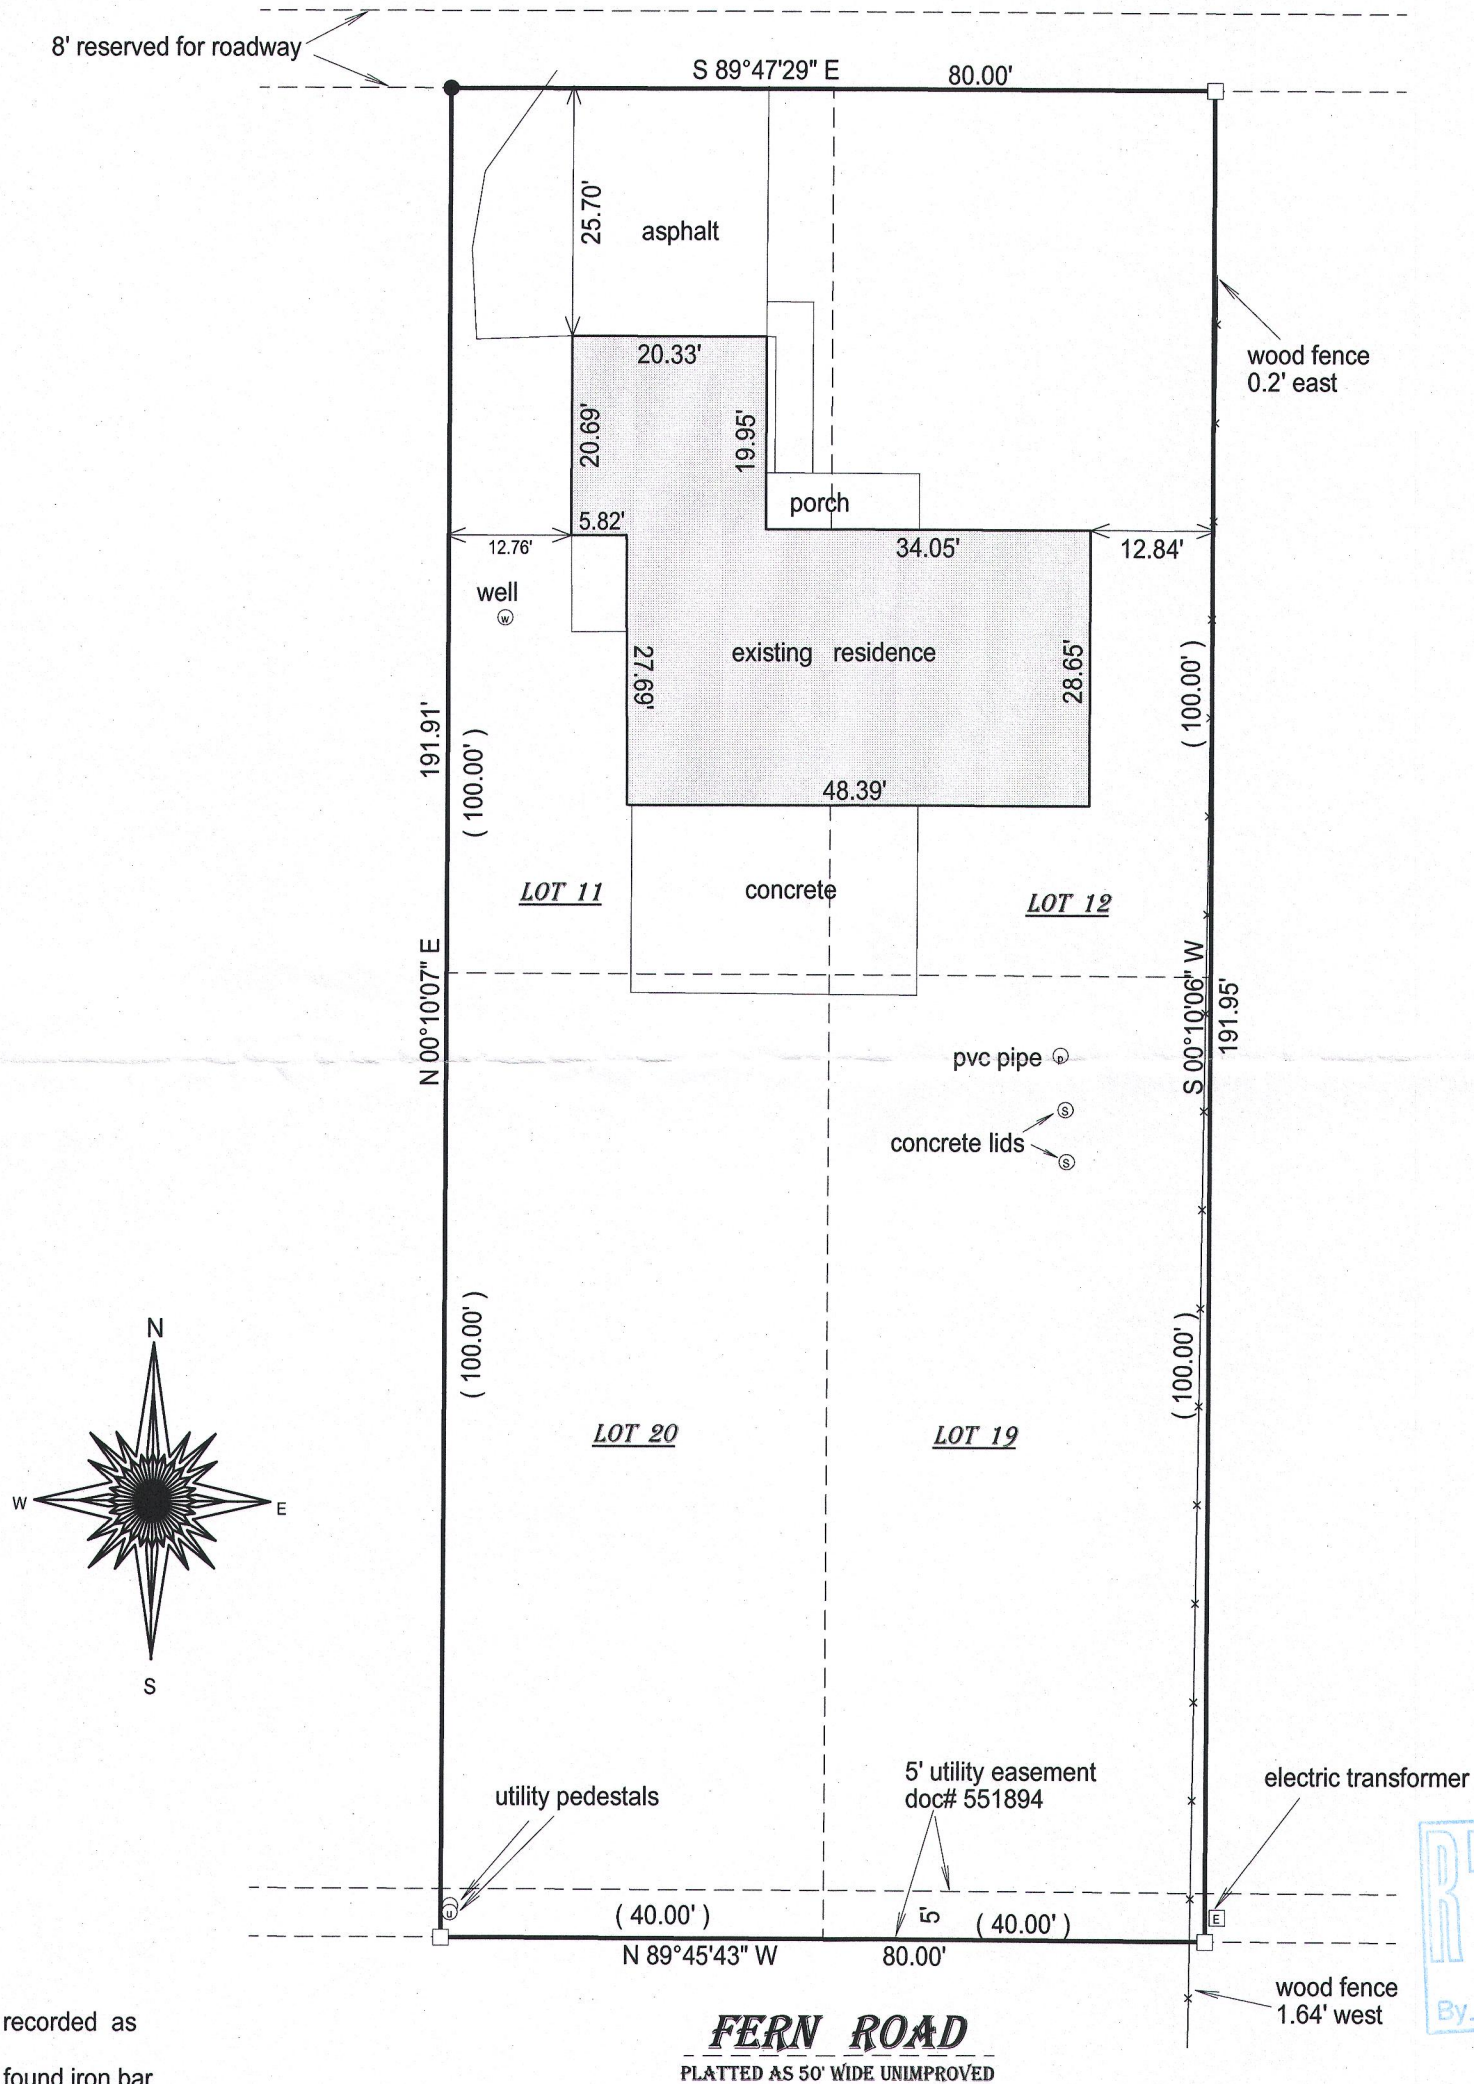


- () = recorded as
□ = found iron bar
○ = found iron pipe
● = set iron pipe
■ = set iron bar

SCALE 1" = 20'

JOB # 16-138

TAX ID # GI 00656

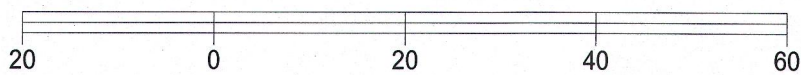


BASIS OF BEARING OF THIS PLAT: THE SOUTH LINE OF BABCOCK
WAS ASSUMED TO BEAR S 89d47'29" E AS SHOWN ON PREVIOUS
SURVEYS OF RECORD.

I hereby certify that I have surveyed the above- described property and the
above map is a true representation thereof and shows the size and
location of the property, its exterior boundaries, the location and
dimensions of all structures thereon, fences, apparant easements and
roadways and visible encroachments if any.

This survey is made for the present owners of the property, and those who
purchase, mortgage, or guarantee the title thereto, within one year from
the date hereof.

DATED THIS 19TH DAY OF MAY, 2016.

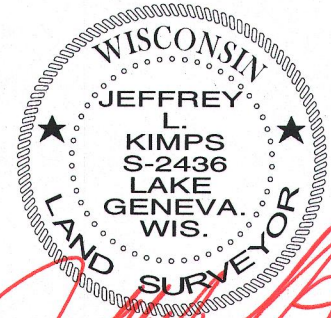

JEFFREY L. KIMPS S - 2436
Wisconsin Professional Land Surveyor
(original if signed in red)