


PLAT OF SURVEY of Lots 12, 13, 14, and 15 of Block 23, Second Map of Interlaken, located in the SE $\frac{1}{4}$ of Section 11, T3N R16E, Walworth County, Wisconsin.

Surveyed for: C. Murray of B.E.S.P. Corp. Elkhorn, Wisconsin
Dated: July 11, 1977

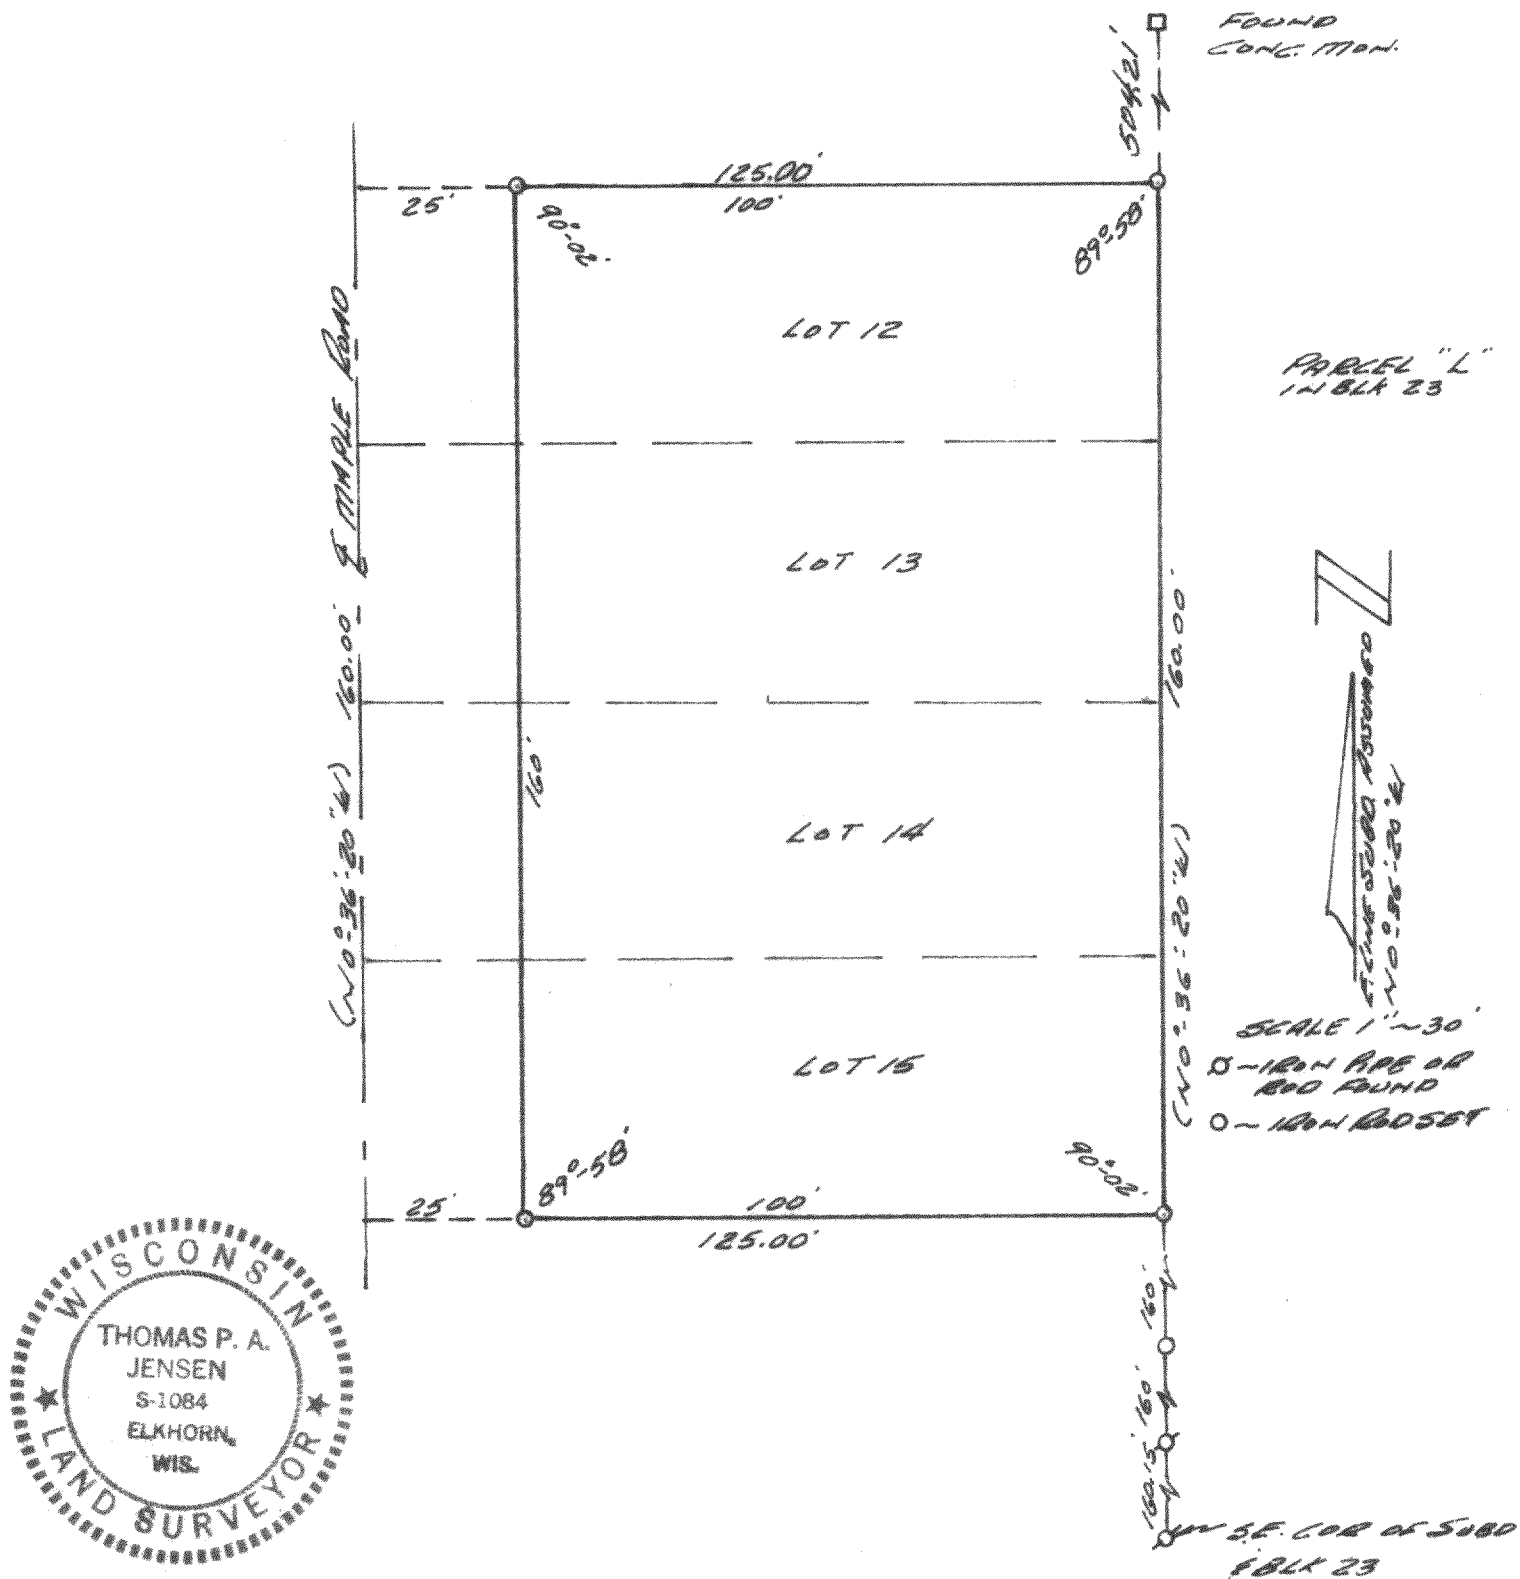

I certify that I have surveyed the above described land and that the plat shown hereon is an accurate survey and a true representation thereof and correctly shows the exterior boundary lines and all divisions of said property.

Thomas P. A. Jensen
Thomas P. A. Jensen
Elkhorn, Wisconsin