



PLAT OF SURVEY of lots 16, 17, 18, and 19 of Block 23, Second Map of Interlaken, located in the SE $\frac{1}{4}$ of Section 11, T3N R16E, Walworth County, Wisconsin.

Surveyed For: C. Murray of B.E.S.P. Corp. Elkhorn, Wis.
Dated: July 11, 1977

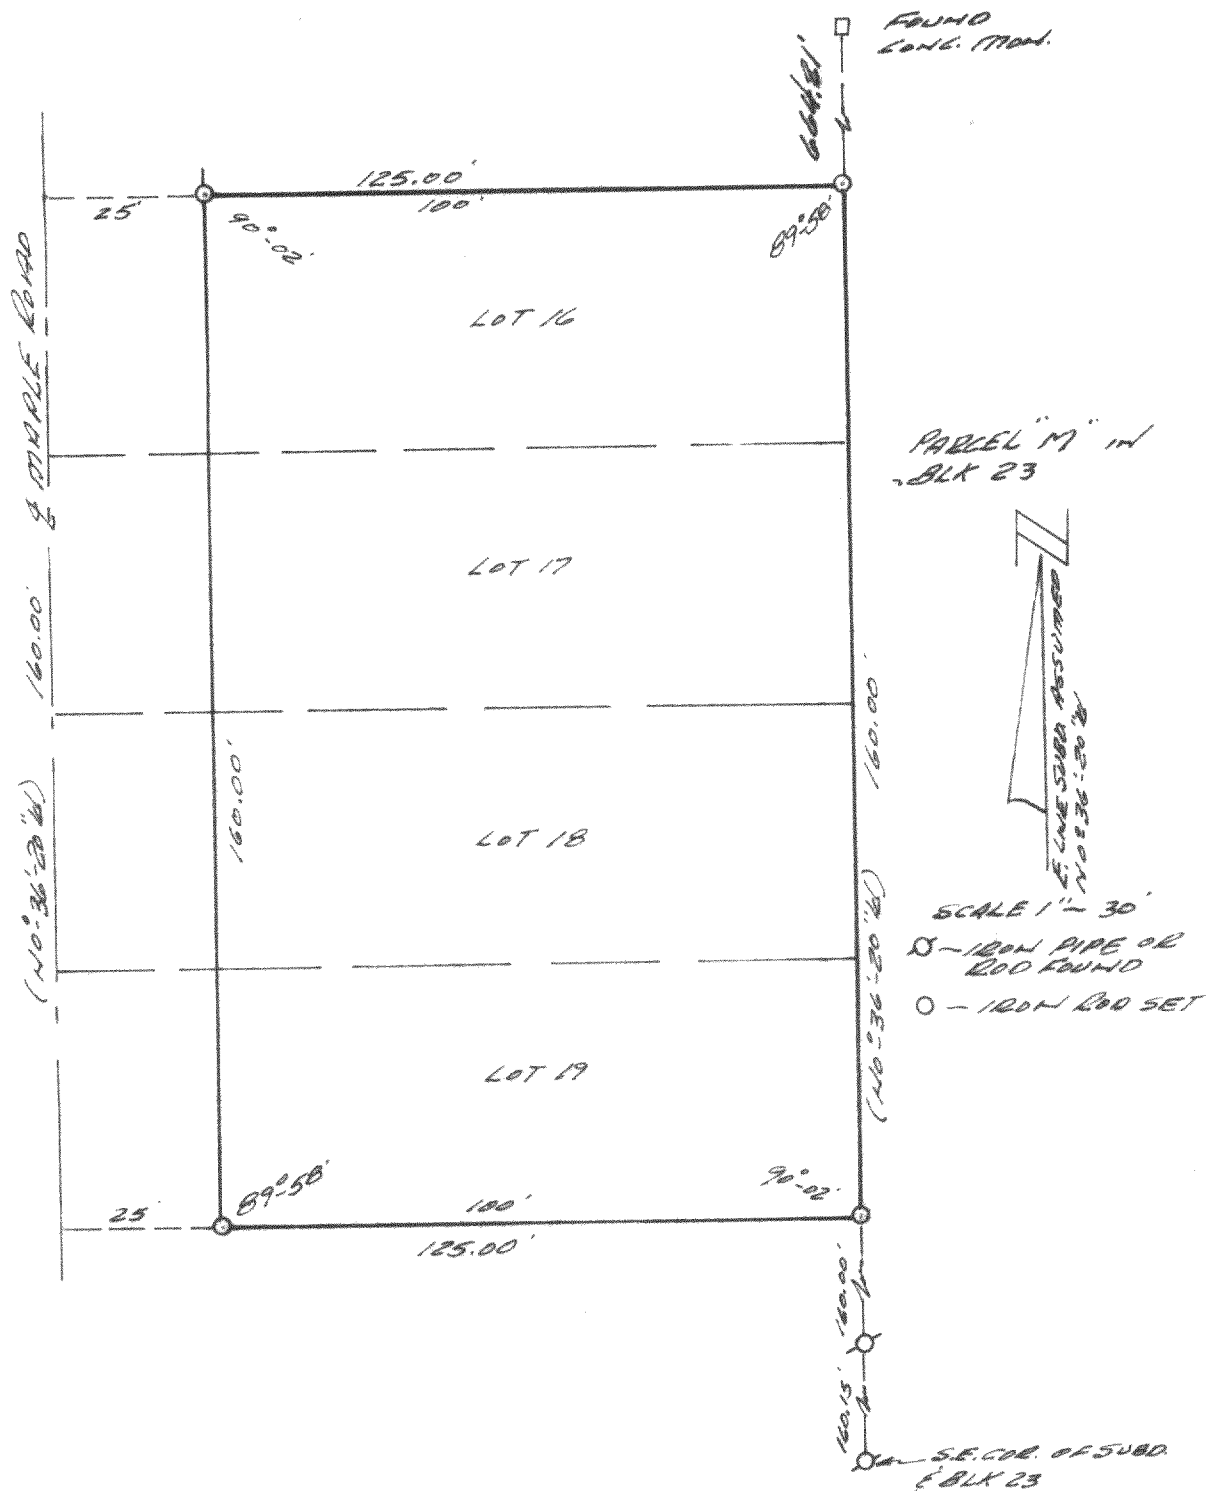

I certify that I have surveyed the above described land & that the plat shown hereon is an accurate survey & a true representation thereof & correctly shows the exterior boundary lines & all divisions of said property.

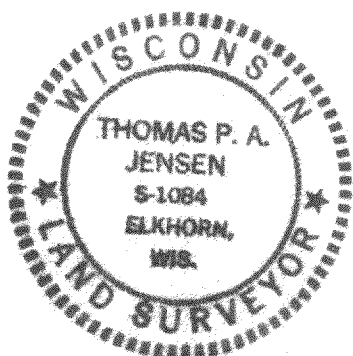

Thomas P. A. Jensen
Thomas P. A. Jensen
Elkhorn, Wisconsin

316-228

61-260B