

Tax Parcel
GNLB2 00292A

North Lake Drive

Width Varies

Location of buried telephone line as indicated
by diggers hotline flagging.

12" Culvert

Location of buried electric line as indicated
by diggers hotline flagging.

Lot 13
Lot 14
(100')
S88°37'11"E 100.05'

Lot 15

Lot 16

Lot 17

Lot 18
Poured Concrete
Foundation
N6836

Lot 19

S88°37'11"E 100.05'
(100')

Lot 20

Lot 21

Lot 22

Lot 23

(100')
100.06'

Lot 36

Lot 37

Lot 38

Lot 39

Lot 40

Lot 41

Lot 42

Lot 43

Lot 44

Lot 45

Lot 46

(100')
100.06'

Block

N88°37'11"W 200.10'

Corner falls
in tree.

Shed

Tax Parcel
GNLB2 00246

0.402 Acre
17,504 Sq.Ft.

N0°03'58"E
25.00'
(25')

S0°03'58"W
104.60'

N88°37'11"W 200.12'

Geneva Road

(33' Wide)

Grassy Path

Chesapeake Drive

(30' Wide)

Unimproved


Plat of Survey

of


**Lots 17, 18 and 19 and Lots 40, 41, 42 and 43
of Block R of North Lake Beach, Tract No. 2,**

a subdivision located in the Northwest 1/4 of Section 8, Town 3 North,
Range 16 East, Town of Sugar Creek, Walworth County, Wisconsin.

Surveyed for: **Stephen Harrison**
N6836 North Lake Drive
Elkhorn, Wisconsin. 53121

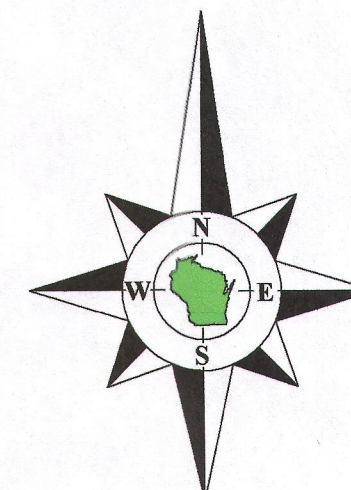

Bearings reference to previous
surveys of record.

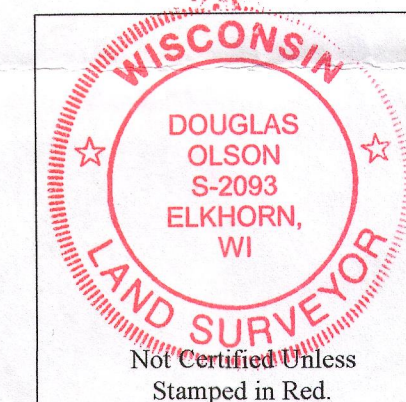

Notes:

- 1) This survey plat is not certified unless signed and sealed in red ink.
- 2) This survey is subject to Wisconsin lien laws. This Plat of Survey is the notice of intent to file lien. Lien waiver required.

Copyright 2007 by Jensen & Olson Land Surveying, LLC.

All rights reserved. No part of this survey plat may be reproduced or transmitted in any form by any means - graphic, electronic, or mechanical, including photocopying, tracing, or information storage and retrieval systems - without permission in writing from Douglas G. Olson, Jensen & Olson Land Surveying, LLC.

I, Douglas G. Olson, Wisconsin Professional Land Surveyor, do hereby certify that this survey was performed by me, or under my direction in full compliance with the owner's/agent's instructions and Chapter A-E 7 of the Wisconsin Administrative Code "Minimum Standards for Property Surveys", and that this map is an accurate representation thereof to the best of my knowledge and belief.

Douglas G. Olson
Wisconsin Professional Land Surveyor - 2093

GNLB2-246 316-2287

Survey Date: November 13, 2007.
Revisions: No. 1 - Proposed House
No. 2 - Proposed Shed
No. 3 - Shed location
No. 4 - Shed dimensions
No. 5 - Dimensions

Scale in Feet
1" = 20'
0' 10' 20' 40'

Olson Land Surveying, LLC
45 South Wisconsin Street * P.O. Box 322 * Elkhorn, Wisconsin. 53121
Telephone: (262) 723-3434 * Facsimile: (262) 723-8044
Email: doug@olsonsurveying.com

Legend
● Found Iron Rod, 3/4" dia.
○ Recorded Information
○ Concrete Cover
○ Septic Vent
○ Utility Box or Pedestal
○ Diggers Hotline Flag
○ Asphalt Surface
○ Concrete

Sheet 1 of 1 Sheets
Drawing Name
Job Reference Number
2016.082
2016.082