

Tax Parcel
GNLB2 00292A

North Lake Drive

Width Varies

Location of buried telephone line as indicated by diggers hotline flagging.

12" Culvert

Location of buried electric line as indicated by diggers hotline flagging.

Geneva Road

(33' Wide)

Grassy Path

Lot 13

Lot 36

Lot 14

Lot 37

(100')
S88°37'11"E 100.05'

Lot 15

Lot 38

Lot 16

Lot 39

N88°37'11"W 200.10'

Corner falls in tree.

Lot 17

Lot 40

Approx. location of Septic Field

Lot 18
Poured Concrete Foundation
N6836

Tax Parcel
GNLB2 00246

Shed

Lot 41

Lot 19

Lot 42

S88°37'11"E 100.05'
(100')

N0°03'58"E
25.00'
(25')

Lot 43

Lot 20

Lot 44

N88°37'11"W 100.05'
(100')

Lot 21

Lot 45

S0°03'58"W 104.80'
(25')

Lot 22

Lot 46

Lot 23

Lot 46

(100')
100.06'

(100')
100.06'

N88°37'11"W 200.12'

S0°03'53"W 100.00'

Chesapeake Drive

(30' Wide)

Unimproved


Plat of Survey

of


Lots 17, 18 and 19 and Lots 40, 41, 42 and 43 of Block R of North Lake Beach, Tract No. 2,

a subdivision located in the Northwest 1/4 of Section 8, Town 3 North,
Range 16 East, Town of Sugar Creek, Walworth County, Wisconsin.

Surveyed for: **Stephen Harrison**
N6836 North Lake Drive
Elkhorn, Wisconsin. 53121

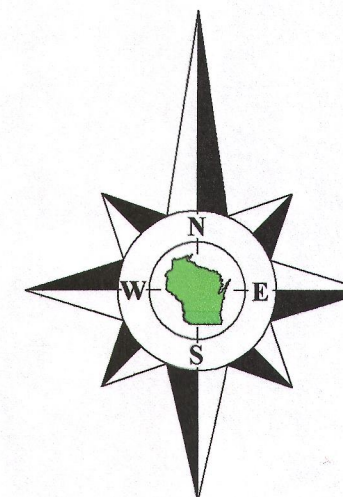

Bearings reference to previous
surveys of record.

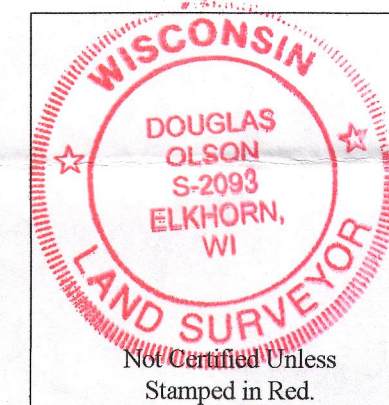

Notes:


- 1) This survey plat is not certified unless signed and sealed in red ink.
- 2) This survey is subject to Wisconsin lien laws. This Plat of Survey is the notice of intent to file lien. Lien waiver required.

Copyright 2007 by Jensen & Olson Land Surveying, LLC.

All rights reserved. No part of this survey plat may be reproduced or transmitted in any form by any means - graphic, electronic, or mechanical, including photocopying, tracing, or information storage and retrieval systems - without permission in writing from Douglas G. Olson, Jensen & Olson Land Surveying, LLC.

I, Douglas G. Olson, Wisconsin Professional Land Surveyor, do hereby certify that this survey was performed by me, or under my direction in full compliance with the owner's/agent's instructions and Chapter A-E 7 of the Wisconsin Administrative Code "Minimum Standards for Property Surveys", and that this map is an accurate representation thereof to the best of my knowledge and belief.

Douglas G. Olson
Wisconsin Professional Land Surveyor - 2093

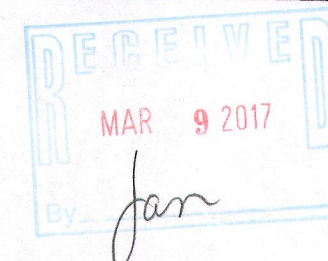

Survey Date: November 13, 2007.
Revisions:
No. 1 - Proposed House
No. 2 - Foundation
No. 3 - Proposed Shed
No. 4 - Shed location
No. 5 - Dimensions
No. 6 - Dimensions

Scale in Feet
1" = 20'
0 10' 20' 40'

Olson Land Surveying, LLC



45 South Wisconsin Street * P.O. Box 322 * Elkhorn, Wisconsin. 53121
Telephone: (262) 723-3434 * Facsimile: (262) 723-8044
Email: doug@olsonsurveying.com

Legend

- Found Iron Rod, 3/4" dia.
- Recorded Spindle
- Recorded Information
- Concrete Cover
- Septic Vent
- Utility Box or Pedestal
- Diggers Hotline Flag
- Asphalt Surface
- Concrete

Sheet 1 of 1 Sheets

Job Reference Number

2016.082

2016.082

GNLB2-246 316-2288